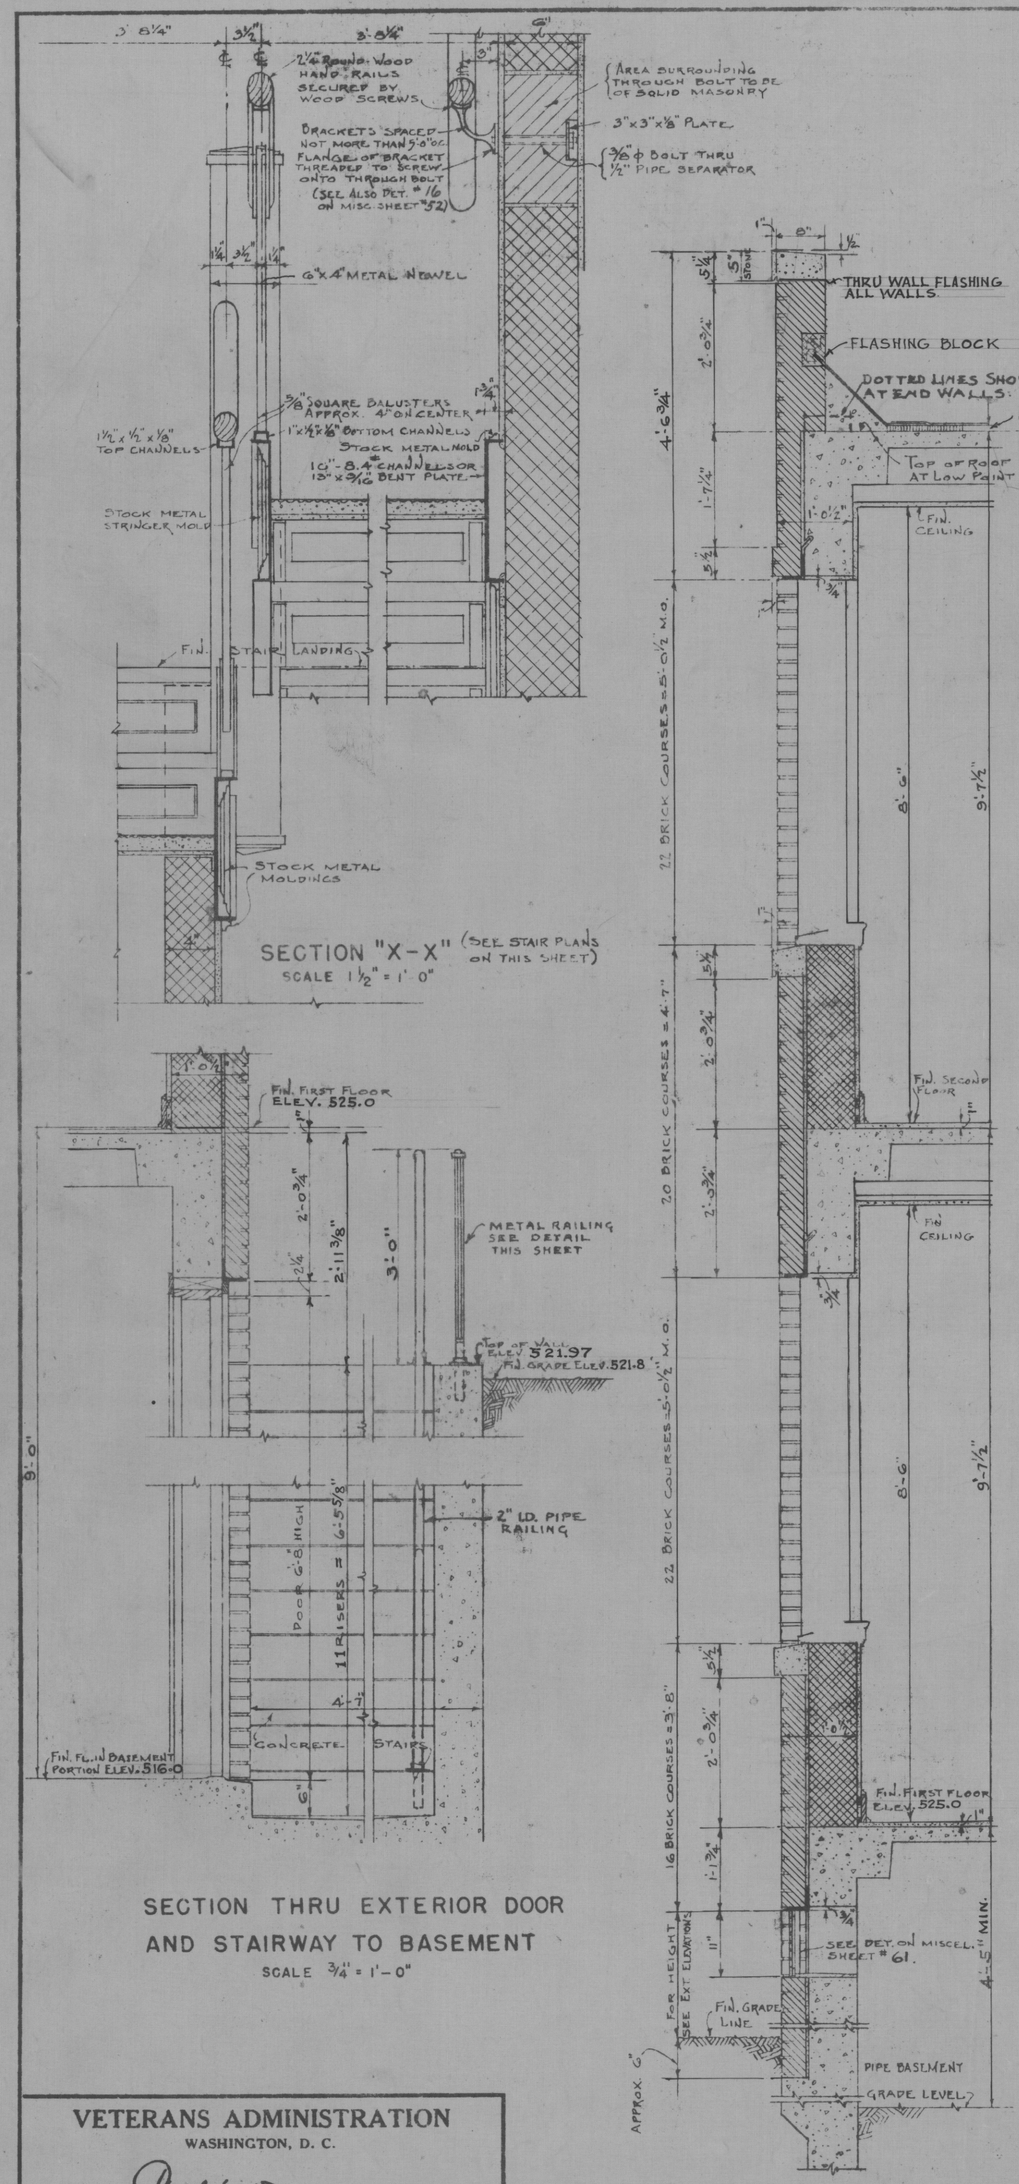

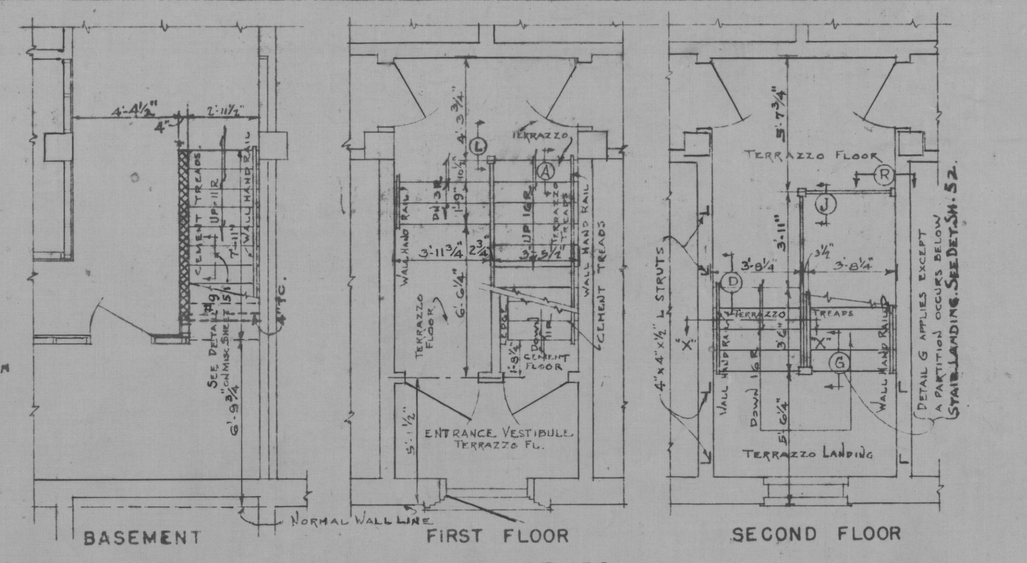

PLAN OF STAIRS

NOTE: SEE MISC. DETAIL SHEET FOR ALL STAIR SECTIONS SHOWN ABOVE EXCEPT AS OTHERWISE NOTED (SEE SECTION X-X THIS SHEET)

SCALE ¼" = 1'-0"

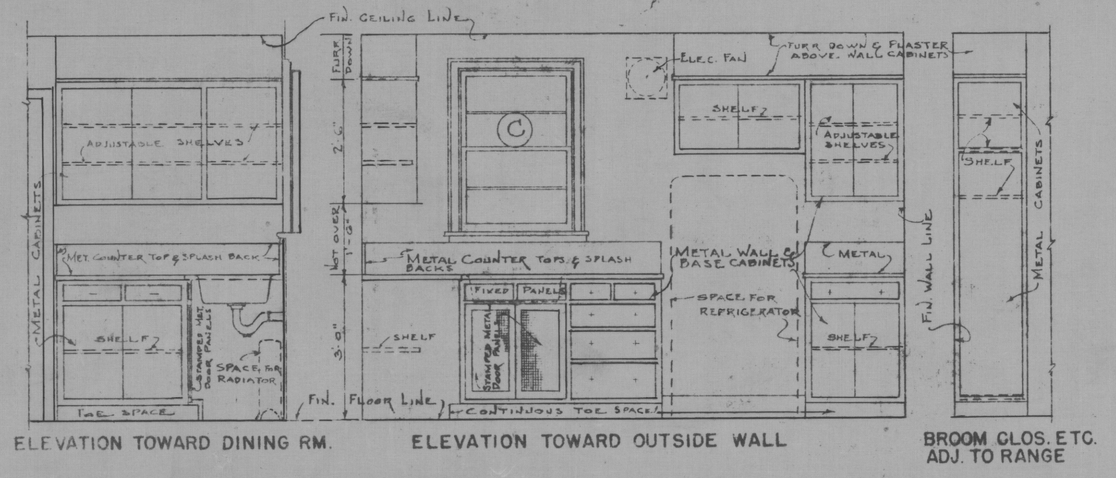

DETAILS OF KITCHEN CABINETS FOR APARTMENTS "A" AND "C"

CABINETS FOR APARTMENTS "B" AND "D" SIMILAR BUT REVERSED

SCALE ½" = 1'-0"

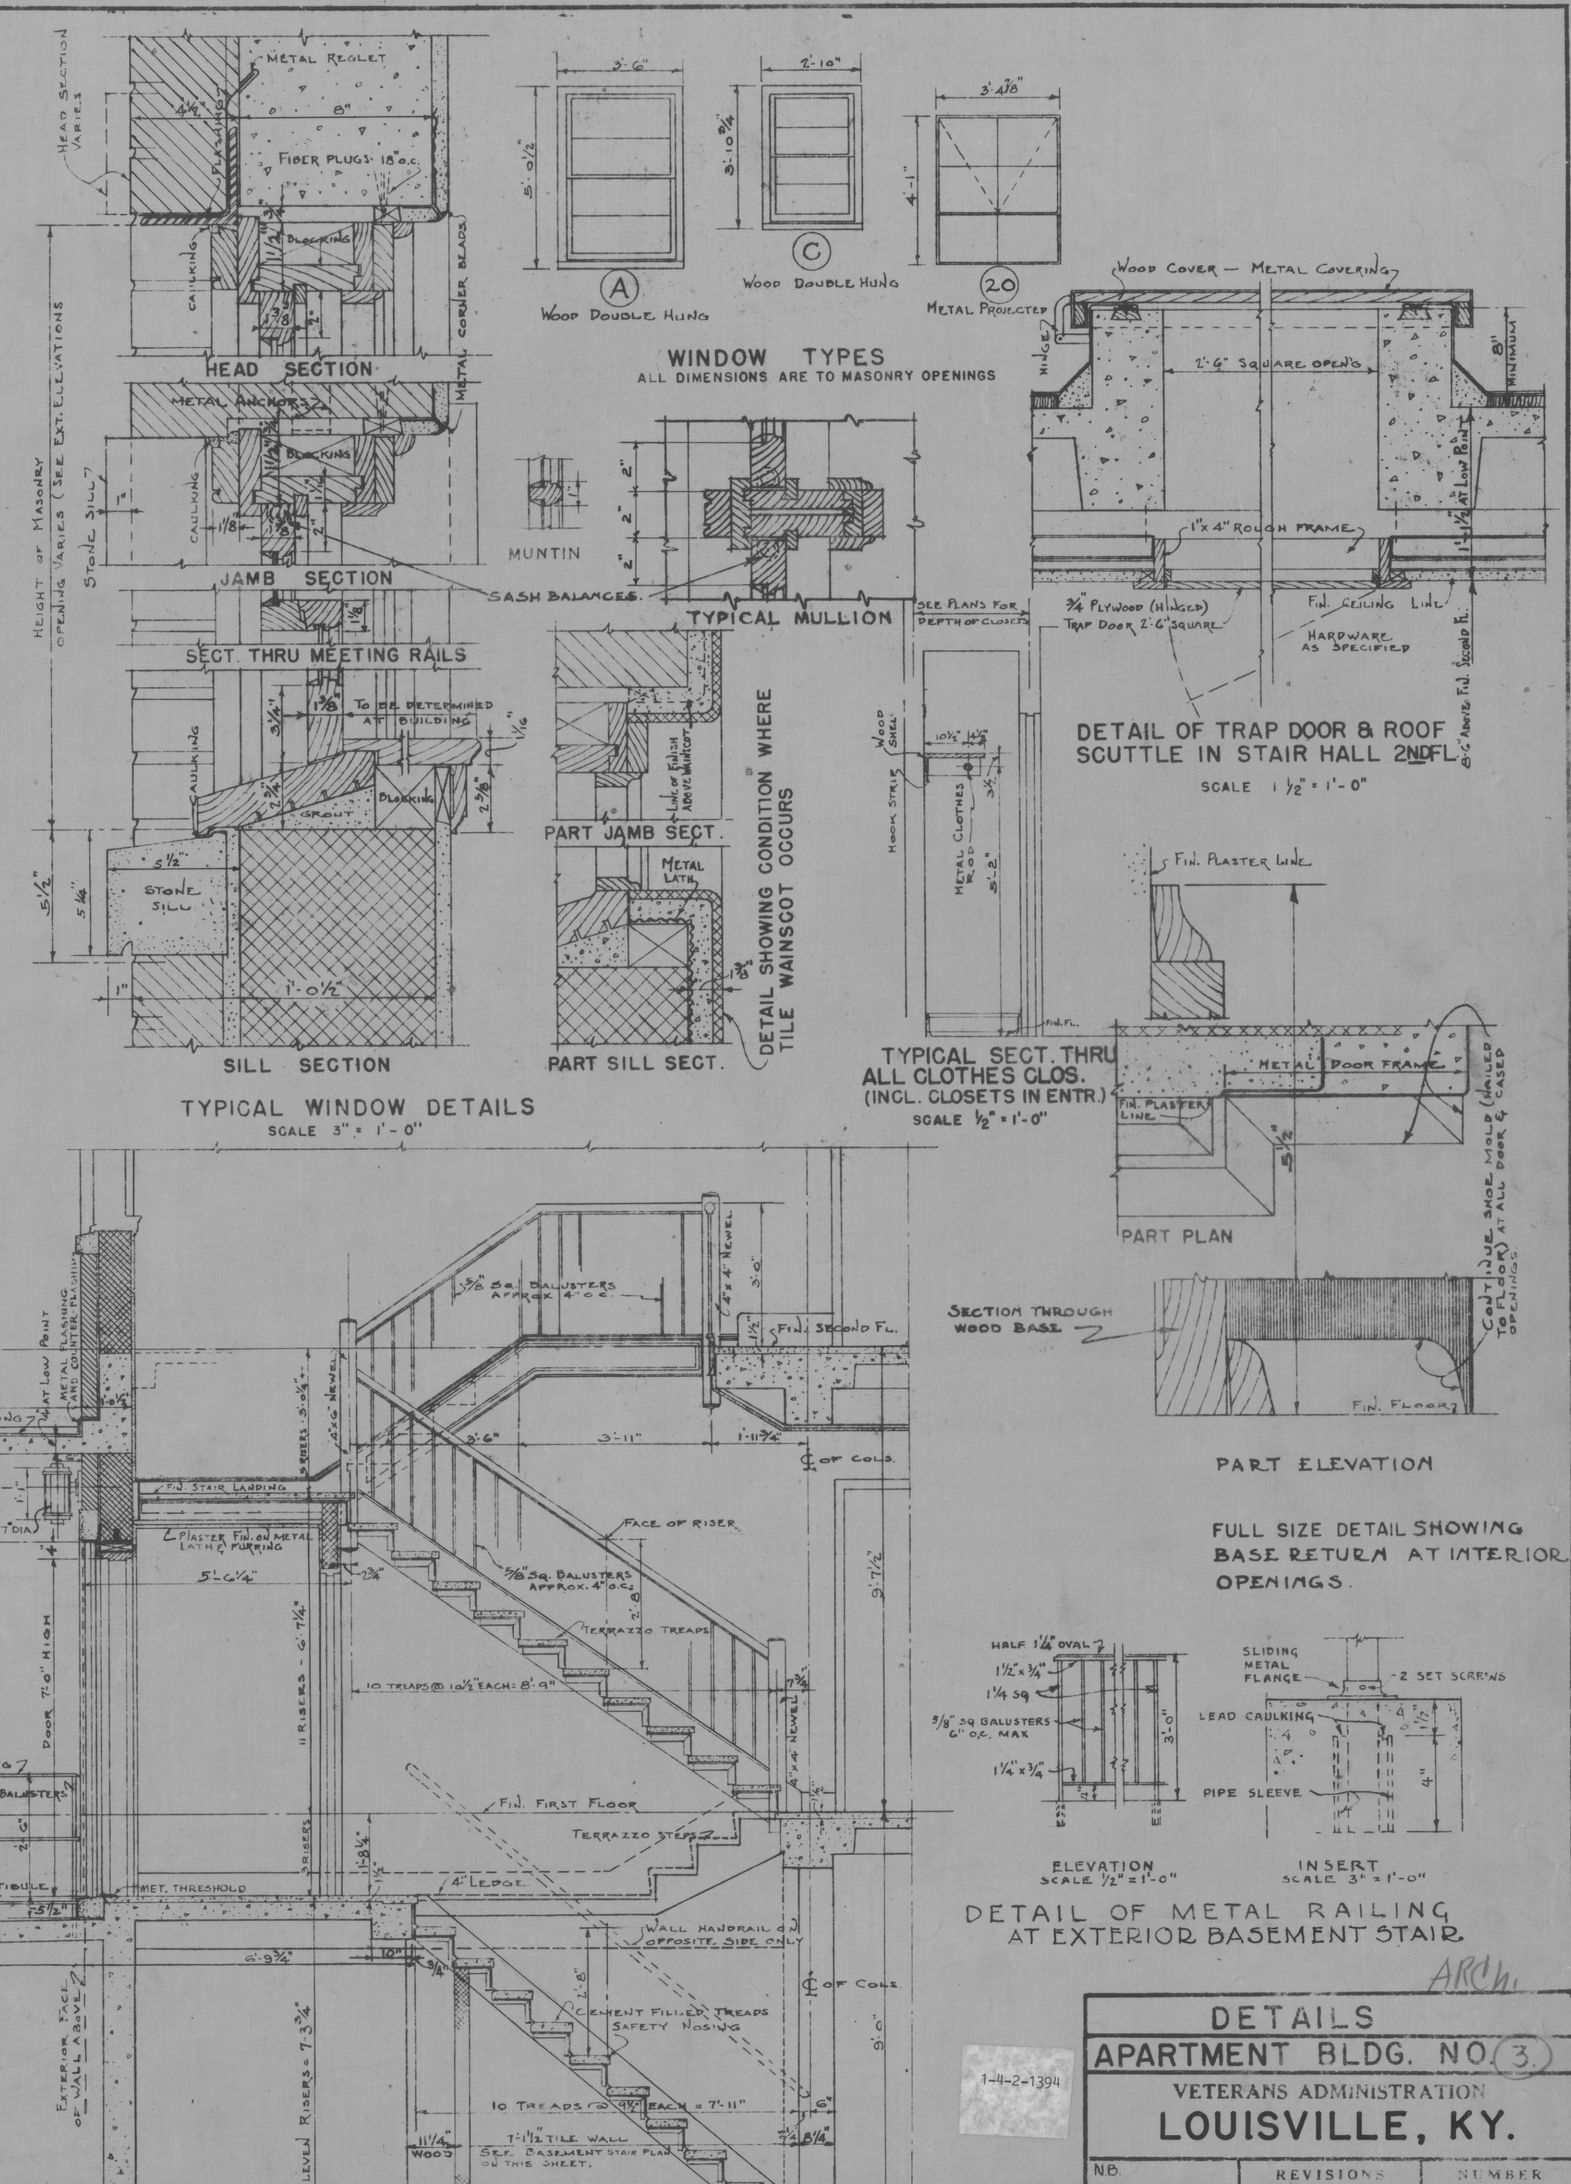

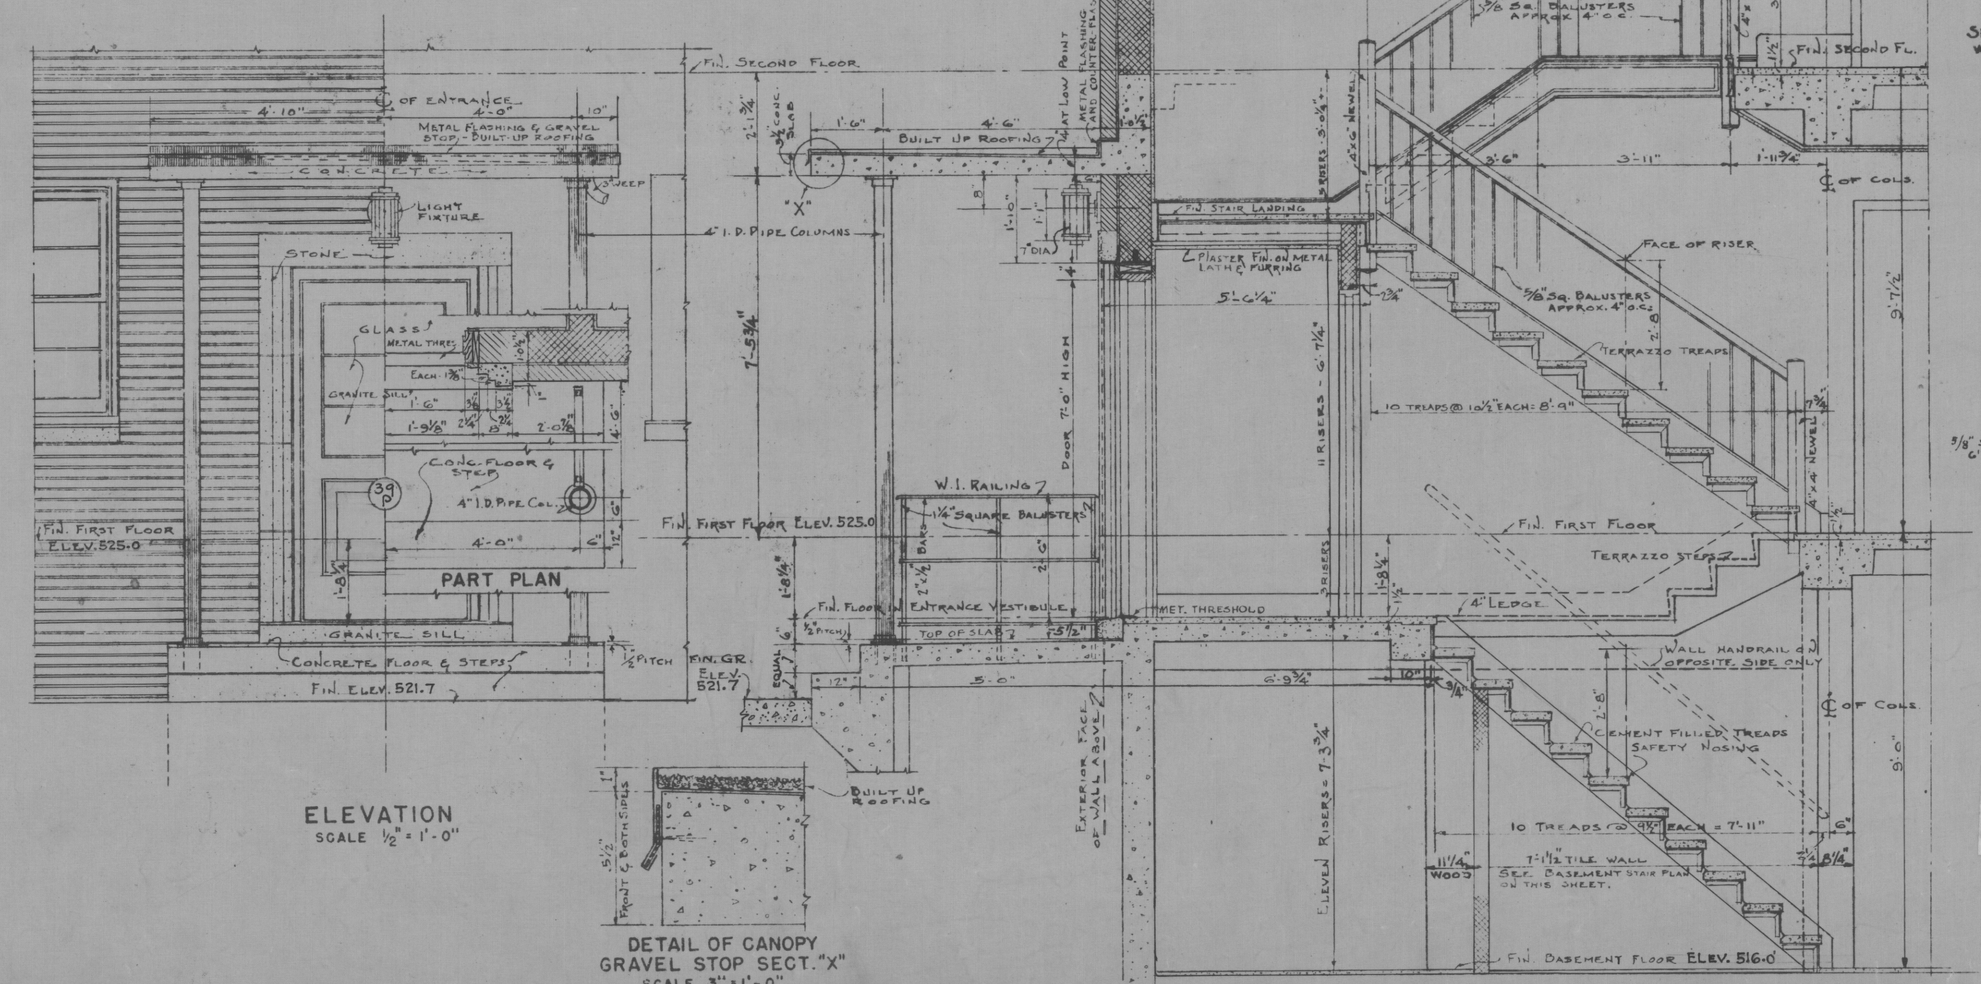

ENTRANCE DETAILS (SCALE AS INDICATED)

VETERANS ADMINISTRATION
WASHINGTON, D. C.

APPROVED
ASSISTANT ADMINISTRATOR
DIRECTOR OF CONSTRUCTION
CHIEF, DESIGN DIVISION

DETAILS
APARTMENT BLDG. NO. 3
VETERANS ADMINISTRATION
LOUISVILLE, KY.

NO.	REVISIONS	NUMBER
Drawn	JAN. 6, 1957 AS BUILT J.H.M.	3-2
Traced R.B.R.		SHEET 2 OF 5
Unit Chief		
Date MAY 10, 1949		
Section Chief		Proj. No. 2883

AS BUILT

RETURN TRACINGS TO PLAN FILES

FILE FOLDER NO. 3

U.S. GOVERNMENT PRINTING OFFICE