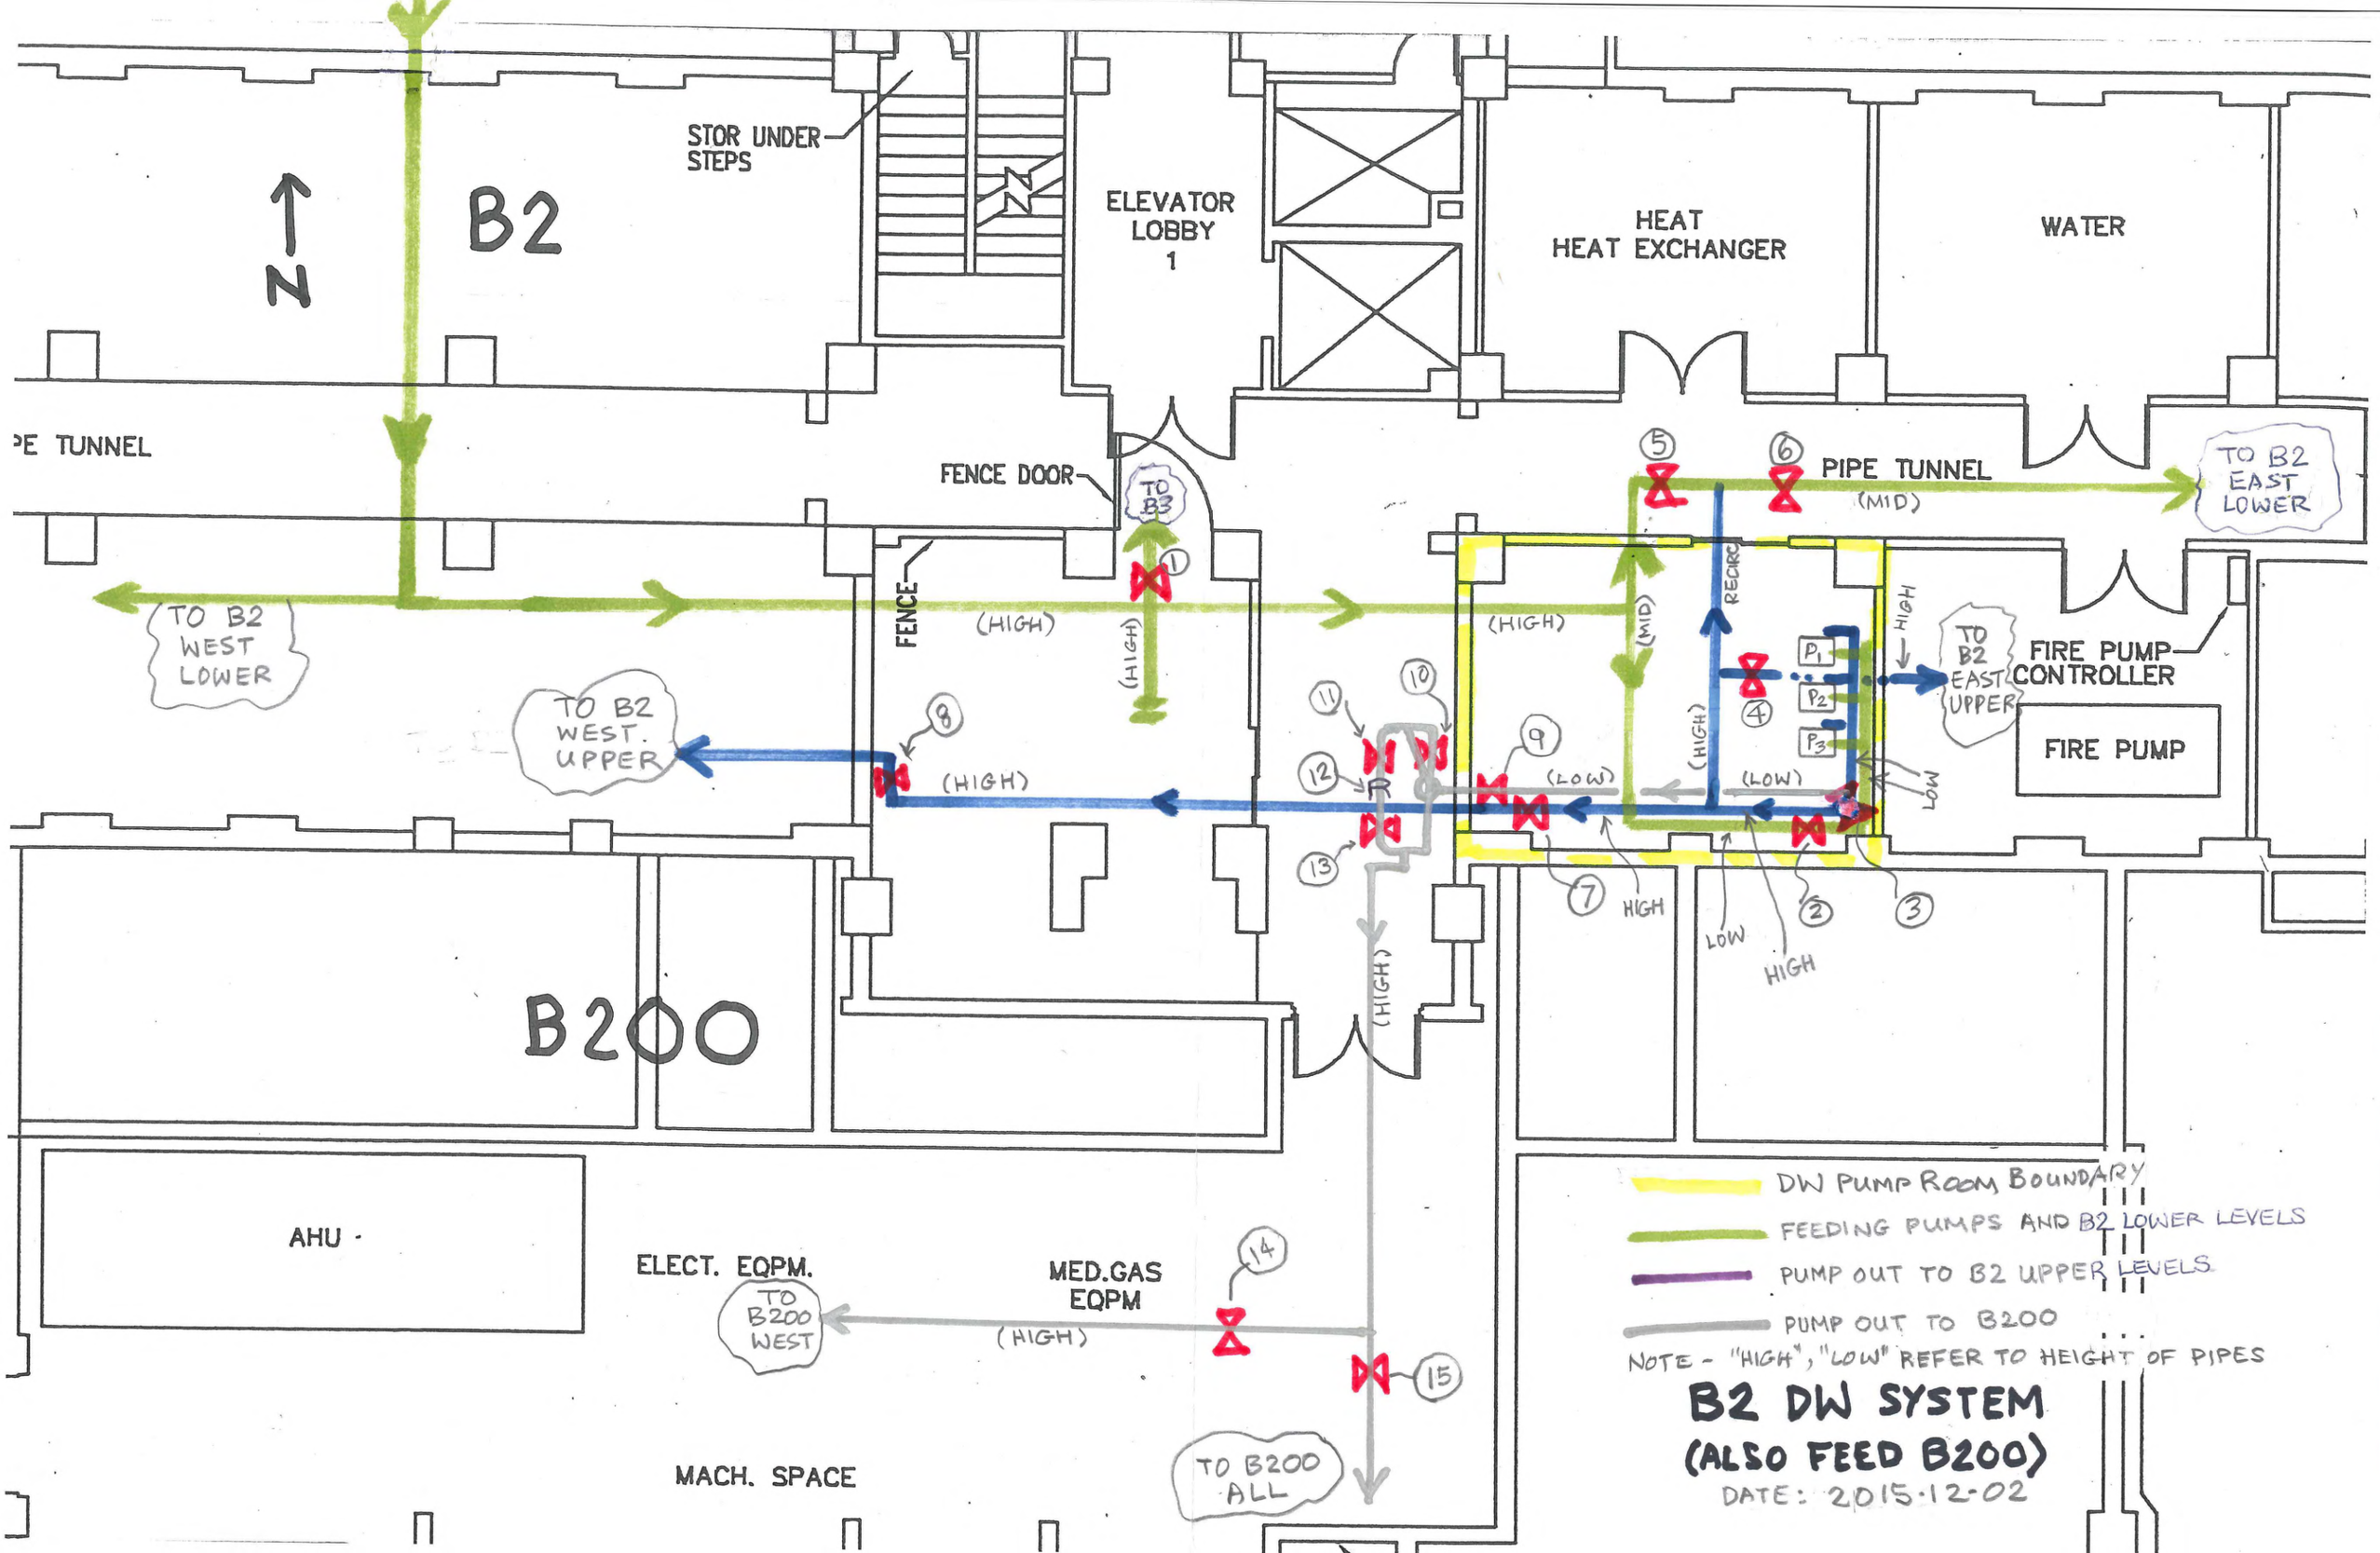
N
B2
STOR UNDER STEPS
ELEVATOR LOBBY 1
HEAT HEAT EXCHANGER
WATER
PE TUNNEL
FENCE DOOR
TO B3
FENCE
(HIGH)
(HIGH)
TO B2 WEST LOWER
TO B2 WEST. UPPER
(HIGH)
(HIGH)
(MID)
PIPE TUNNEL (MID)
TO B2 EAST LOWER
RECIRC
HIGH
TO B2 EAST UPPER
FIRE PUMP CONTROLLER
FIRE PUMP
P1
P2
P3
(HIGH)
(LOW)
(LOW)
LOW
HIGH
LOW
HIGH
(LOW)
(HIGH)
B200
AHU
ELECT. EQPM.
TO B200 WEST
MED.GAS EQPM
(HIGH)
TO B200 ALL
MACH. SPACE
DW PUMP ROOM BOUNDARY
FEEDING PUMPS AND B2 LOWER LEVELS
PUMP OUT TO B2 UPPER LEVELS
PUMP OUT TO B200
NOTE - "HIGH", "LOW" REFER TO HEIGHT OF PIPES
B2 DW SYSTEM
(ALSO FEED B200)
DATE: 2015-12-02