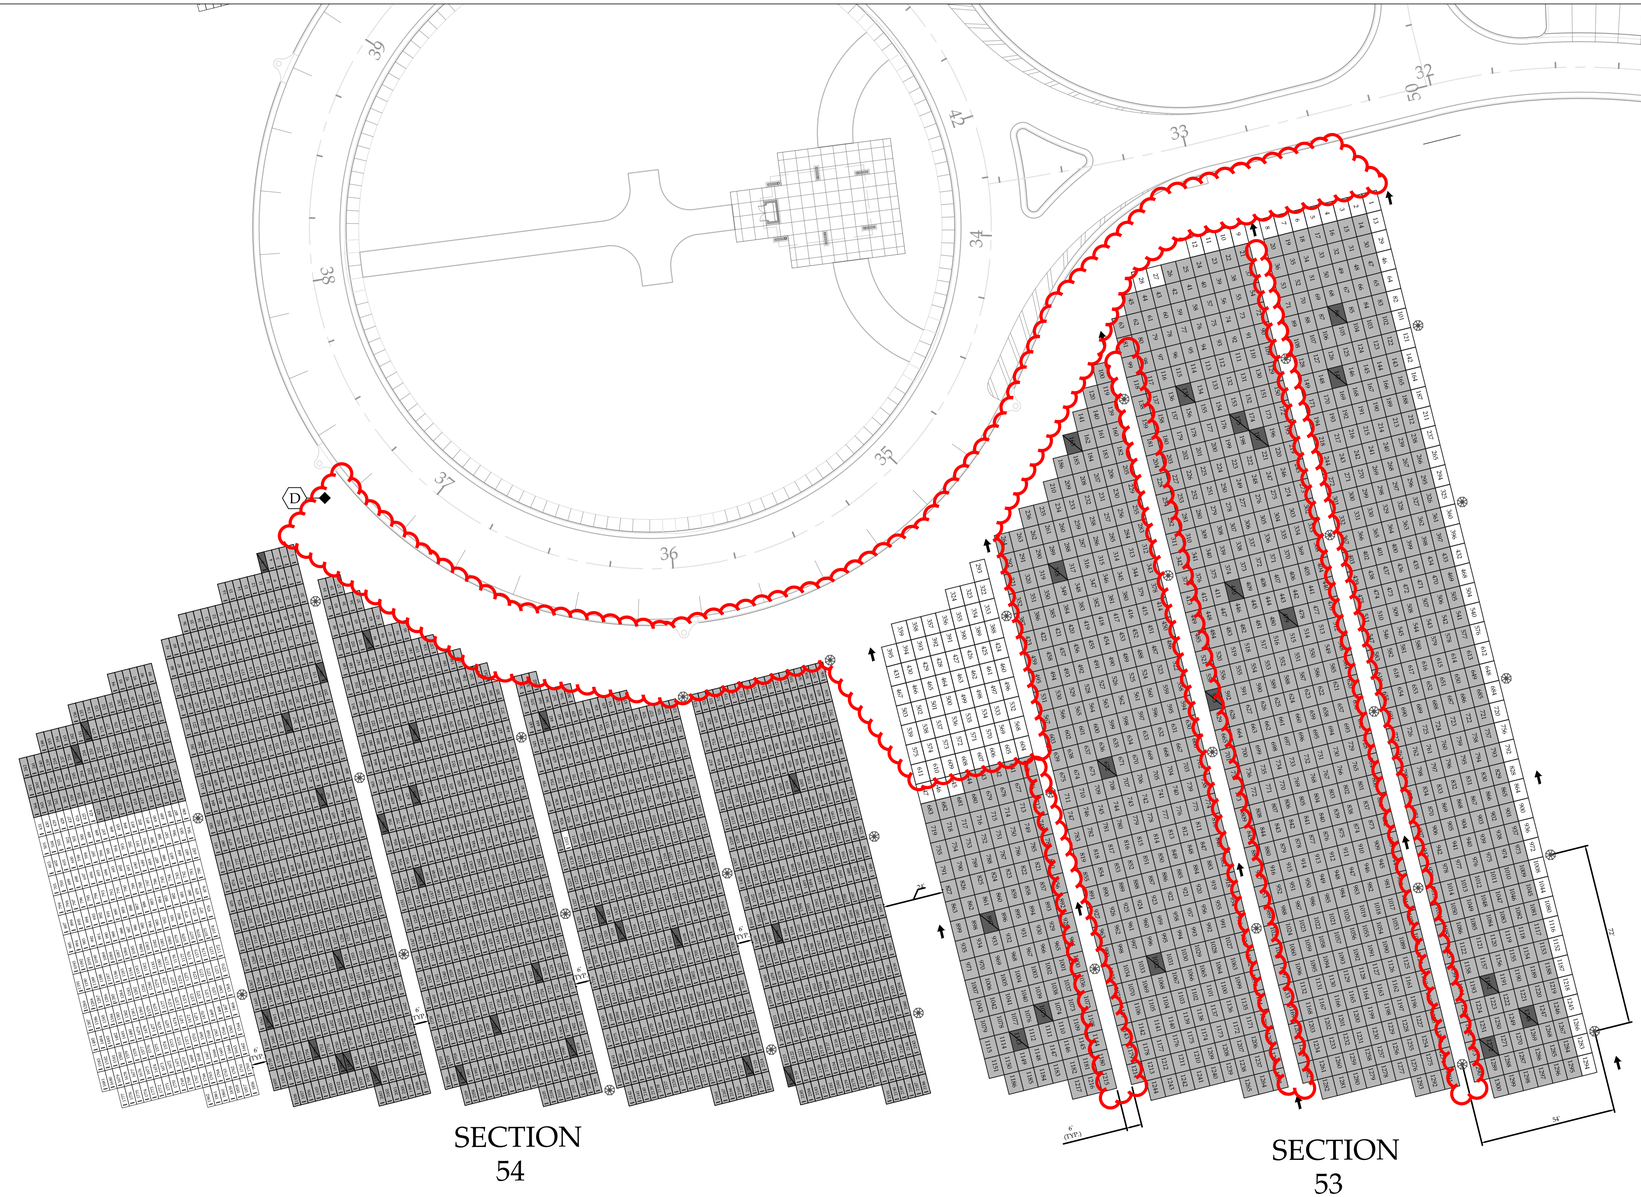

Scale 1 : 30

LEGEND

- AVAILABLE GRAVESITE
- SET ASIDE/RESERVED
- OBSTRUCTED GRAVESITE
- OCCUPIED GRAVESITE
- GRAVES FACE
- GRAVESITE CONTROL MONUMENT

National Cemetery Administration
Memorial Service Network II
Decatur, Georgia 30033

Drawing Title: Section 53 Layout Drawing

Project: Barrancas National Cemetery

Location: Pensacola, FL

Date: 1/14/13

Project No.:

Approved: Area Director

Approved: Cemetery Director

Building Number

Checked

Drawn: DCJ

Path: \\Cematla101\share\MSN II Drawings\Barrancas\Updated Layout

Drawing Title: 823LA053 Sections 53-54

Dwg. Of

Revisions	Date

VA FORM 08-6231, FEB. 1983