

CAPACITY IN GRAVESITES					
SECTION	SIZE OF GRAVESITE	TOTAL	AGS	AVAIL	REMARKS
50	6 x 10			SEE GBSAT	
51	6 x 10				
52	6 x 10				

Corrections, Updates and BOSS Reconcile

4/2/15


Update and BOSS Reconcile

10/24/14

Revisions

Date

Scale 1 : 30

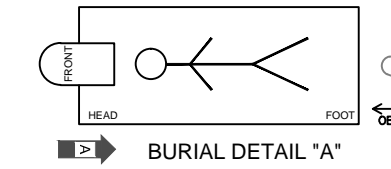

- LEGEND
- AVAILABLE GRAVESITE
 - SET ASIDE
 - OBSTRUCTED GRAVESITE
 - OCCUPIED GRAVESITE
 - GRAVES FACE
 - GRAVESITE CONTROL MONUMENT



National Cemetery Administration
Memorial Service Network II
Decatur, Georgia 30033

Drawing Title

Sections 50-52
Layout Drawing

Project No.

09/18/09

Location

Barrancas National Cemetery
Pensacola, FL

Building Number

Checked

DCJ

Path

\\Cematla101\share\MSN II Drawings\Barrancas\Updated Layout

Dwg

Of