



SECTION 41

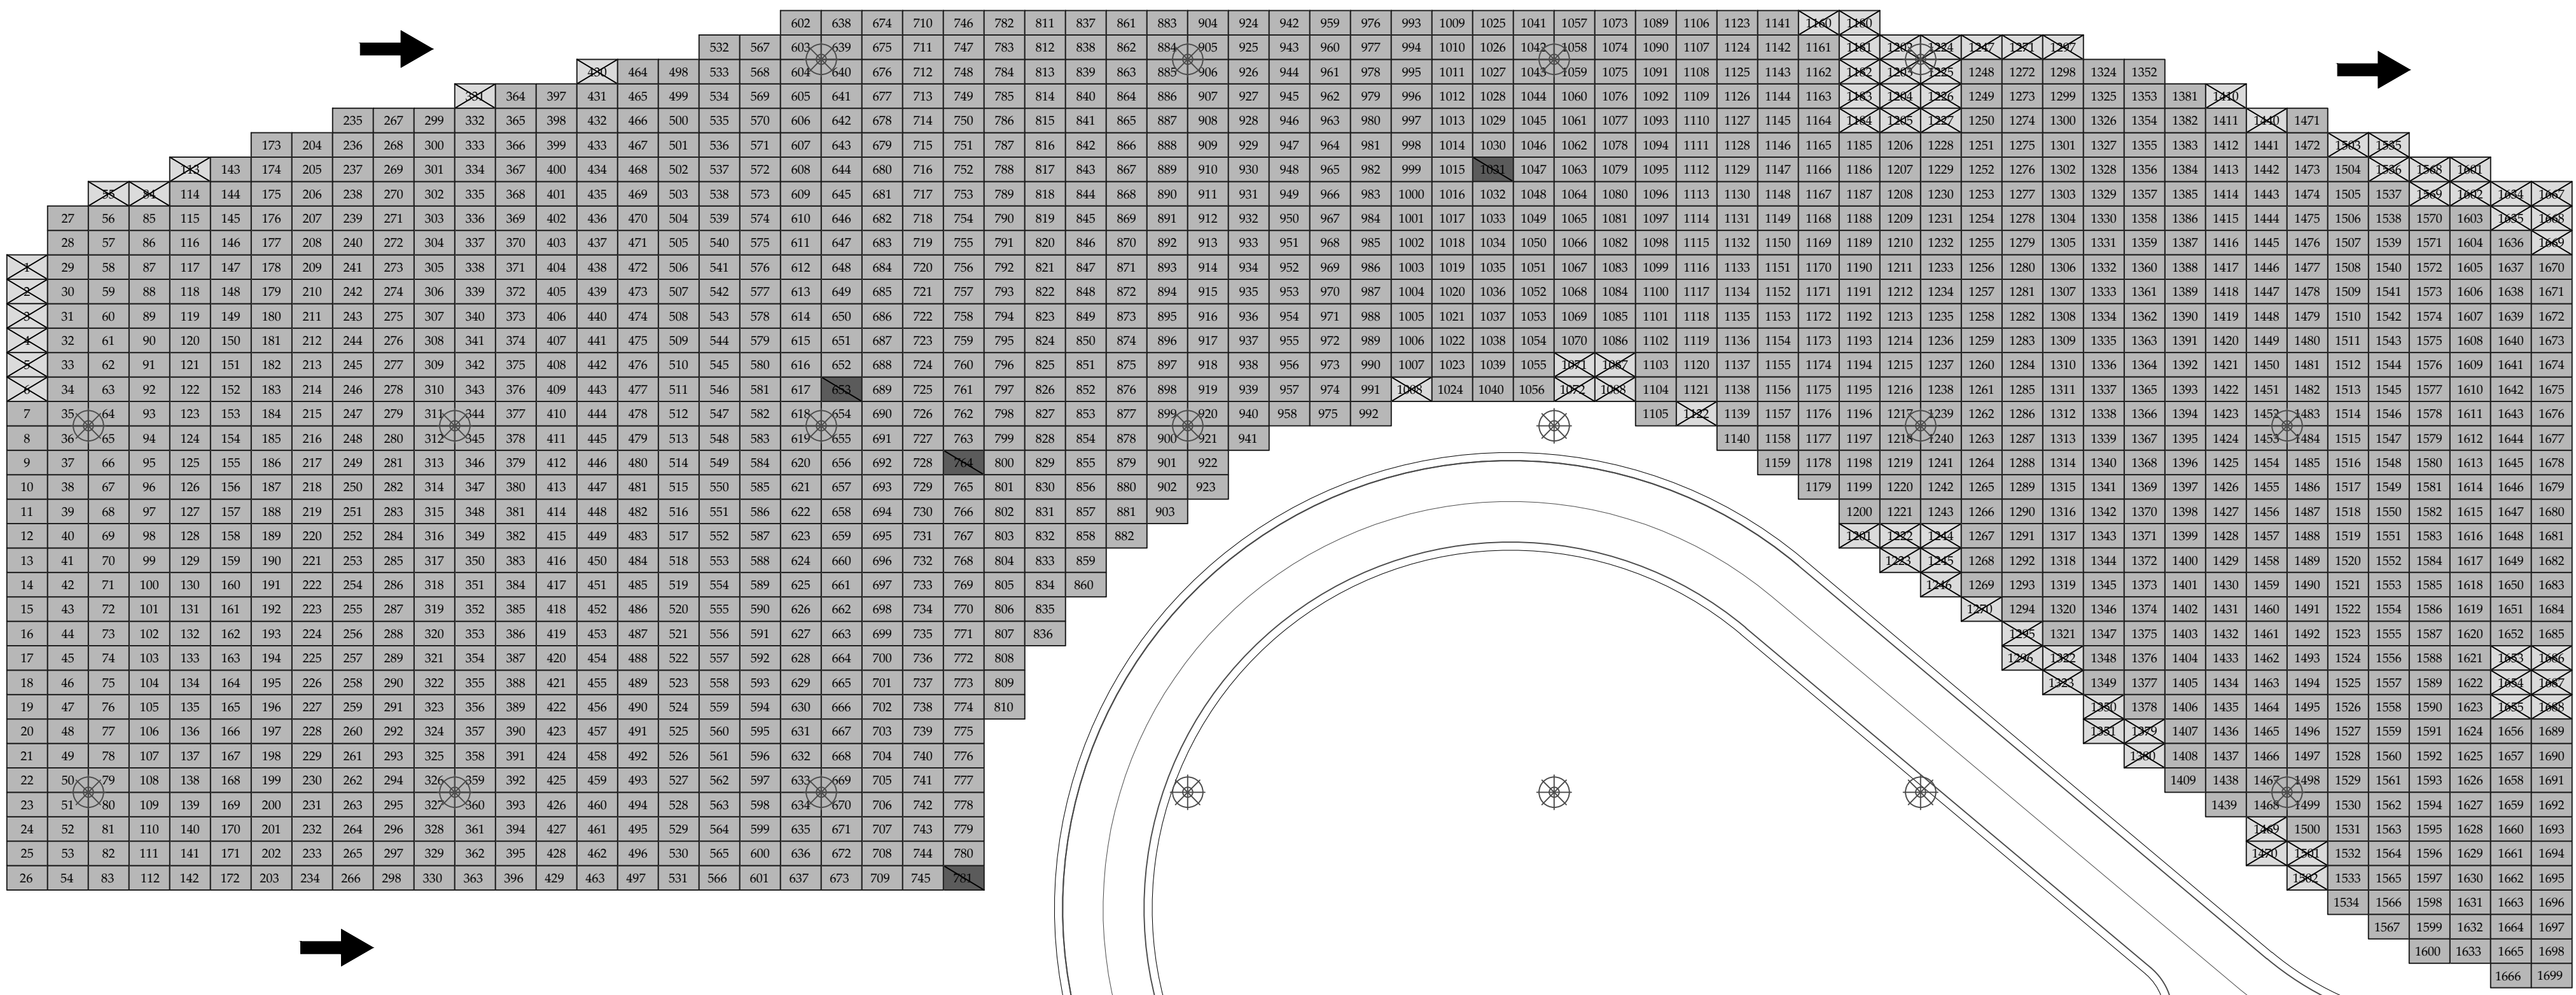


SECTION 40

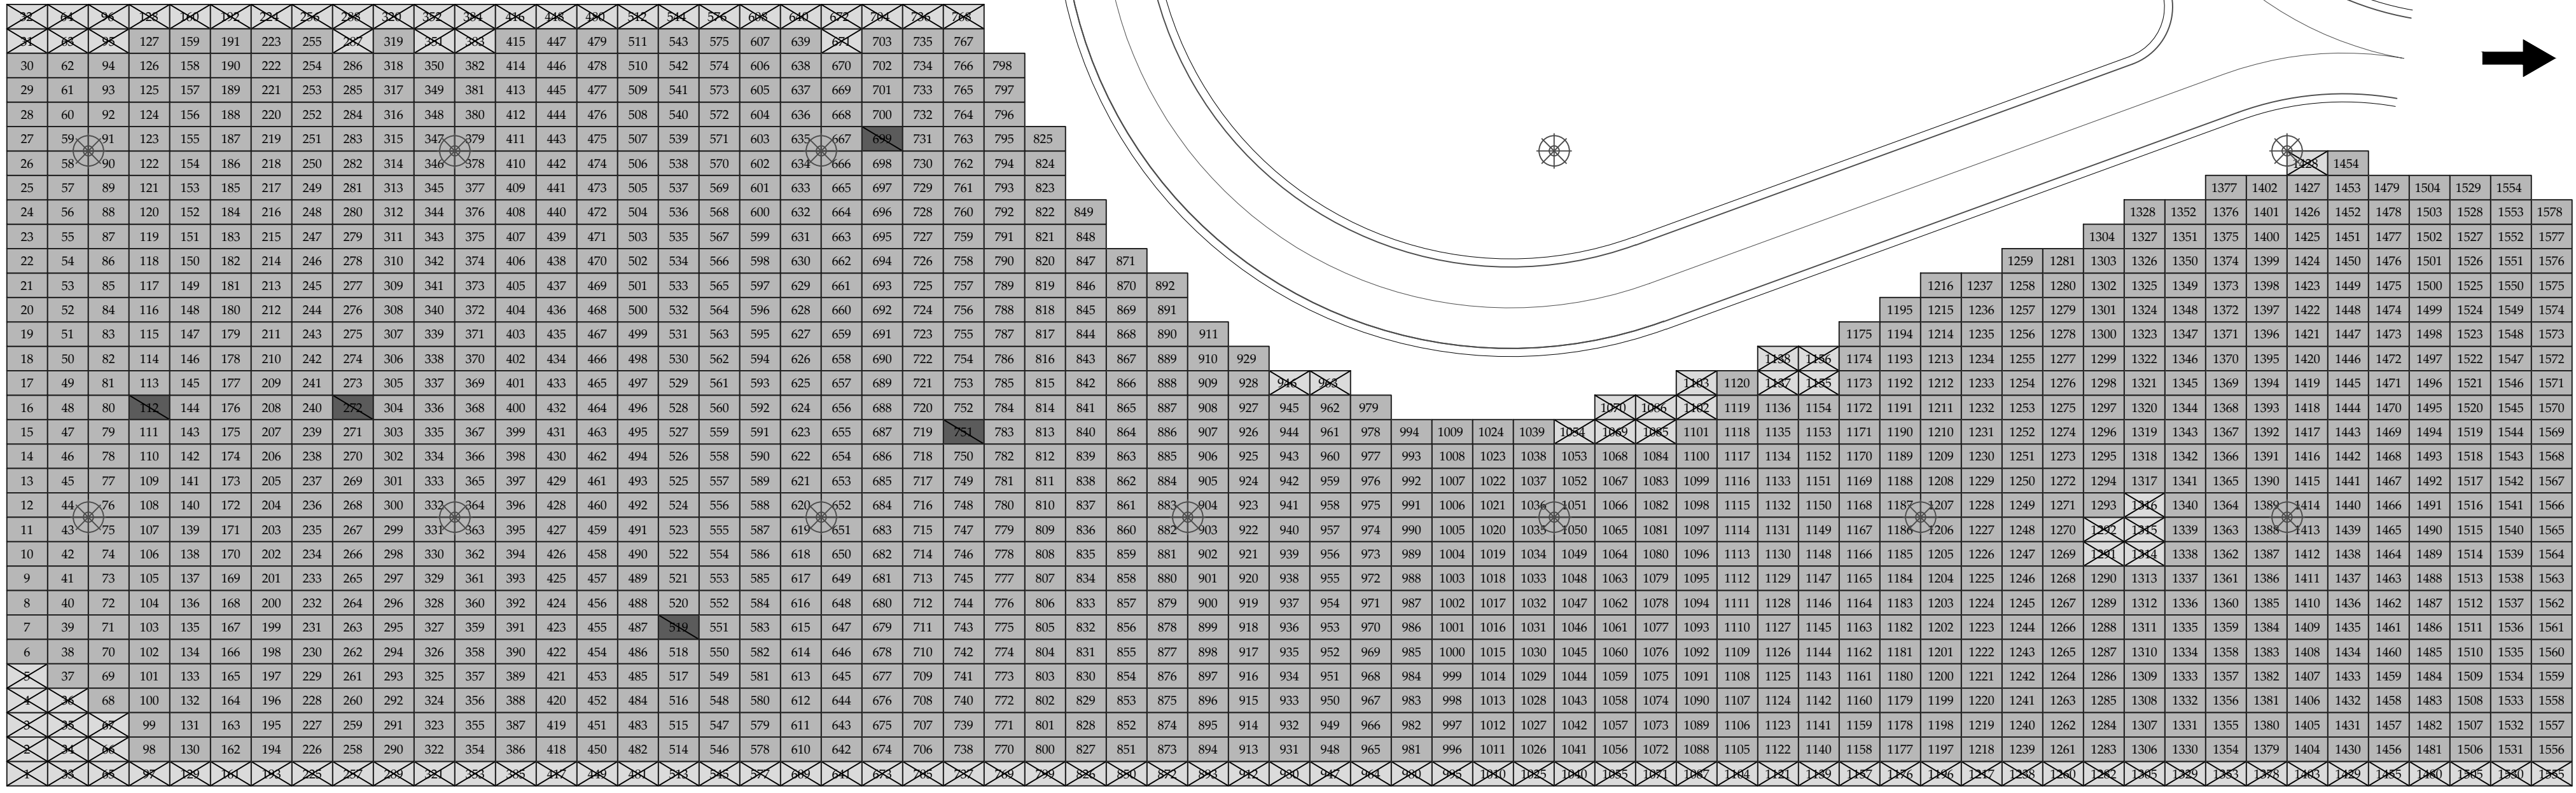

Update and BOSS Reconcile	4/2/15
Update and BOSS Reconcile	10/24/14
Reformat, Update and BOSS Reconcile	3/5/14
Semi-Annual Update	9/27/12
Semi-Annual Update	3/26/12
Semi-Annual Update	9/26/11
Semi-Annual Update	3/14/11
Semi-Annual Update	9/21/10
Semi-Annual Update	3/22/10
Semi-Annual Update	9/21/09
Revisions	Date

CAPACITY IN GRAVESITES						
SECTION	SIZE OF GRAVESITE	TOTAL	RES	AVAIL	OBST.	REMARKS
40	6 x 10	1578	4	9	126	
41	6 x 10	1699	5	9	60	

Scale 1 : 30

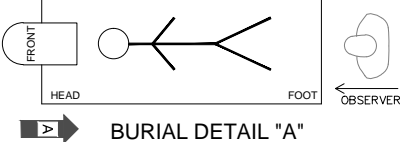

LEGEND	
	AVAILABLE GRAVESITE
	SET ASIDE
	OBSTRUCTED GRAVESITE
	OCCUPIED GRAVESITE
	GRAVES FACE
	GRAVESITE CONTROL MONUMENT



National Cemetery Administration
Memorial Service Network II
Decatur, Georgia 30033

Drawing Title Sections 40 and 41 Layout Drawing		Project: Barrancas National Cemetery Location: Pensacola, FL	Date 09/18/09
Approved: Area Director	Building Number	Checked	Project No.
Approved: Cemetery Director	Drawn DCJ		Drawing Title 823LA003 Sections 40 and 41
			Dwg. CR