
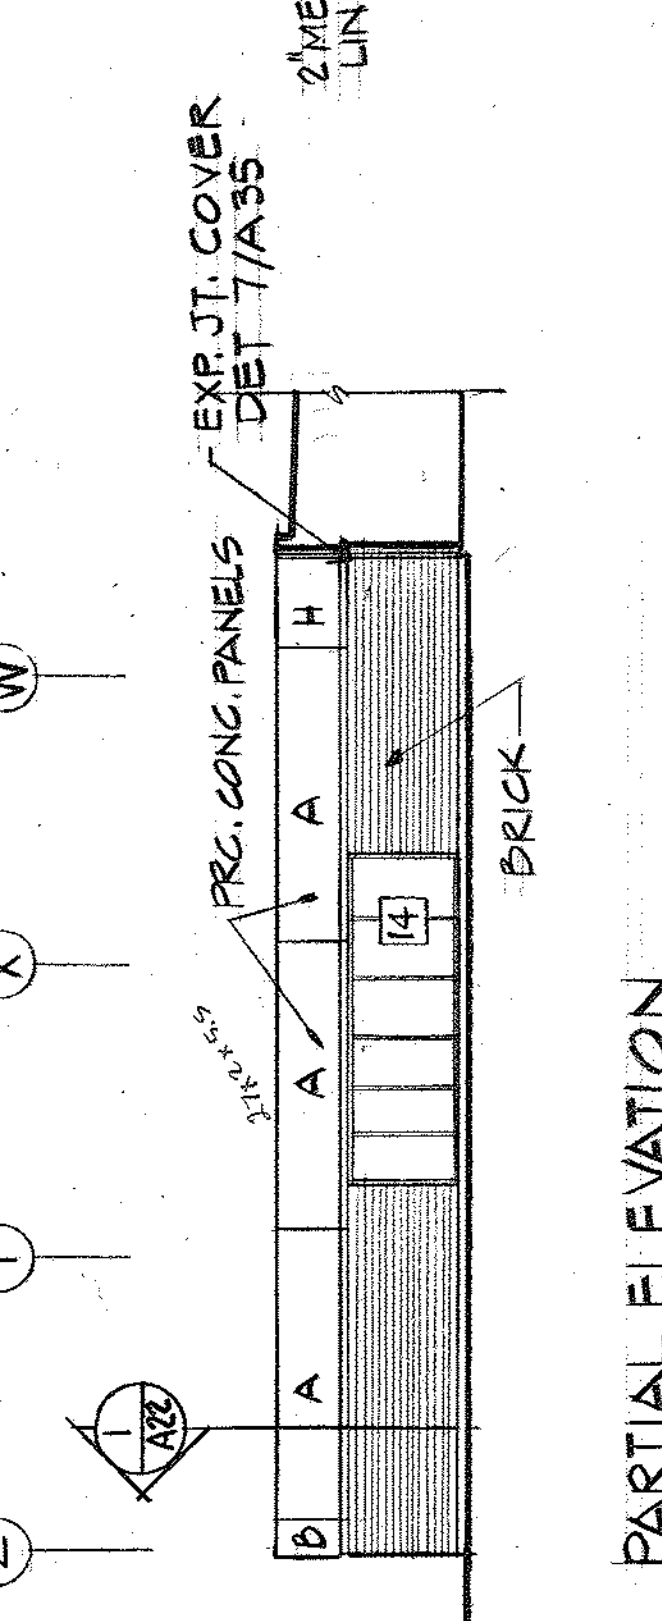
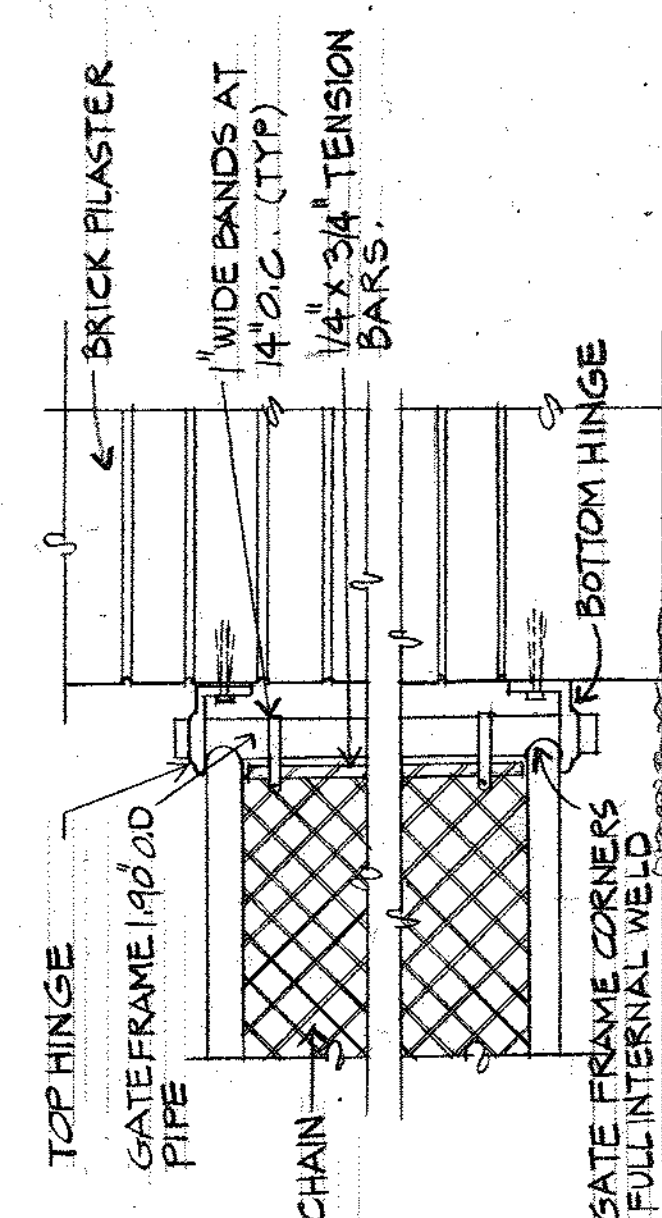
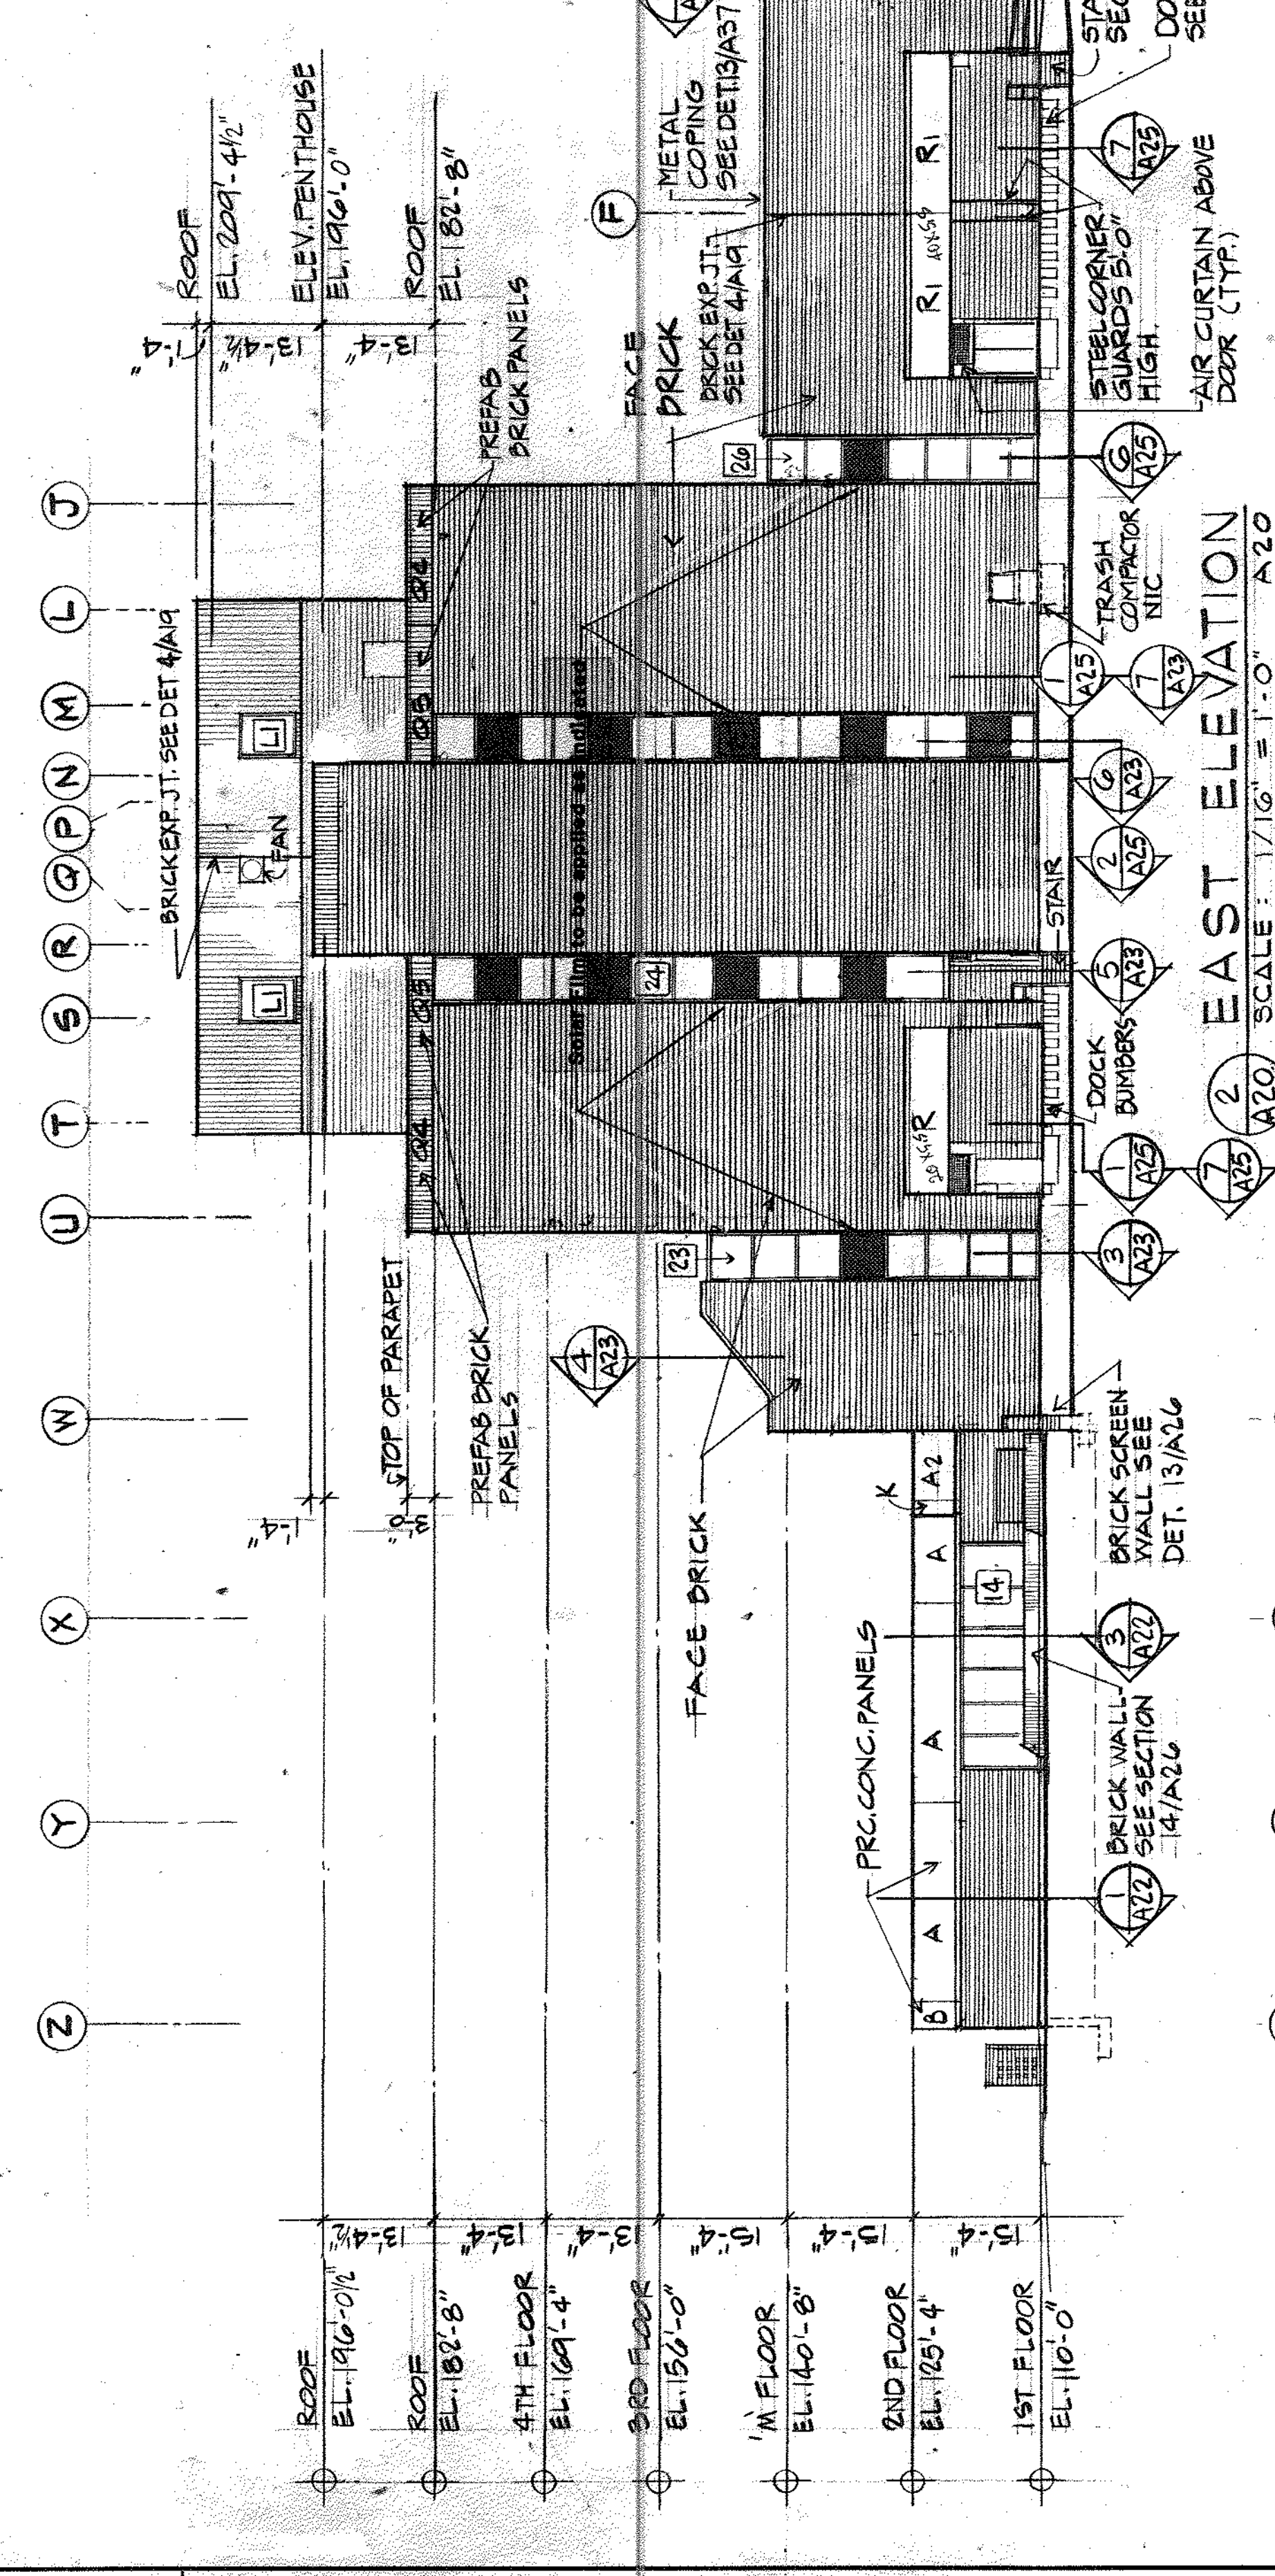
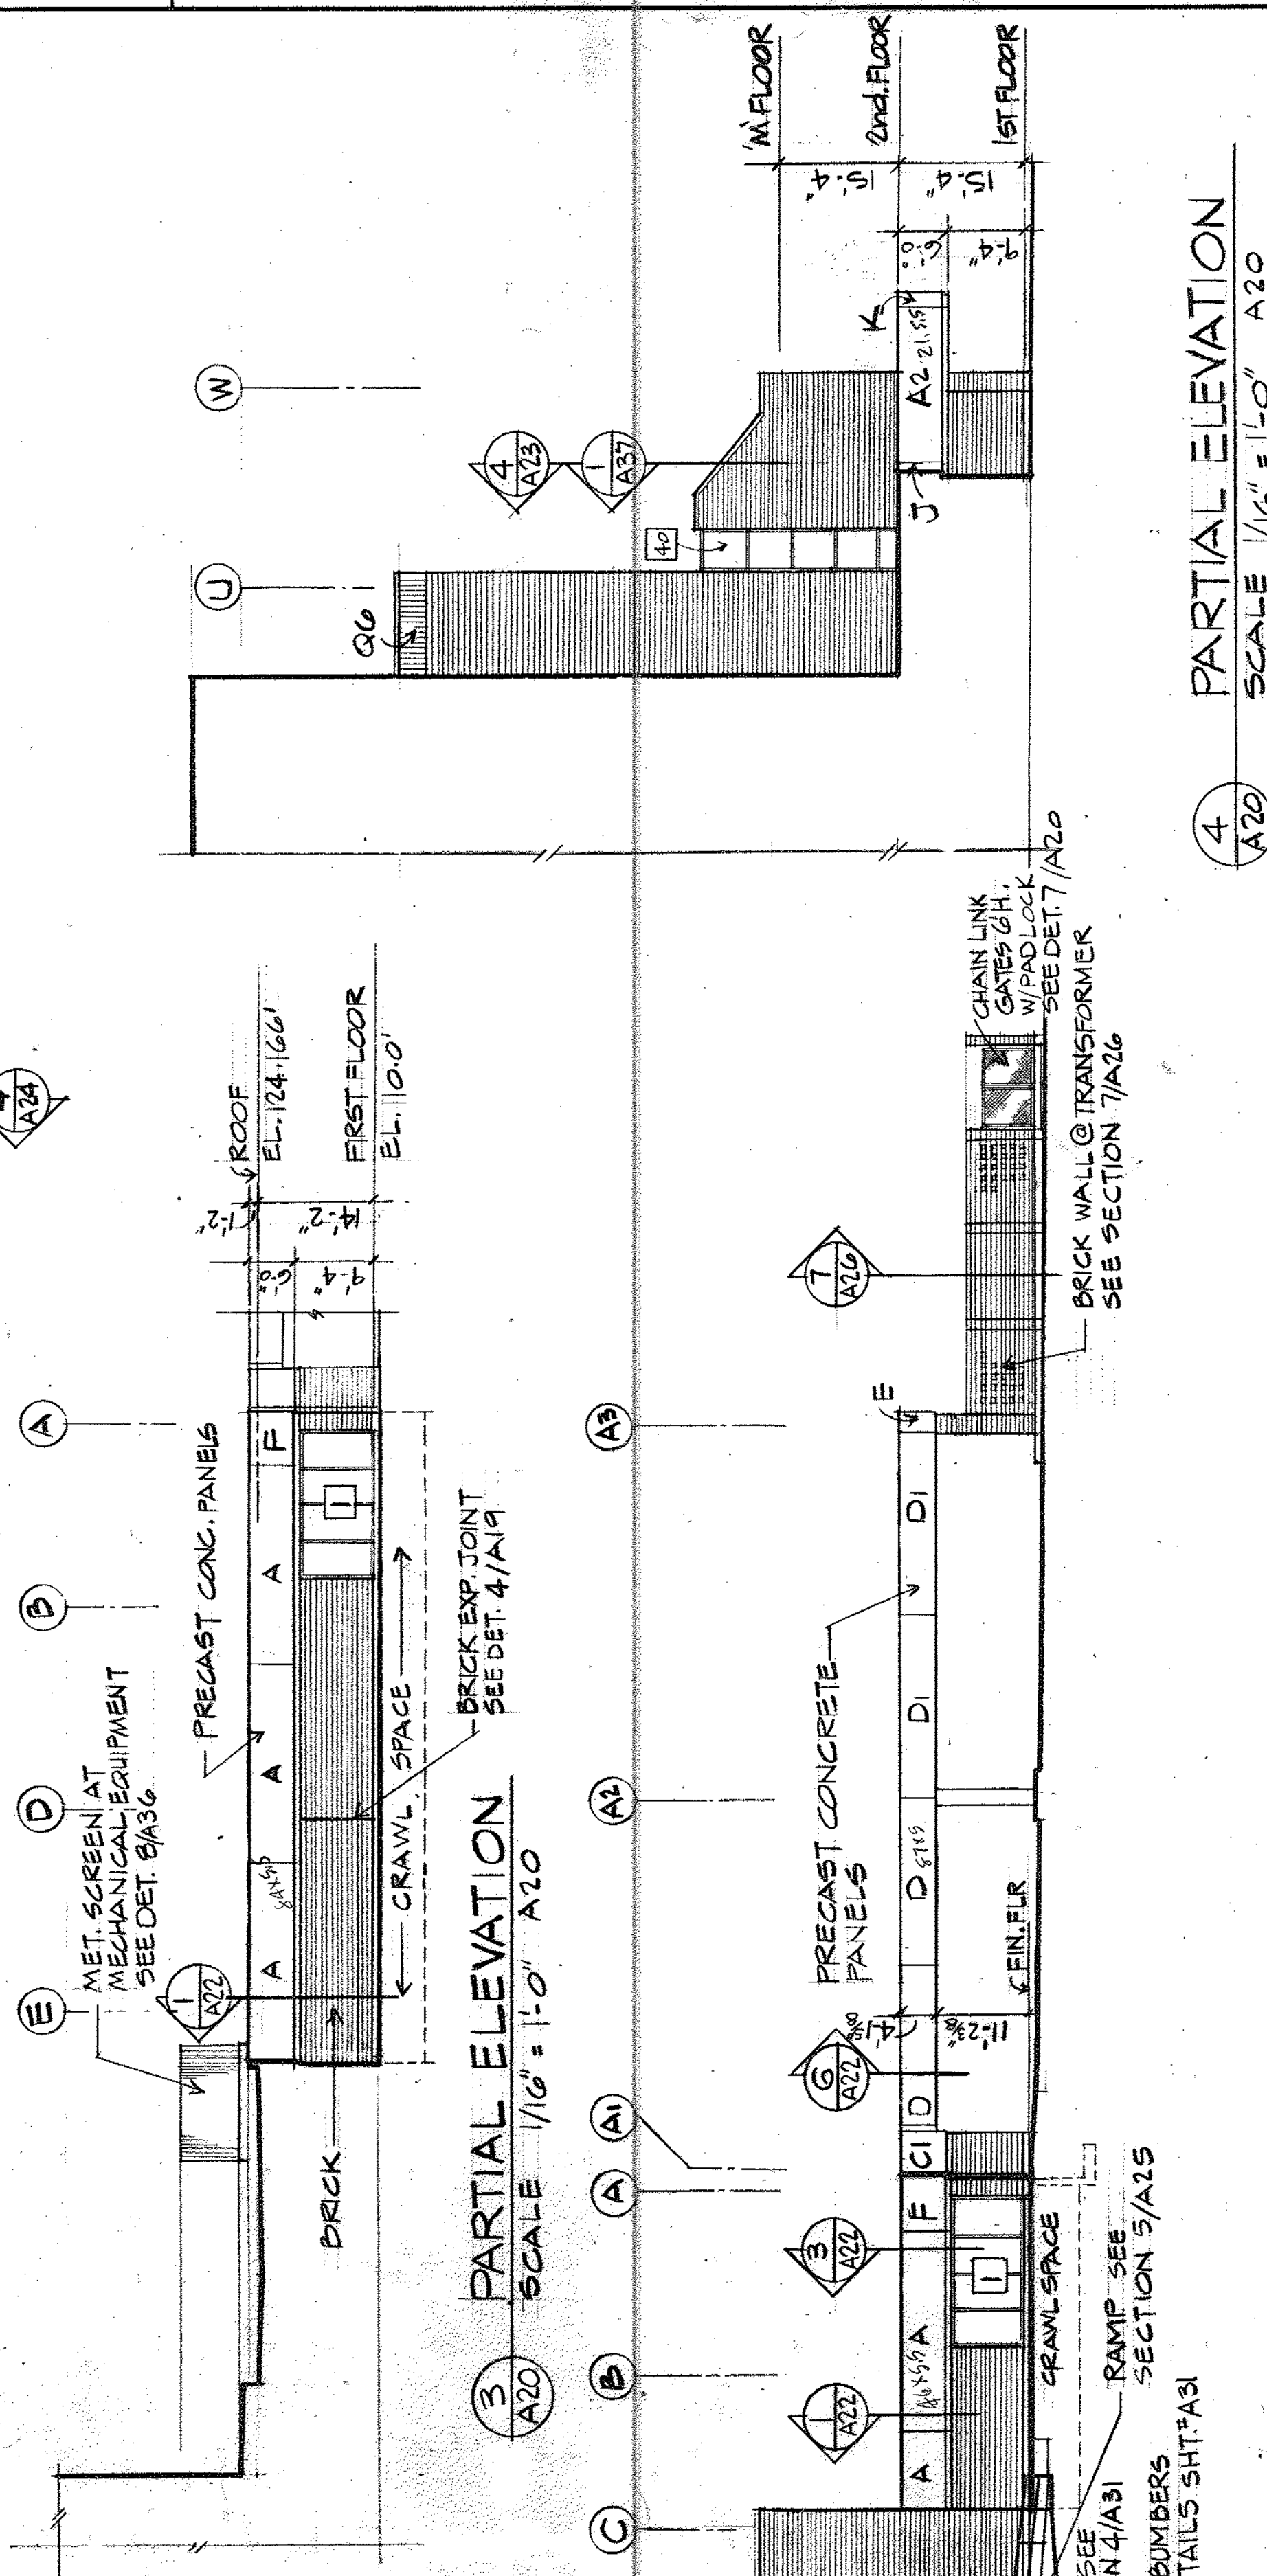
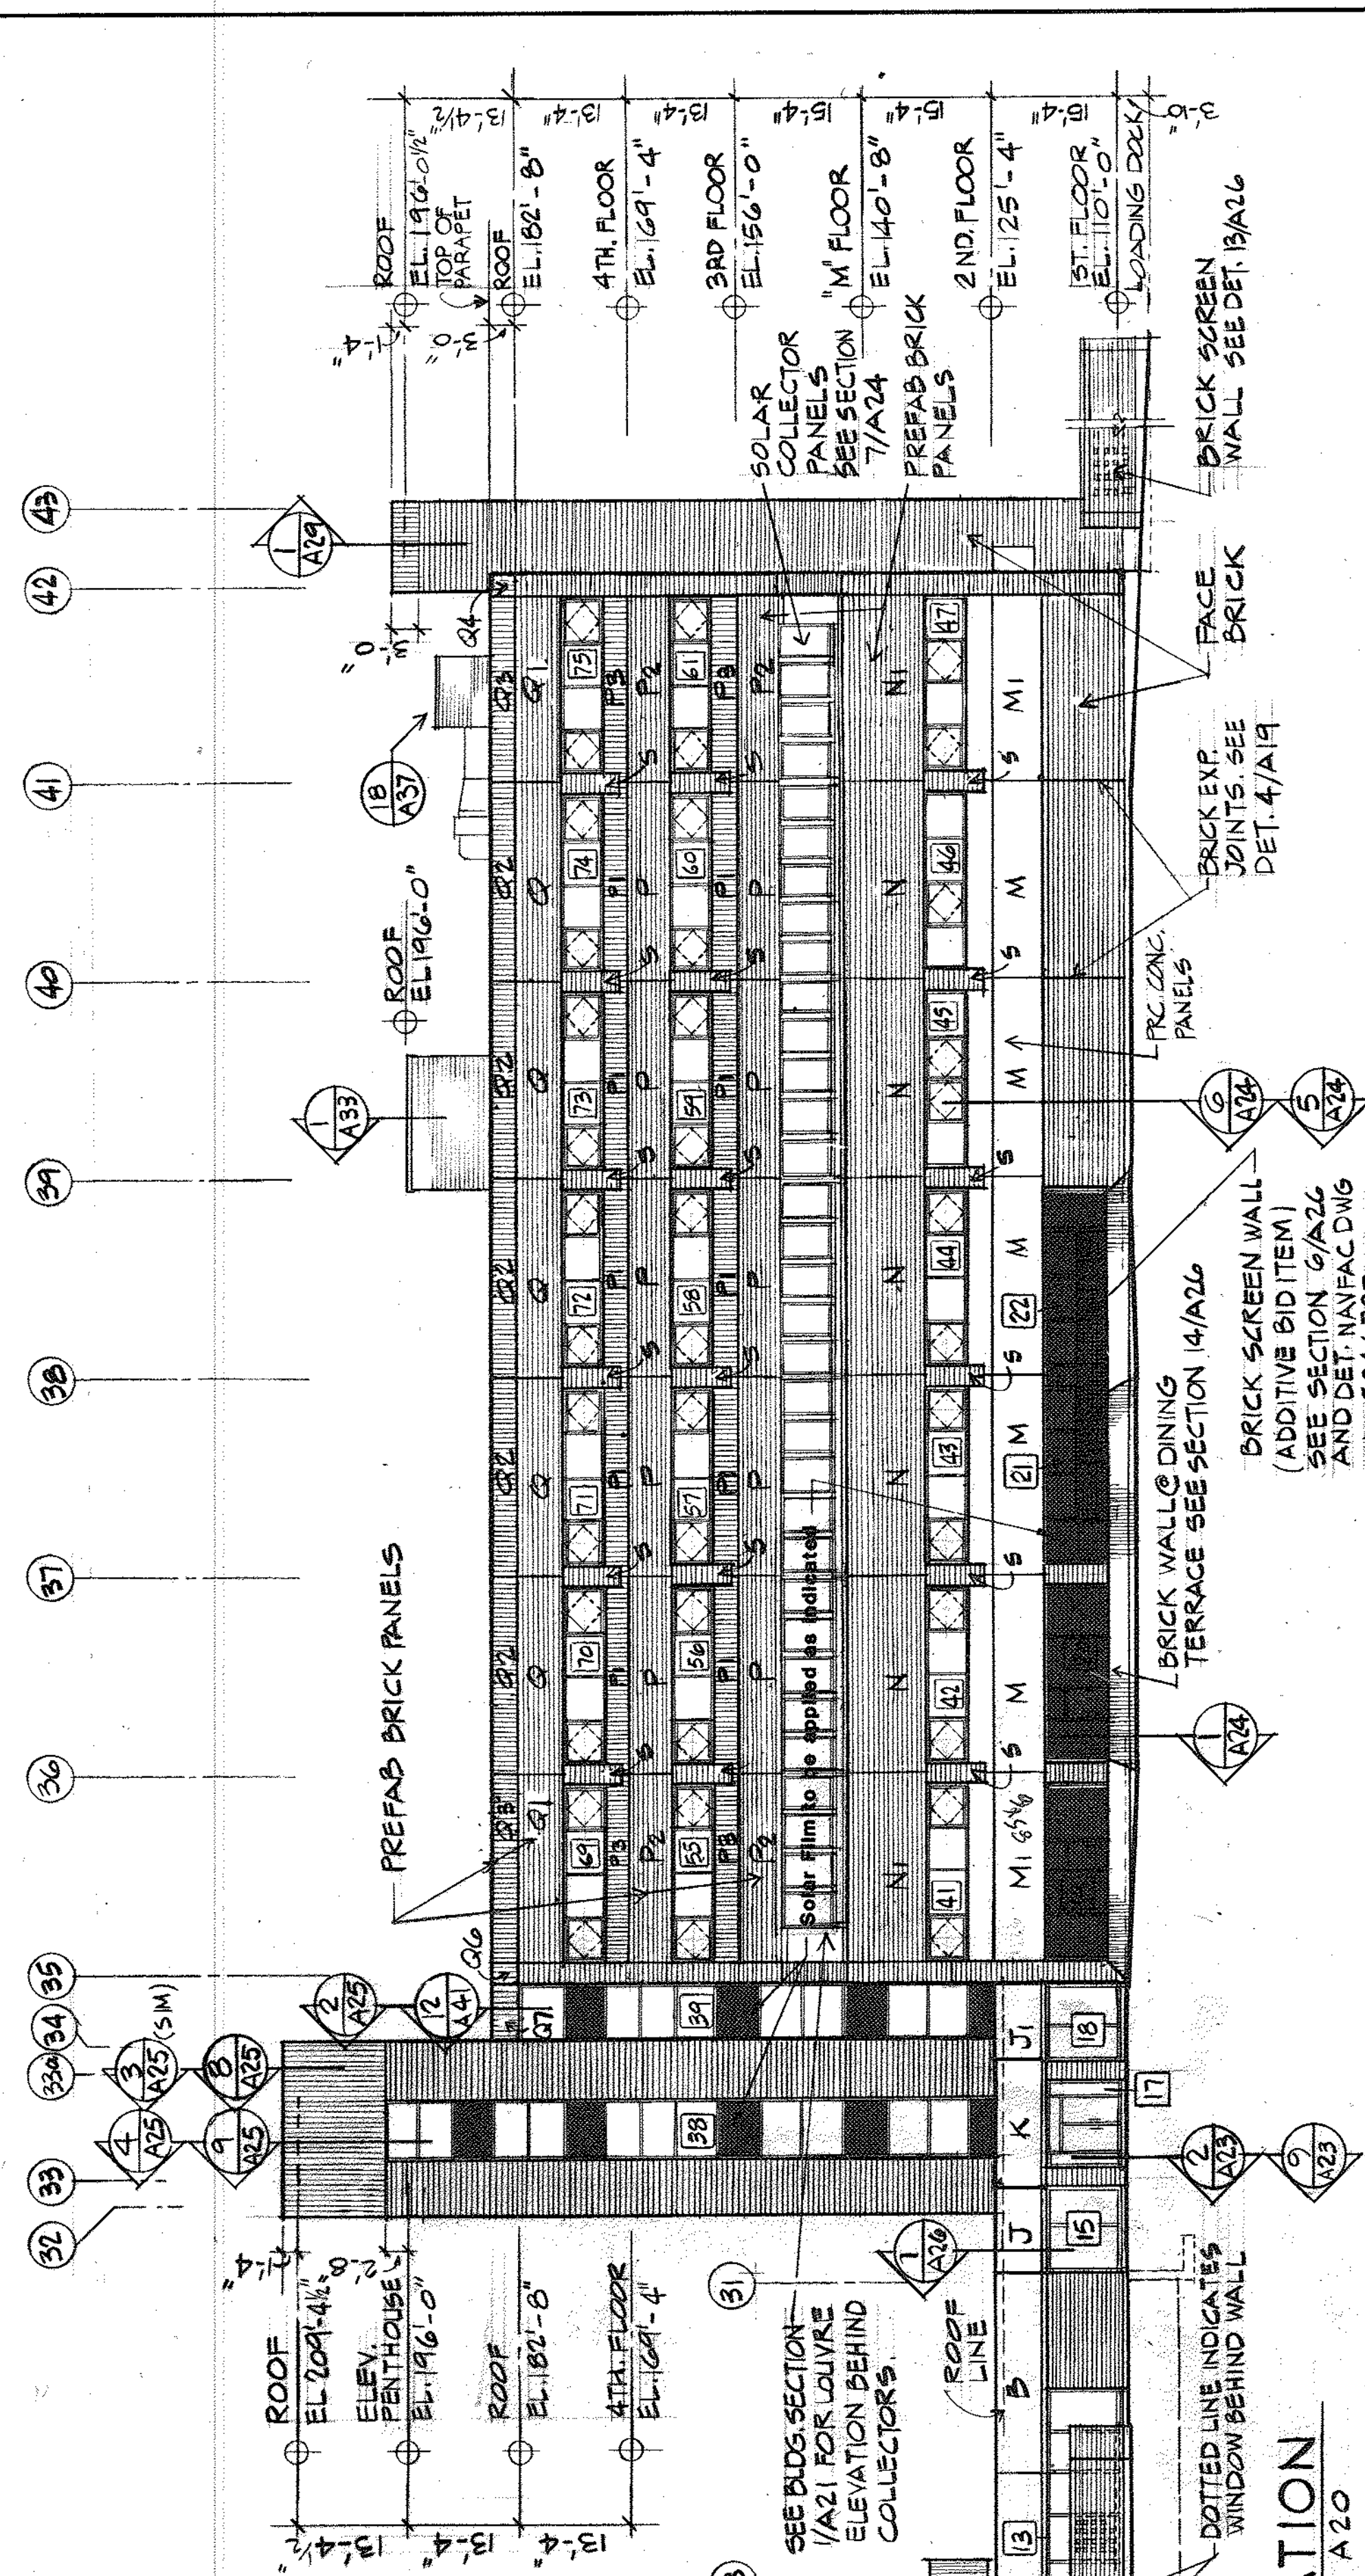


REV A				REVISEMENTS			
LET	DESCRIPTION	PREP'D BY	DATE	APPROVED			
	AS-BUILT DRAWG. NO CORRECTIONS	GR EG	40CT92	MURDOCK			

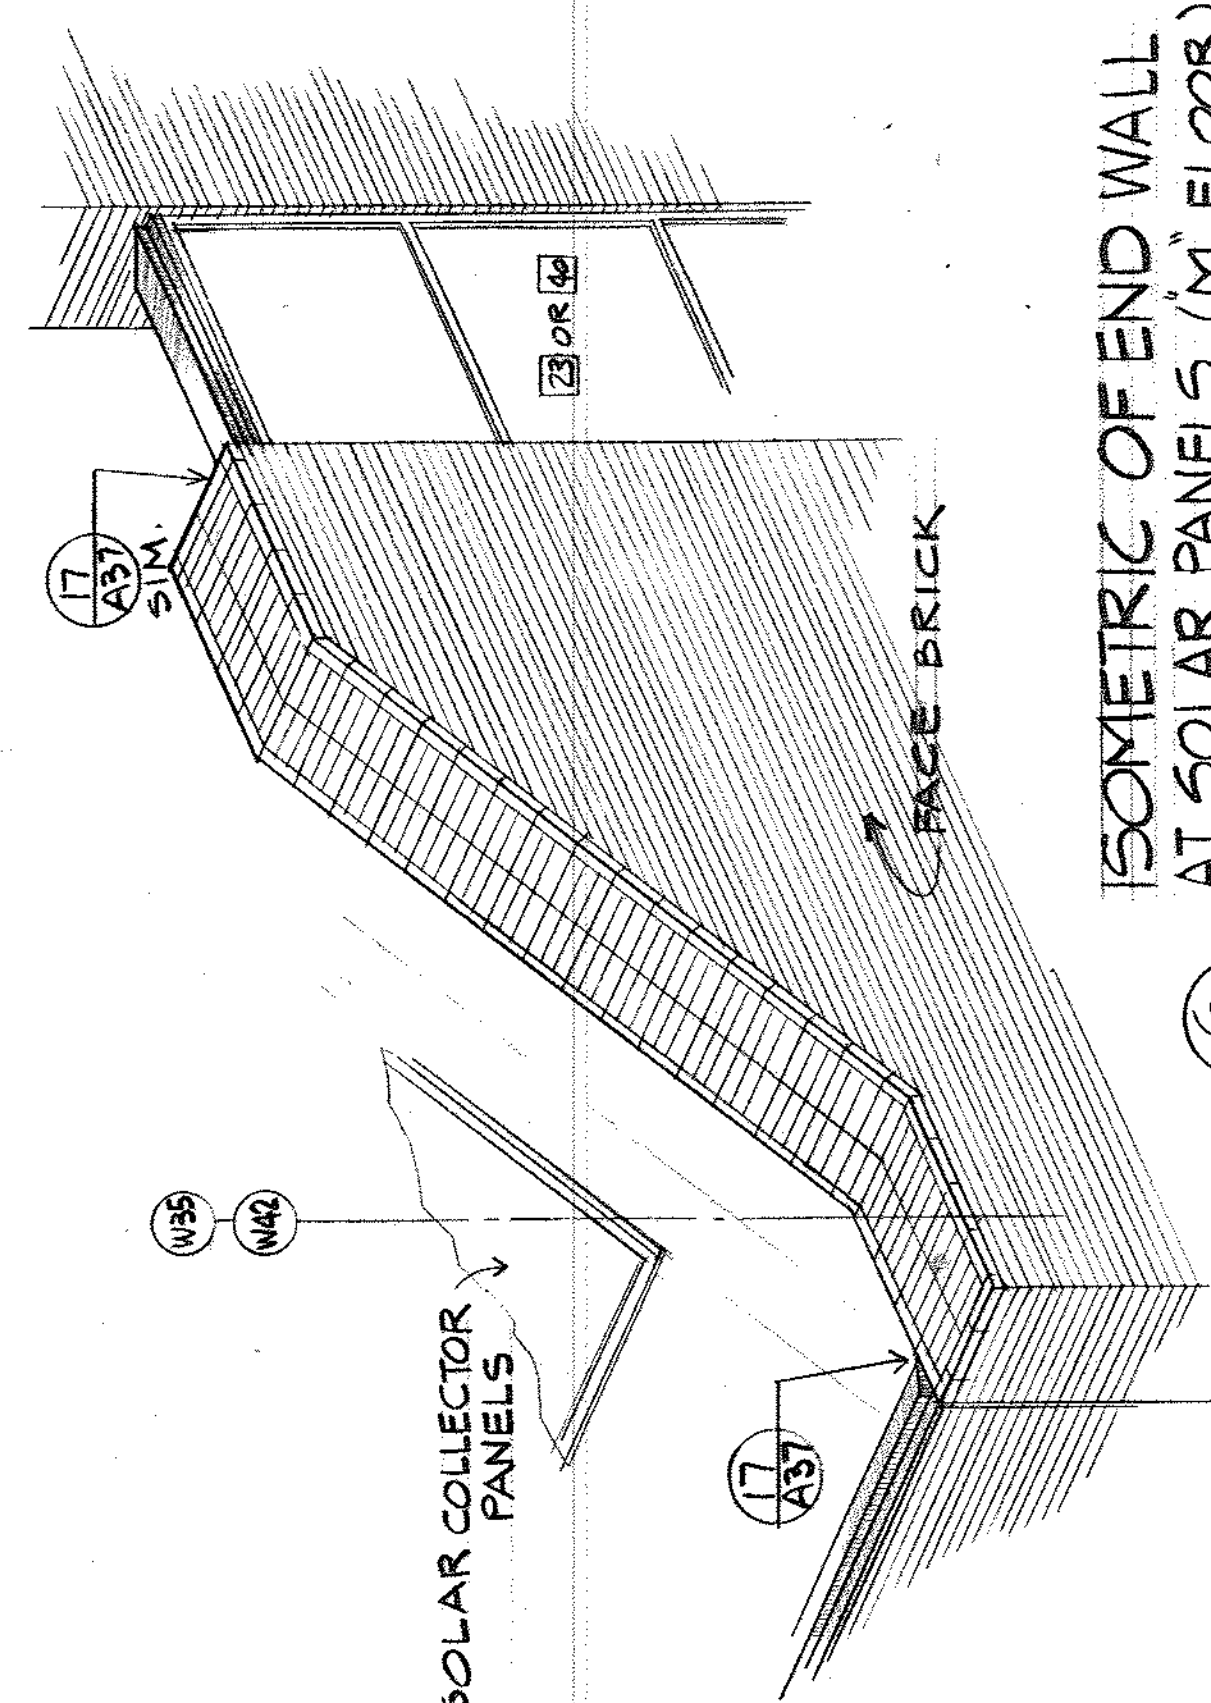

NOTE: ONLY WORK REQUIRED UNDER CONTRACT N 62467-81-C-2618  
WORK ORDER NO. 11, DEC. 1981, ARE THE INDICATED SOLD-  
ER WORK FOR THE WINDOWS.

[illegible]

# A20