


Room No	Room Name	Floor		Base		Wall		Ceiling		Notes	Area
		Mat.	Finish	Mat.	Finish	Mat.	Finish	Mat.	Finish		
B104	H.A.C.	CONC	WSF	INT6	GWB	EP-1	EP-1	EP-1	EP-1	NI, N4	70 SF
B105	CLEAN SUPPLIES STOR.	CONC	WSF	INT6	GWB	EP-1	EP-1	EP-1	EP-1	NI	106 SF
B106	RADIOLOGY CORRIDOR	CONC	WSF	INT6	GWB	WC-4	WC-3	WC-4	WC-4	NI	367 SF
B107	DRS VIEWING	CONC	WSF	INT6	GWB	EP-7	EP-7	EP-5	AT-1GWB	NI	349 SF
B107A	SHARED DRS VIEW	CONC	WSF	INT6	GWB	EP-7	EP-7	EP-7	AT-3GWB	NI	176 SF
B107C	DRS VIEW	CONC	WSF	INT6	GWB	EP-7	EP-7	EP-5	AT-3GWB	NI	67 SF
B107D	DRS VIEW	CONC	WSF	INT6	GWB	EP-7	EP-7	EP-5	AT-3GWB	NI	70 SF
B107E	DRS VIEW	CONC	WSF	INT6	GWB	EP-7	EP-7	EP-5	AT-3GWB	NI	68 SF
B108	CT SCAN ROOM	CONC	WSF	INT6	GWB	EP-5.7	EP-5.7	EP-5.7	AT-3GWB	NI, N7	567 SF
B108A	CT CONTROL	CONC	WSF	INT6	GWB	EP-7	EP-7	EP-7	AT-3GWB	NI	177 SF
B109	PAT. INTERVIEW	CONC	RSF	RB4	GWB	WC-4	WC-3	WC-3	AT-1	NI, N3, N8	90 SF
B110	STAFF WORK	CONC	RSF	RB4	GWB	WC-4	WC-4	WC-4	AT-1GWB	NI, N3, N5, N6, N8	96 SF
B112A	WAITING	CONC	RSF	RB4	GWB	WC-4	WC-4	WC-3	AT-1GWB	NI, N3, N5, N6, N8	217 SF
B116	PUBLIC CORRIDOR	CONC	RSF	RB4	GWB	WC-4	WC-4	WC-4	AT-1GWB	NI	1127 SF
B116A	IMAGING ENTRY	CONC	VCT	SSB-6	GWB	WD-1	WD-1	WC-4	AT-1GWB	AMEND 0002	545 SF
B128	SOILED UTILITY	CONC	WSF	INT6	GWB	EP-1	EP-1	EP-1	GWB	NI	113 SF
B129	CLEAN LINES	CONC	WSF	INT6	GWB	EP-1	EP-1	EP-1	AT-3	NI	80 SF
B130	PAT. TLT.	CONC	CT-1	SSC-1	GWB	CT-1.2	CT-1.2	CT-1.2	CT-1.2	NI	59 SF
B131	PAT. TLT.	CONC	CT-1	SSC-1	GWB	CT-1.2	CT-1.2	CT-1.2	GWB	NI	67 SF
B132A	CONTROL	CONC	WSF	INT6	GWB	EP-7.2	EP-7.2	EP-7.2	AT-3	N7	280 SF
B133	PAT. INTERVIEW	CONC	WSF	INT6	GWB	EP-8.2	EP-8.2	EP-7.2	AT-3	N7	48 SF
B134	ADMIN.	CONC	CPT	RB4	GWB	WC-4	WC-3	WC-3	AT-1	N1	76 SF
B135	STAFF WORK	CONC	RSF	INT6	GWB	P-3	P-3	P-3	AT-1	NI	193 SF
B136	R/F EXAM ROOM	CONC	WSF	INT6	GWB	EP-7.2	EP-7.2	EP-7.2	AT-3	NI	307 SF
B136A	CONTROL	CONC	WSF	INT6	GWB	EP-7.2	EP-7.2	EP-7.2	AT-3	N7	65 SF
B136B	PAT. TLT.	CONC	CT-1	SSC-1	GWB	CT-1.2	CT-1.2	CT-1.2	GWB	NI	43 SF
B137	OFFICE	CONC	CPT	RB4	GWB	P-3	P-3	P-1	AT-1	NI	124 SF
B138	OFFICE	CONC	CPT	RB4	GWB	P-3	P-3	P-1	AT-1	NI	88 SF
B139	RAD. EXAM ROOM	CONC	WSF	INT6	GWB	EP-7.2	EP-7.2	EP-7.2	AT-3	N7	266 SF
B139A	CONTROL	CONC	WSF	INT6	GWB	EP-8.2	EP-7.2	EP-7.2	AT-3	N7	48 SF
B143	STAFF TLT	CONC	EXIST	EXIST	GWB	EXIST	EXIST	EXIST	GWB	NI	54 SF
B144	STAFF LOUNGE	CONC	VCT	RB4	GWB	P-3	P-1	P-3	AT-1	NI	148 SF
B144A	EXIST ELECTRICAL	CONC	EXIST	EXIST	GWB	P-3	P-3	P-3	AT-1	NI	42 SF
B144B	LOOKER RM	CONC	VCT	RB4	GWB	P-6	P-1	P-6	AT-2	NI	102 SF
B145	CARDIOLOGY WAITING	CONC	RSF	RB4	GWB	P-1	P-1	P-1	AT-2	NI	137 SF
B146	BONE DENSITY	CONC	WSF	INT6	GWB	WC-3	WC-3	WC-3	AT-3	NI	135 SF
B147	CORRIDOR	CONC	VCT	RB4	GWB	P4	P4	P4	WD-S	NI	645 SF
B148	DRESS	CONC	WSF	INT6	GWB	P-3	P-3	P-3	AT-3	NI	44 SF
B149	ELECT	CONC	VCT-3	RB4	GWB	P-1	P-1	P-1	GWB	NI	118 SF
B152	ULTRA-SOUND	CONC	WSF	INT6	GWB	WC-3	WC-3	WC-3	AT-3	N2	186 SF
B152A	PAT. TLT	CONC	CT-1	SSC-1	GWB	CT-1.2	CT-1.2	CT-1.2	GWB	NI	52 SF
B154	SUB-WAIT	CONC	WSF	INT6	GWB	WC-4	WC-4	WC-4	AT-3GWB	NI, N6	59 SF
B160	ULTRA-SOUND	CONC	WSF	INT6	GWB	WC-3	WC-3	WC-3	AT-3	N2	171 SF
B160A	PAT. TLT	CONC	CT-1	SSC-1	GWB	CT-1.2	CT-1.2	CT-1.2	GWB	NI	52 SF
B164	DRESS	CONC	RSF	INT6	GWB	P-3	P-3	P-5	AT-3	NI	48 SF
B165	PAT. TLT	CONC	CT-1	SSC-1	GWB	CT-1.2	CT-1.2	CT-1.2	GWB	NI	47 SF
B166	CHEST ROOM	CONC	WSF	INT6	GWB	EP-2	EP-2	EP-2	AT-3	N7, N2	231 SF
B166A	CONTROL	CONC	WSF	INT6	GWB	EP-2	EP-2	EP-2	AT-3	N7	58 SF
B167	CORRIDOR	CONC	WSF	INT6	GWB	WC-3	WC-4	WC-4	AT-3GWB	NI, N6	1438 SF
B167A	CRASH CART	ALCOVE	CONC	WSF	INT6	WC-3	WC-3	WC-3	GWB	NI	10 SF
B167B	CRASH CART	ALCOVE	CONC	WSF	INT6	WC-3	WC-3	WC-3	GWB	NI	12 SF
B167C	GOWNED WAIT	CONC	RSF	INT6	GWB	WC-4	WC-4	WC-4	AT-3GWB	NI	196 SF
B168	HALL	CONC	WSF	INT6	GWB	WC	WC	WC	AT-3	NI	122 SF
B169	HALL	CONC	WSF	INT6	GWB	WC	WC	WC	AT-3	NI	88 SF
B170	DRESS	CONC	WSF	INT6	GWB	P-3	P-6	P-3	AT-3	NI	39 SF
B172	PATIENT PREP	CONC	WSF	INT6	GWB	WC-2	WC-2	WC-2	AT-3GWB	NI	65 SF
B173	NURSE WORK	CONC	WSF	INT6	GWB	WC-2	WC-2	WC-2	AT-3	NI	60 SF
B174	DRESS	CONC	WSF	INT6	GWB	P-3	P-6	P-3	AT-3	NI	39 SF
B175	PRE-POST HOLDING	CONC	WSF	INT6	GWB	WC-4	WC-4	WC-4	AT-3GWB	NI, N2	507 SF
B175A	PAT. TOILET	CONC	CT-1	SSC-1	GWB	CT-1.2	CT-1.2	CT-1.2	GWB	NI	45 SF
B176	IR PROCEDURE ROOM	CONC	WSF	INT6	GWB	EP-7.6	EP-7.6	EP-7.6	AT-3	N7	891 SF
B176A	DRS VIEWING ROOM	CONC	WSF	INT6	GWB	EP-7	EP-7	EP-5	AT-3	NI	58 SF
B176B	IR CONTROL	CONC	WSF	INT6	GWB	EP-7	EP-7	EP-7	AT-3	NI	281 SF
B176C	SCRUB/GOWN	CONC	WSF	INT6	GWB	EP-7	EP-7	EP-5	AT-3	NI	76 SF
B176D	VENDOR EQ.	CONC	WSF	INT6	GWB	EP-7	EP-7	EP-5	AT-3	NI	27 SF
B179	PAT. TLT.	CONC	CT-1	SSC-1	GWB	CT-1.2	CT-1.2	CT-1.2	GWB	NI	45 SF
C112	EQUIPMENT ROOM	CONC	CT-1	SSC-1	GWB	CT-1.2	CT-1.2	CT-1.2	GWB	NI	437 SF

FINISH SCHEDULE NOTES:

- NOTE 1: SEE FLOOR FINISH PLAN FOR PATTERN.
- NOTE 2: CUBICLE CURTAIN, SEE REFLECTED CEILING PLAN
- NOTE 3: EXTERIOR WINDOW ROOM #B109, B110 AND B112 TO RECEIVE ROLLER SHADE, RE: SEPC SECTION 12.49
- NOTE 4: SEE REFLECTED CEILING PLAN.
- NOTE 5: PAINT UNDERSIDE OF SOFFIT P-4 (WHITE), PAINT VERTICAL FACE OF SOFFIT P-5 (GREEN).
- NOTE 6: PAINT UNDERSIDE OF SOFFIT P-4 (WHITE), PAINT VERTICAL FACE OF SOFFIT P-3 (TAN).
- NOTE 7: WALL FINISH: THE FIRST PAINT NUMBER IS THE FIELD COLOR, THE NEXT PAINT NUMBER IS THE ACCENT BAND FROM TOP OF DOOR FRAME TO CEILING.
- NOTE 8: SEE ELEVATIONS
- NOTE 9: SOLID SURFACE WINDOW SILL (OS-1)

GENERAL FINISH NOTES

- 1. ALL INTERIOR HOLLOW METAL FRAMES/ DOORS TO BE PAINED AP-1.
- 2. NEW ACoustICAL CEILING TILE (AT-6) IN BASEMENT AS INDICATED ON SHEET AS2002.

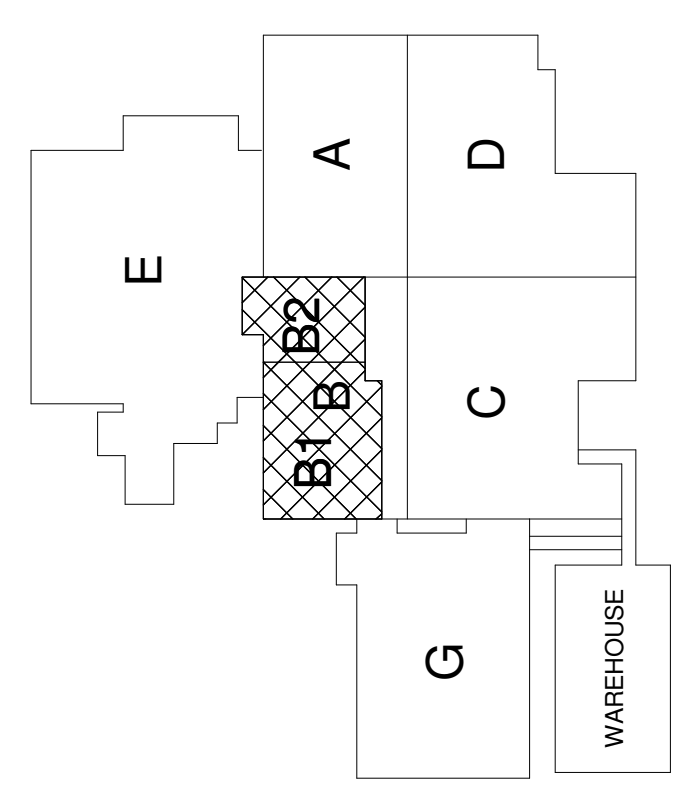

FULLY SPRINKLERED

Project Number: 599-999
 Building Number: 1
 Drawing Number: AS903

Location: COLUMBIA, MISSOURI
 Date: 07/29/09

Checked: JCG
 Drawn: CF

Department of Veterans Affairs






ARCHITECT/ENGINEERS/COST ESTIMATORS:

ELLERBE BECKETT

2380 McGee Street,
 Suite 200
 Kansas City, MO 64108
 816 561 4443

Ellebe Beckett, Inc.
 Ellebe Beckett Architects
 and Engineers, Inc.
 Ellebe Beckett Architects
 and Engineers

2009

