


1587 20 TP

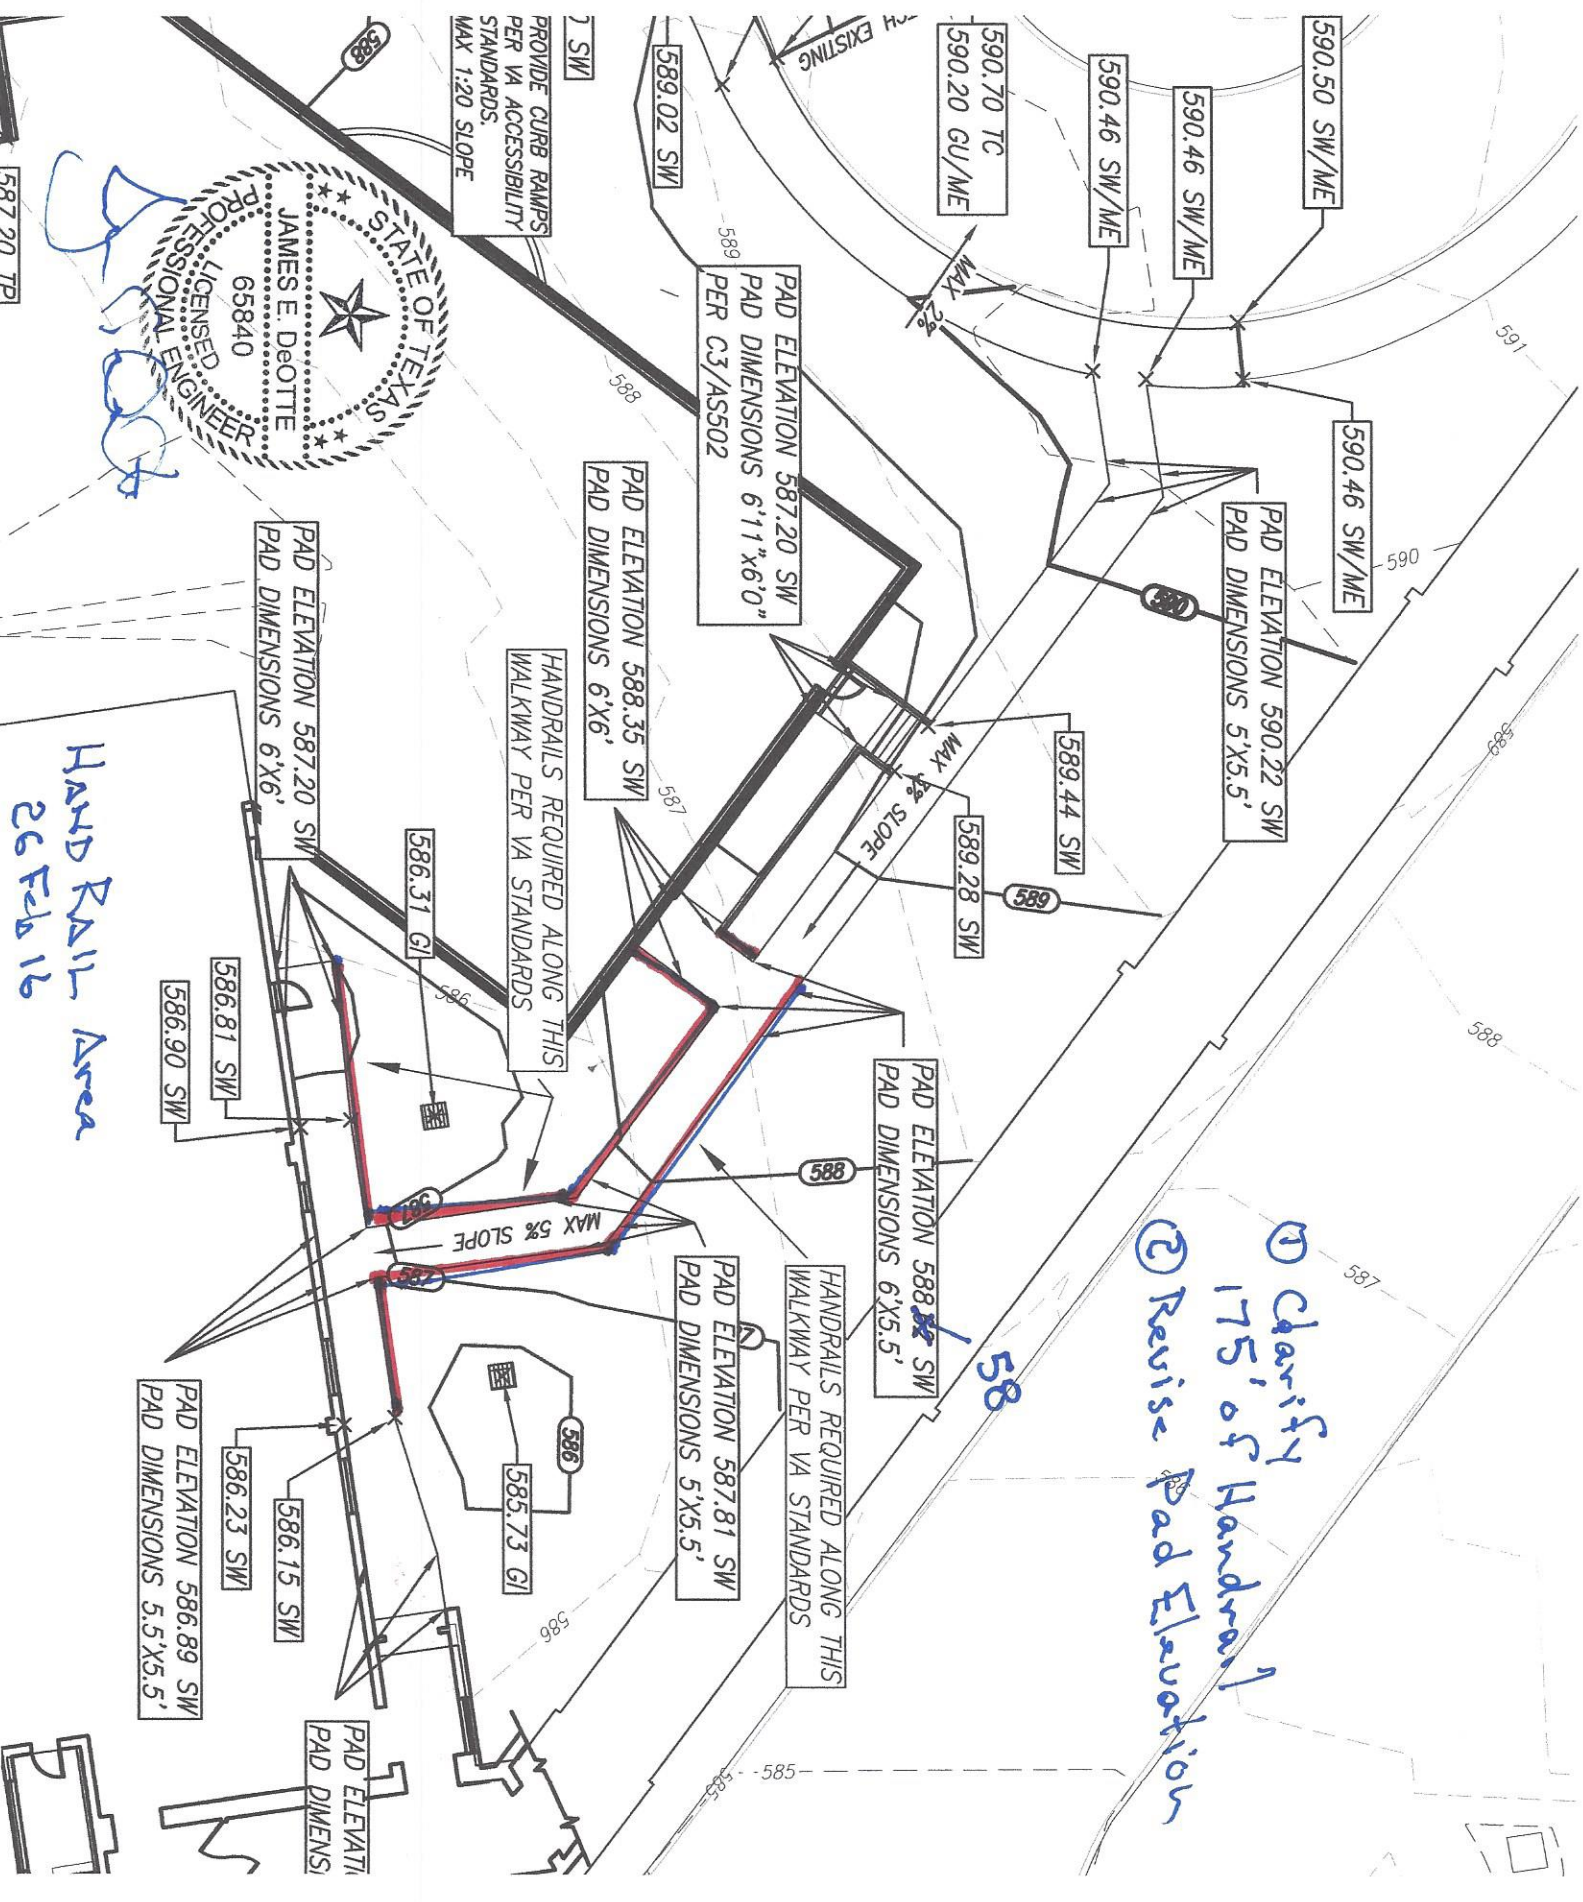

Hand Rail Area
26 Feb 16



① Clarify 175' of Handrail
② Revise Pad Elevation

