


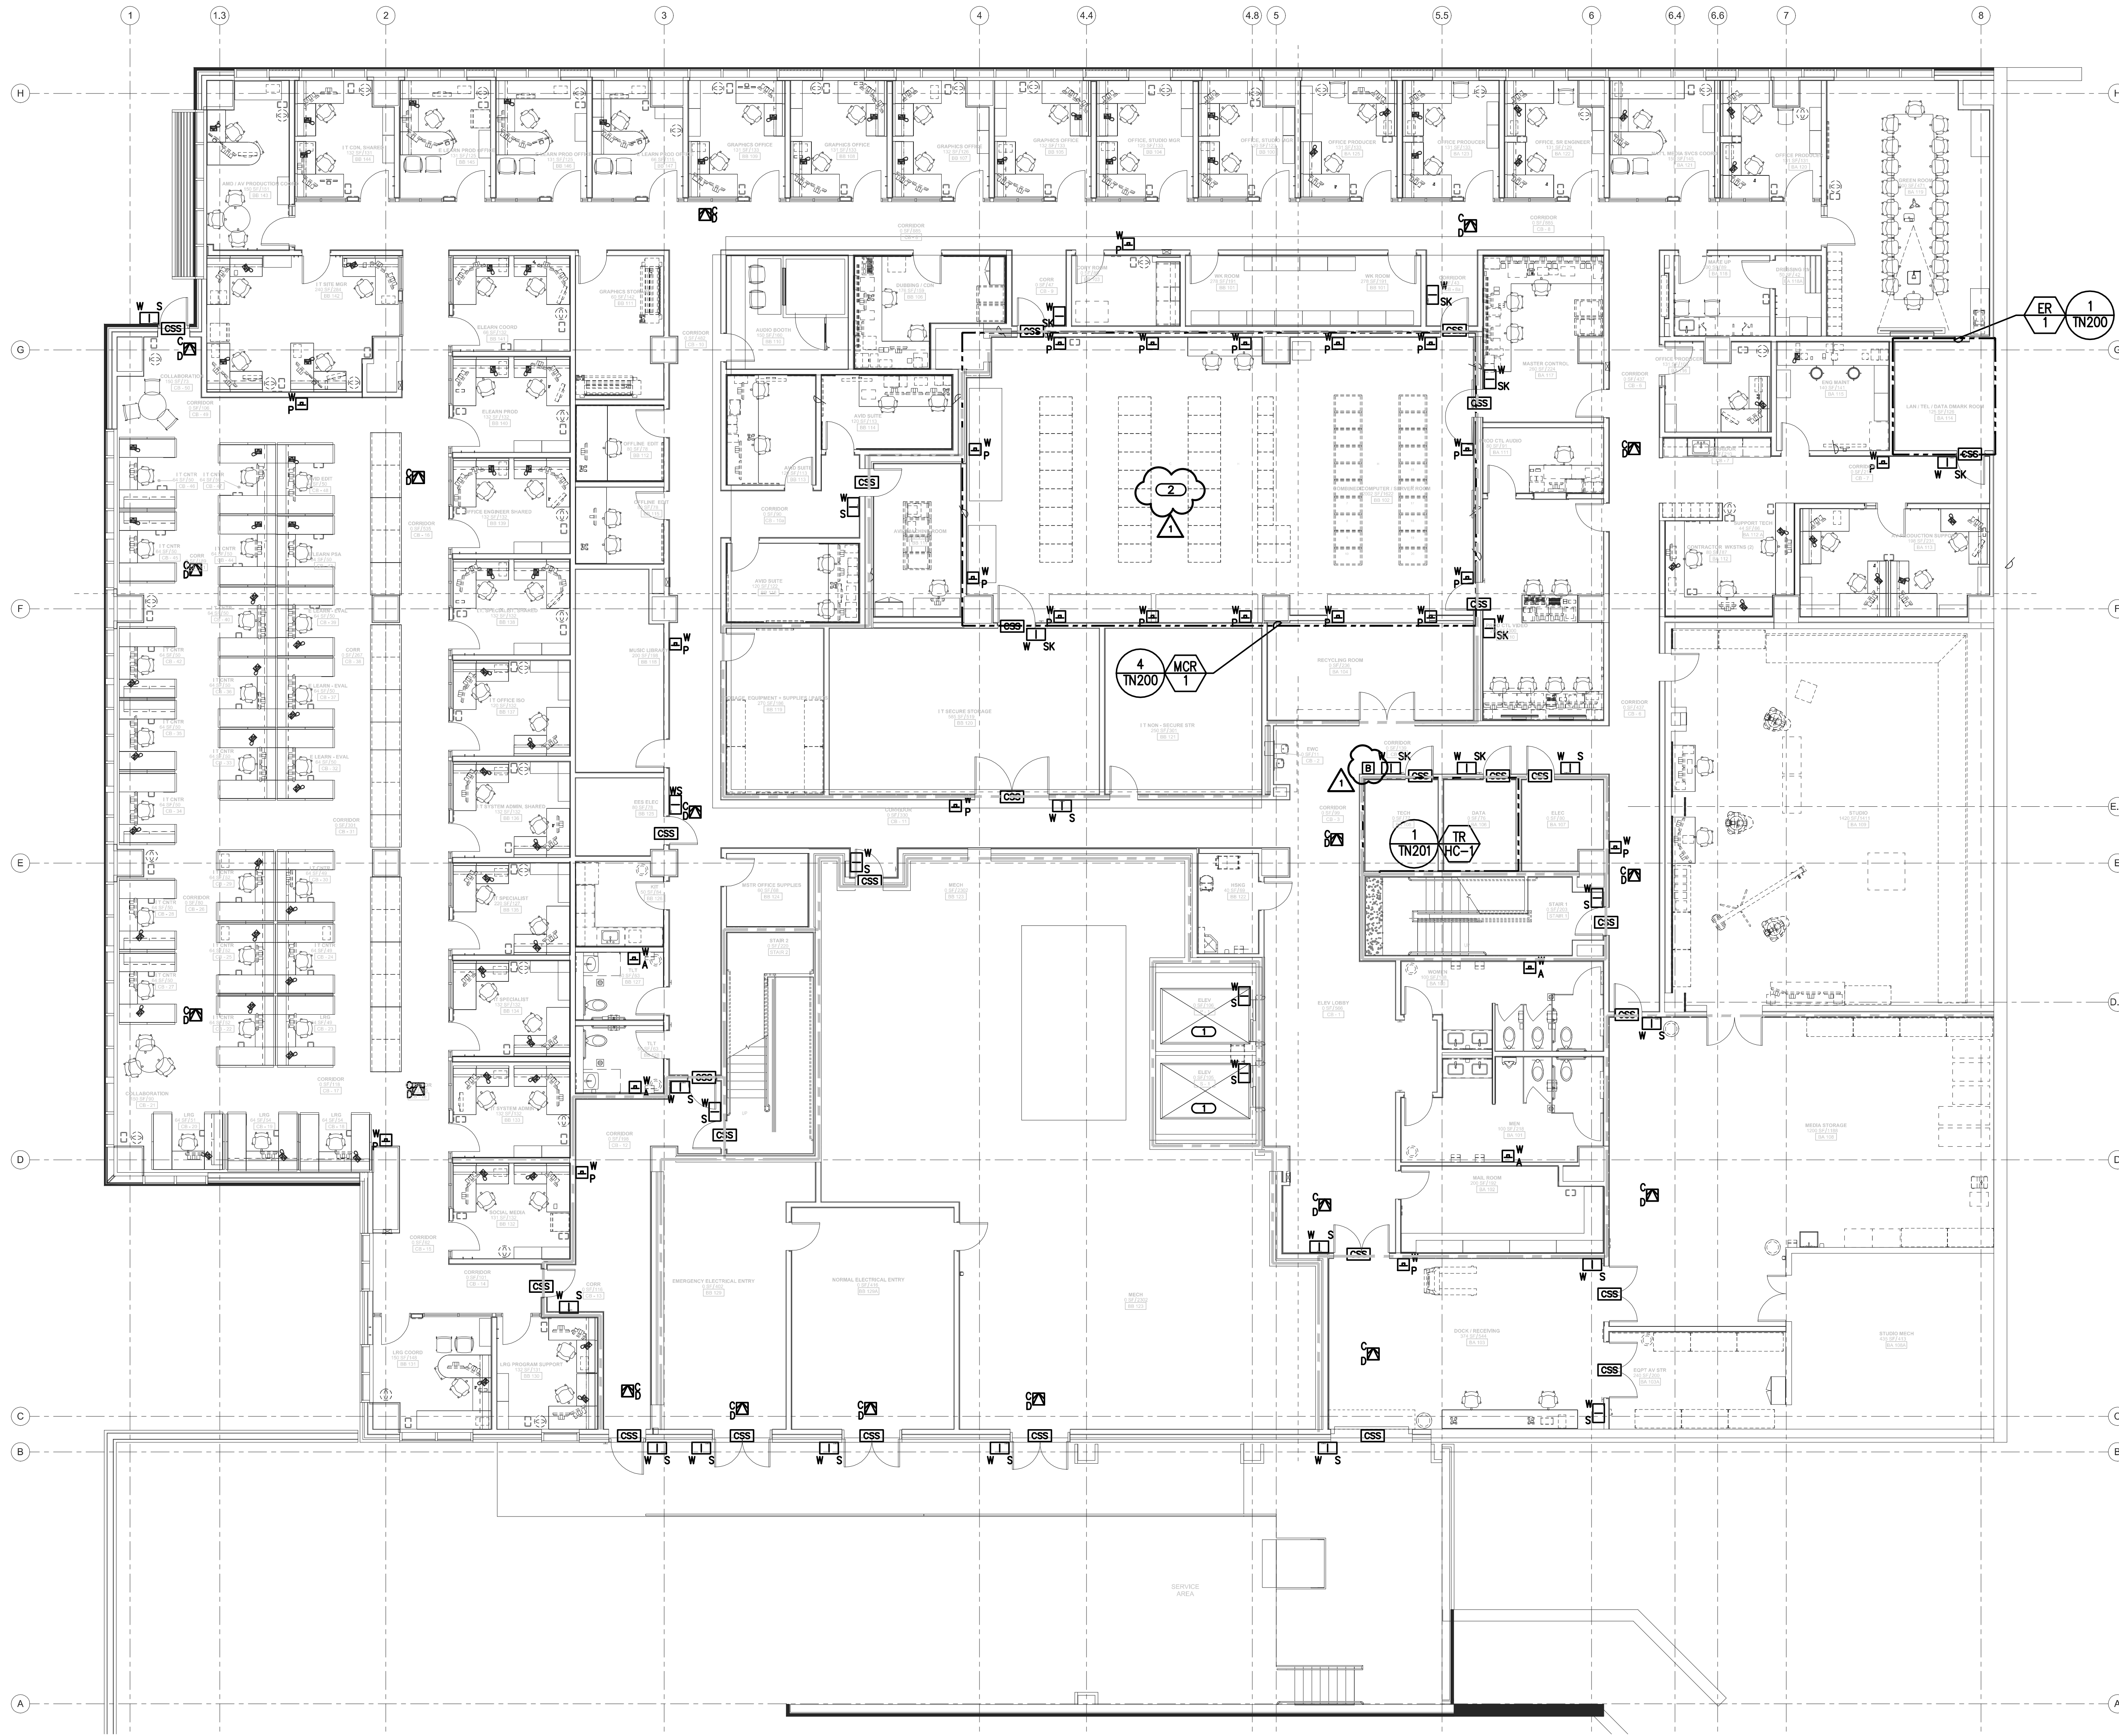

1 LEVEL B FLOOR PLAN - SECURITY - TECHNOLOGY
SCALE: 1/8" = 1'-0"

- GENERAL SHEET NOTES**
1. REFER TO 2/TN400 FOR ACCESS CONTROL RISER DIAGRAM.
 2. REFER TO 3/TN400 FOR DOOR ROUGH-IN DETAIL.
 3. REFER TO TN500 FOR ACCESS CONTROL DOOR SCHEDULE.
 4. REFER TO 4/TN300 FOR TECHNOLOGY ROUGH-IN MOUNTING DETAIL.
 5. REFER TO 5/TN300 FOR FIRE RATED CABLE PATHWAY DETAIL.
 6. CABLING FOR SECURITY DEVICES SHALL BE ROUTED TO BA106.
- KEYNOTES**
1. CARD READER TO BE MOUNTED IN ELEVATOR CAB. REFER TO TN500 FOR DOOR SCHEDULE.
 2. COORDINATE LOCATIONS OF WALL MOUNT PANIC BUTTONS WITH OTHER DISCIPLINES PRIOR TO INSTALLATION.

#1	Date	Revisions
1	April 4, 2013	Amendment 4

CONSULTANTS:

STRUCTURAL ENGINEER:
KPPF CONSULTING ENGINEERS
1630 DES PERES ROAD, SUITE 100
ST. LOUIS, MO 63131
PHONE: (314) 635-0524

MECHANICAL/ELECTRICAL/PLUMBING:
KJWW ENGINEERING CONSULTANTS
415 SUMNER DRIVE, SUITE 104
ST. LOUIS, MO 63143
PHONE: (314) 645-1132

CODE CONSULTANT/FIRE PROTECTION:
STOCK & ASSOCIATES CONSULTING ENGINEERS, INC.
257 CHESTERFIELD BUSINESS PARKWAY
CHESTERFIELD, MO 63005
PHONE: (636) 530-9100


CIVIL ENGINEER:
STOCK & ASSOCIATES CONSULTING ENGINEERS, INC.
257 CHESTERFIELD BUSINESS PARKWAY
CHESTERFIELD, MO 63005
PHONE: (636) 530-9100

AUTOMATIC TRANSPORT:
LERCH BATES INC.
8088 S LINCOLN STREET, SUITE 207
LITTLETON, CO 80122
PHONE: (720) 283-8182

ESTIMATING:
KIWAME BUILDING GROUP, INC.
1204 WASHINGTON AVENUE, SUITE 200
ST. LOUIS, MO 63103
PHONE: (314) 962-5344

HAZARDOUS MATERIALS:
ALTEC ENVIRONMENTAL CONSULTING, LLC
P.O. BOX 17867
SHREVEPORT, LA 71138-0867
PHONE: (318) 687-3771

IRRIGATION CONSULTANTS:
IRM
9502 BAYVIEW TREE
ST. LOUIS, MO 63103
PHONE: (318) 843-1481

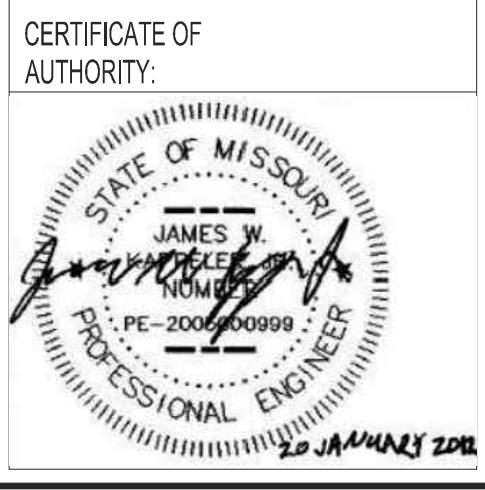

ARCHITECT/ENGINEERS:

CHRISTNER

ARCHITECTS | DESIGNERS | PLANNERS | LANDSCAPE ARCHITECTS

168 N. MERAMEC AVENUE | ST. LOUIS, MISSOURI 63105
TEL 314 725 2927 | FAX 314 725 2928 | CHRISTNERINC.COM

THE SEAL (S) AND SIGNATURE(S) APPLY ONLY TO THE DOCUMENT TO WHICH THEY ARE AFFIXED, AND WE EXPRESSLY DISCLAIM ANY RESPONSIBILITY FOR ALL OTHER PLANS, SPECIFICATIONS, ESTIMATES, REPORTS, OR OTHER DOCUMENTS OR INSTRUMENTS RELATING TO OR INTRUDE TO BE USED FOR ANY PART OF PARTS OF THE PROJECT.
© COPYRIGHT 2012 CHRISTNER INC.

Drawing Title
LEVEL B FLOOR PLAN - SECURITY - TECHNOLOGY

Approved: Project Director
John Sanders

Project Title
TENANT BUILDING

Location
JEFFERSON BARRACKS DIVISION

Date
29 OCTOBER 2012

Checked
DARHAR

Drawn
KEIEVE

Project Number
657-313D

Building Number
56

Drawing Number
TY100

Dwg. 114 of 153

Office of
Construction
and Facilities
Management

Department of
Veterans Affairs

FULLY SPRINKLERED