


1 CLC - FIRST FLOOR PLAN

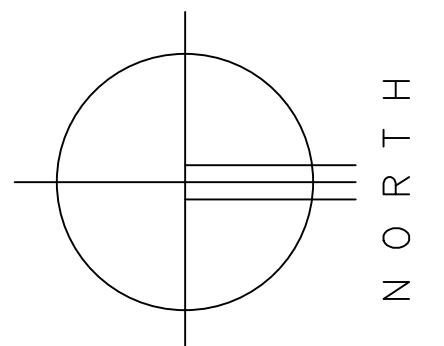

DRAWING TITLE COMMUNITY LIVING CTR. FIRST FLOOR	PROJECT TITLE AS-BUILT FLOOR PLAN			DATE
				PROJECT NO.
	BUILDING NO. 30	CHECKED HC	DRAWN KC/JV	DRAWING NO.
	LOCATION VAMC PHILADELPHIA			Dwg. _____ Of _____

VETERANS
AFFAIRS