

GROUND FLOOR
1/8" = 1'-0"

DOOR SIZES									
MK	WIDTH		HEIGHT		MK	WIDTH		HEIGHT	
	IN	[mm]	IN	[mm]		IN	[mm]	IN	[mm]
A	1'-6"	[457]	6'-8"	[2032]	N	2'-0"	[610]	7'-0"	[2134]
B	2'-0"	[610]	6'-8"	[2032]	O	2'-2"	[660]	7'-0"	[2134]
C	2'-2"	[660]	6'-8"	[2032]	P	2'-4"	[711]	7'-0"	[2134]
D	2'-4"	[711]	6'-8"	[2032]	Q	2'-6"	[762]	7'-0"	[2134]
E	2'-6"	[762]	6'-8"	[2032]	R	2'-8"	[813]	7'-0"	[2134]
F	2'-8"	[813]	6'-8"	[2032]	S	3'-0"	[914]	7'-0"	[2134]
G	2'-10"	[864]	6'-8"	[2032]	T	3'-4"	[1016]	7'-0"	[2134]
H	3'-0"	[914]	6'-8"	[2032]	U	3'-6"	[1067]	7'-0"	[2134]
I	3'-2"	[965]	6'-8"	[2032]	V	3'-8"	[1118]	7'-0"	[2134]
J	3'-4"	[1016]	6'-8"	[2032]	W	3'-10"	[1168]	7'-0"	[2134]
K	3'-8"	[1118]	6'-8"	[2032]	X	4'-0"	[1219]	7'-0"	[2134]
L	3'-10"	[1168]	6'-8"	[2032]	Y	3'-0"	[914]	8'-0"	[2438]
M	1'-6"	[457]	7'-8"	[2337]	Z	SEE SCHEDULE			

DOOR SYMBOL

FRAME TYPE (JAMB DETAIL)

DOOR SIZE

DOUBLE LETTERS EQUAL SIZE OF LEAF FOR PAIR OF DOORS

LEGEND (SEE ELEVATIONS)

DOOR TYPE

GLASS OR LOUVER REQUIRED BY MODIFICATION

DOOR AND FRAME RATING

GLASS OR LOUVER REQUIRED BY ELEVATION TYPE

DOOR MODIFICATIONS


A LAMINATED GLASS
ADO AUTOMATIC DOOR OPERATOR (SWING OR SLIDE)
ALK AUDIBLE ALARM (ON EGRESS)
CL STAND-ALONE CARD READER LOCK
CR CARD READER
D DOUBLE GLAZED TEMPERED GLASS
DE DELAYED EGRESS
DPS DOOR POSITION SWITCH (DOOR CONTACT)
F FIRE RATED GLAZING
H ELECTRIC HOLD OPEN
IC INTERCOM
ID INTEGRATED DOOR ASSEMBLY
IL INTERLOCKED

L LOUVER
LL LEAD-LINED DOORS
LP LIGHT PROOF LOUVER
M MECH. SEAL FOR LIGHT PROOF & SOUND RETARDING DOOR
P PANIC HARDWARE
PB STAND-ALONE PUSHBUTTON LOCK
RF RADIOFREQUENCY SHIELDED DOOR
RR REMOTE RELEASE BUTTON
STC ACOUSTIC DOOR ASSEMBLY
T TEMPERED GLASS
TL TIMER LOCK
U UNDERCUT 1" [25mm]
V LEAD GLASS

- NOTES:**
- ALL DOORS SHALL BE FLUSH - 1 3/4" [44mm] THICK UNLESS NOTED OTHERWISE.
 - TOP & SIDE RAILS SHALL BE 9" [229mm] MIN. BOTTOM RAILS SHALL BE 12" MIN. [305mm].

KEYNOTES - ARCHITECTURAL

- a1 FIRE EXTINGUISHER CABINET. REFER TO SPECIFICATION SECTION 10 44 13 AND DETAIL A1/A-553.
- a2 PROVIDE NEW CONCRETE TOPPING SLAB OVER PORTION OF EXISTING RAMP TO BRING LEVEL WITH BUILDING 1 FINISH FLOOR (553'-0"). REINSTALL HANDRAILS TO COORDINATE WITH REVISED ELEVATION.
- a3 PROVIDE NEW CONCRETE TOPPING SLAB OVER PORTION OF EXISTING RAMP AS NEEDED TO REVISE SLOPE TO BE 12" OVER 40'-0". REINSTALL HANDRAILS TO COORDINATE WITH REVISED ELEVATION.
- a4 PAINT WALL AND INSTALL FINISH WALL BASE TO MATCH ADJACENT EXISTING FINISHES TO REMAIN.

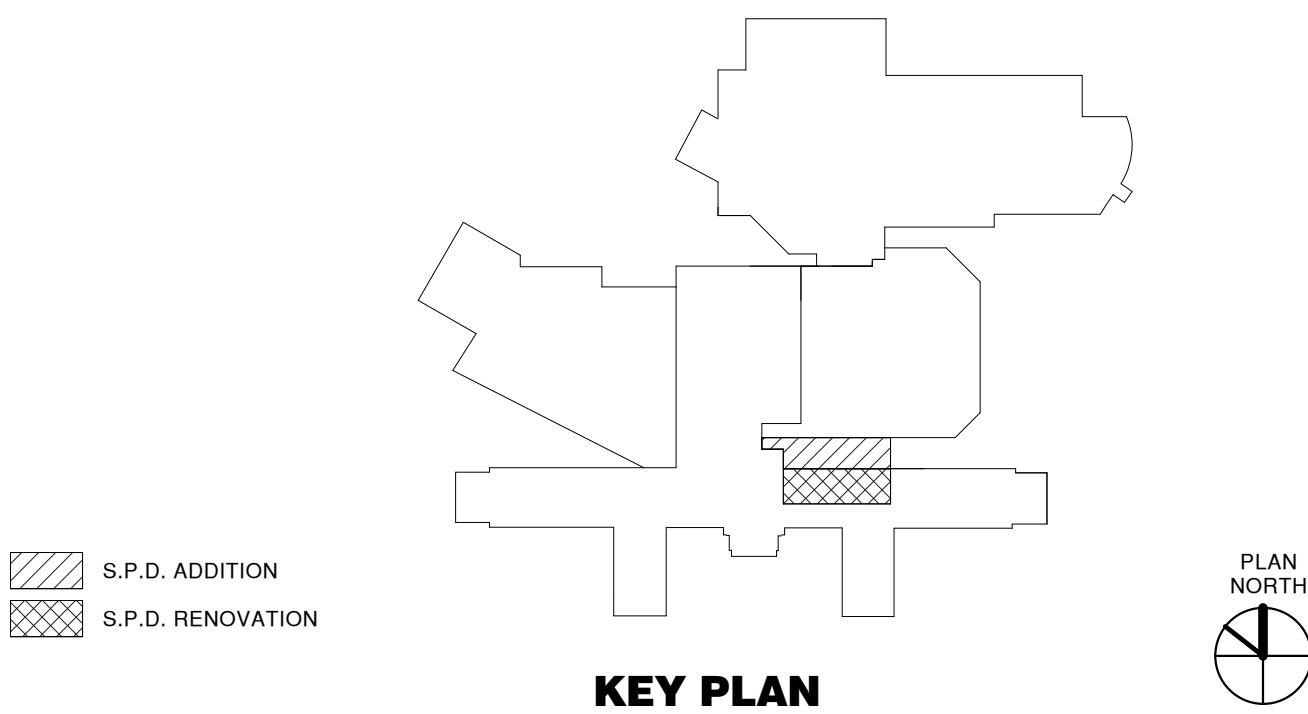

KEY PLAN

CONSTRUCTION DOCUMENT SUBMISSION
FULLY SPRINKLERED

AMENDMENT DRAWING - SUPERSEDES A-101

CONSULTANTS:		ARCHITECT/ENGINEERS:	
		HDR	
		Henningson, Durham & Richardson, P.C.	
		9987 Carver Road Suite 200 Cincinnati, Ohio 45242-5552 513.984.7500	
Revisions:		PLAN - GROUND FLOOR	
1 ADDENDUM #1		Project Title	
06-15-2011		Expand SPD Services	
Date		Building Number	
		001	
		Drawing Number	
		A-101R-R1	
		Dwg. 2 of 11	
		Office of Facilities Management	
		Department of Veterans Affairs	