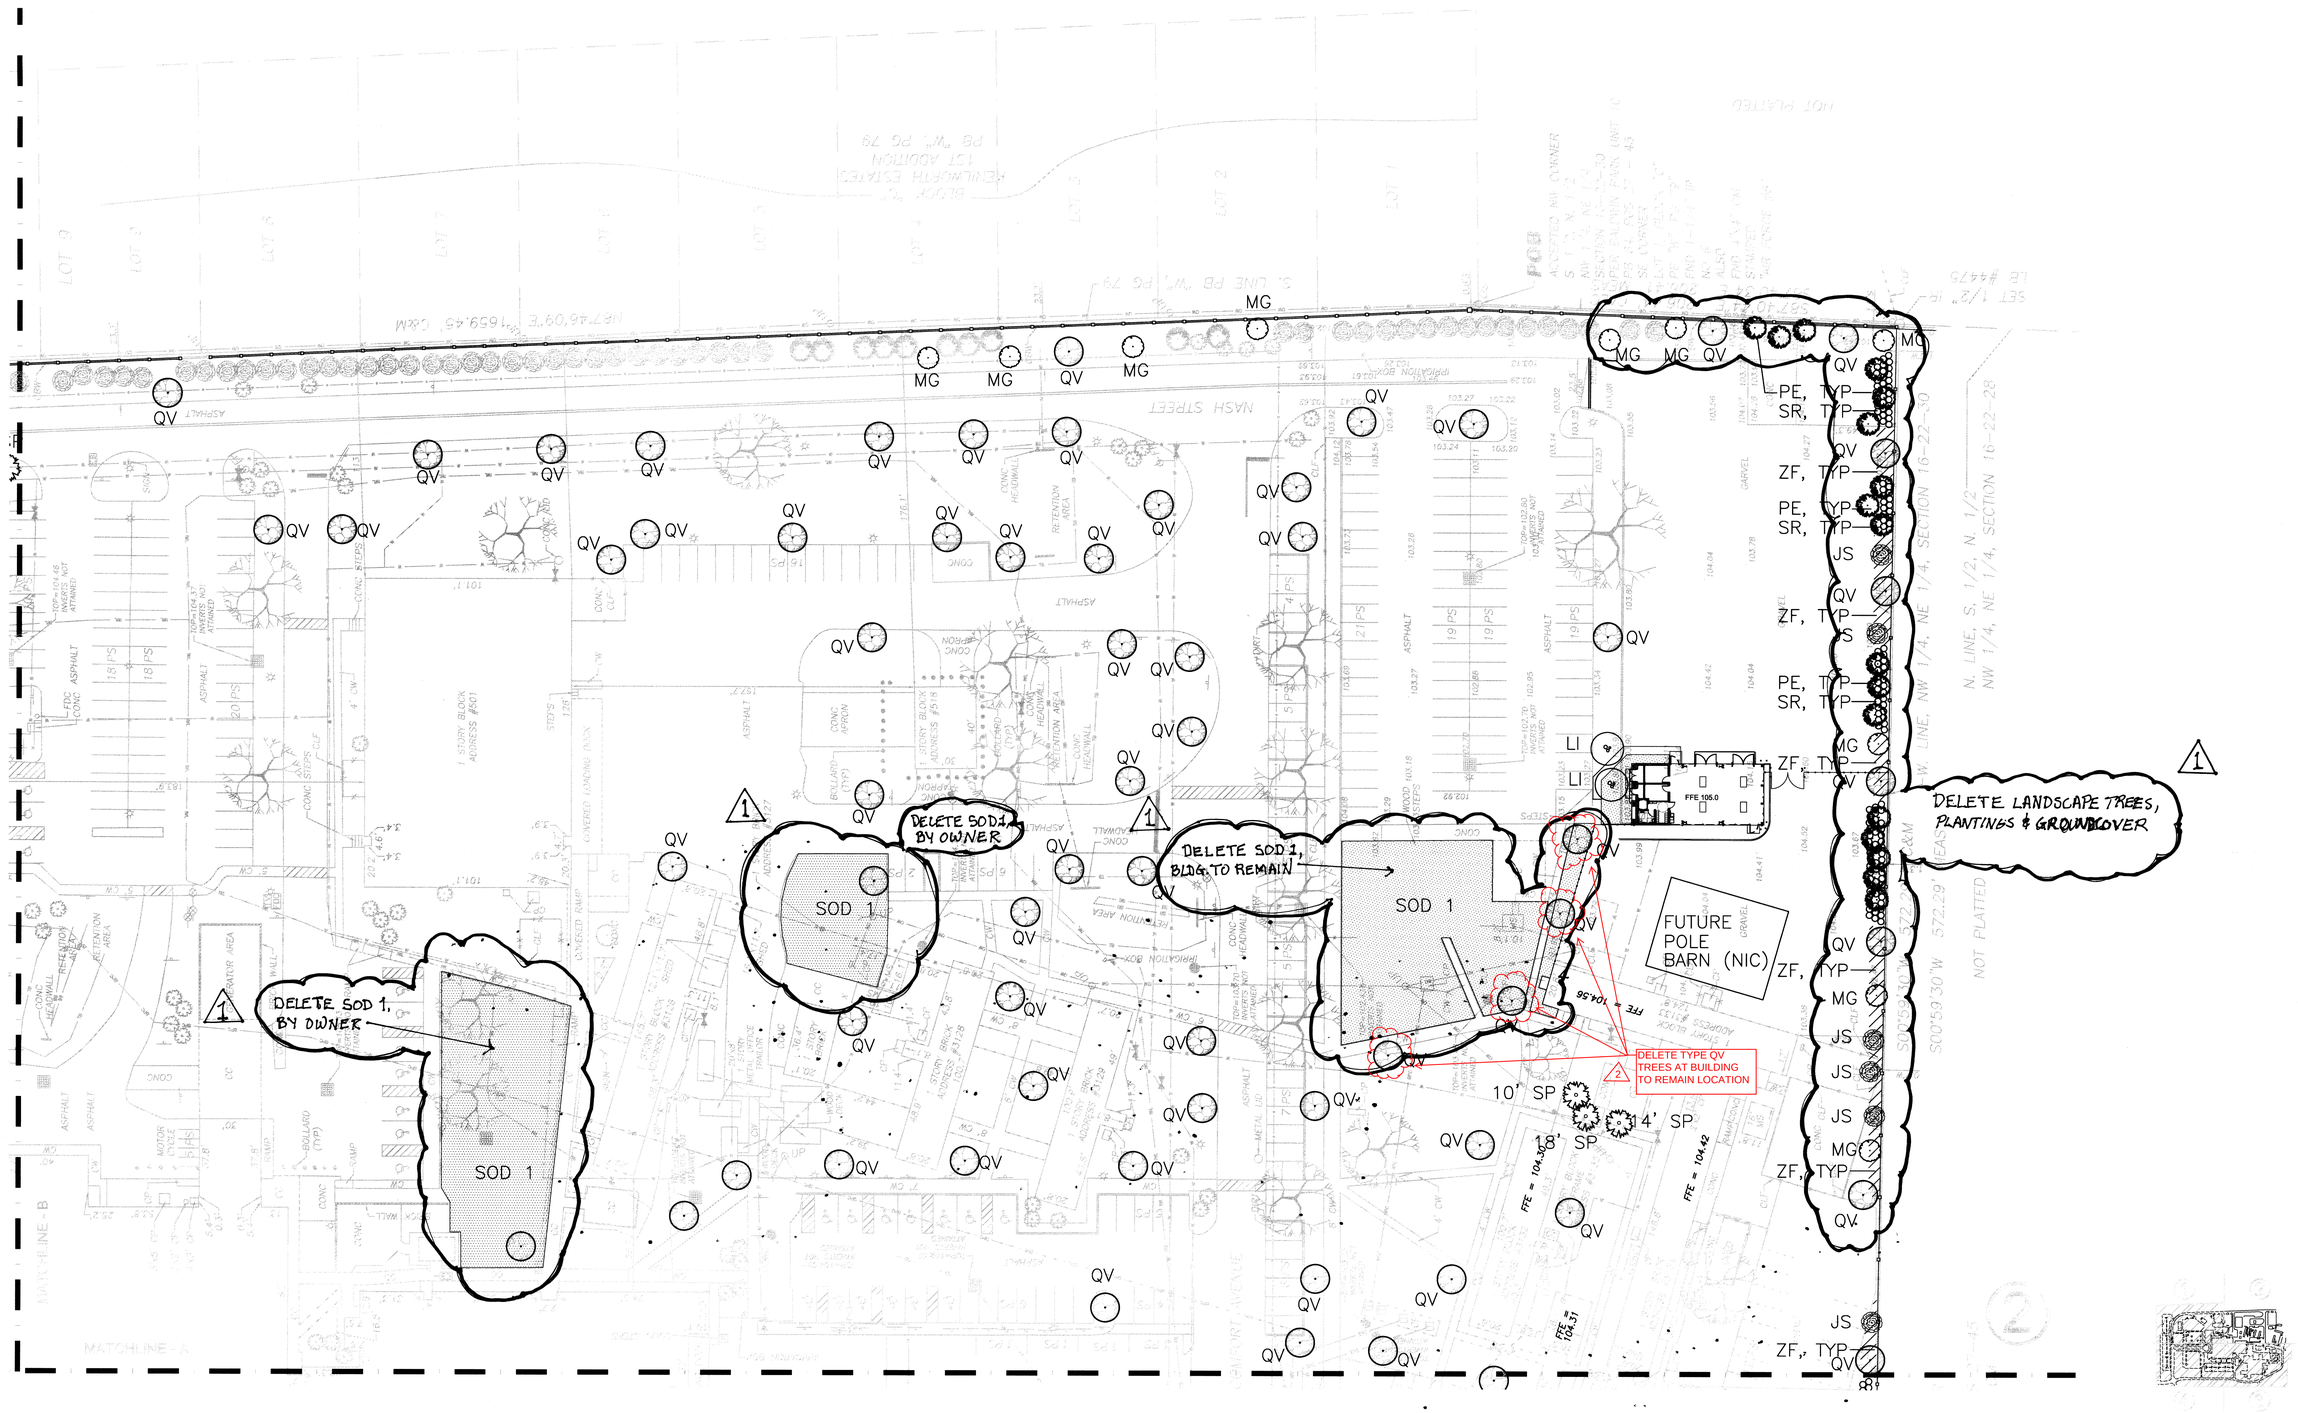

KEY PLAN

2 DELETE TREES TYPE QV WHERE INDICATED - 1 LOCATION, PLAN EAST AT REV. 1 BLDG TO REMAIN 02/26/2016

1 DELETE SOD, LANDSCAPING 02/12/16

F7 LANDSCAPE PLAN AREA 2
SCALE: 1" = 30'-0"

NORTH

0 15' 30' 60' 90' 120'
1" = 30'-0"

IF THIS DRAWING IS LESS THAN 30" X 42" IT IS A REDUCED SIZE DRAWING

Revisions	Date
XXXX	XXXX
XXX	XXX
XXX	XXX
XXX	XXX
-	-
-	-
-	-
-	-
-	-

VA FORM 08-6231

CONSULTANTS:

ENGINEERING FOR ARCHITECTURE

874 Dixon Boulevard
Cocoa, FL 32922
Phone: 321-636-0274
Fax: 321-639-8986
www.tlc-engineers.com

© Copyright 2013 TLC Engineering for Architecture, Inc.

COA #15 TLC NO: 513042

PSI
Michael Prevost, RLA
Prevost Stamper, Inc.
407.566.9009 designpsi.com

Timothy W. Coker, P.E.
Civil Engineering & Land Development
111 Sheffield Circle
Longwood, Florida
32750
Office: 407.395.2515
Cell: 407.496.1516
TWCoker@TSWeng.com

ARCHITECT/ENGINEERS:

ALLIANCE Design & Construction, Inc.
A service disabled veteran owned small business
1201 fairview avenue. winter park, fl 32789 p. 407 539 2718 f. 407 539 2041 ALLIANCE-DC.COM

Drawing Title LANDSCAPE PLAN AREA 2	**Project Title** ORLANDO VA MEDICAL CENTER IMPROVE LANDSCAPING, IRRIGATION AND RECLAIMED WATER STUDY	**Project Number** 675-13-635	Office of Construction and Facilities Management
Approved Project Director FACILITIES MAINTENANCE SERVICES	**Location** ORLANDO FL	**Building Number**	
	Date 2/28/2014 / **Checked** SANGSTER / **Drawn** MILLER	**Drawing Number** LP101	
		Dwg.9 of 43	Department of Veterans Affairs