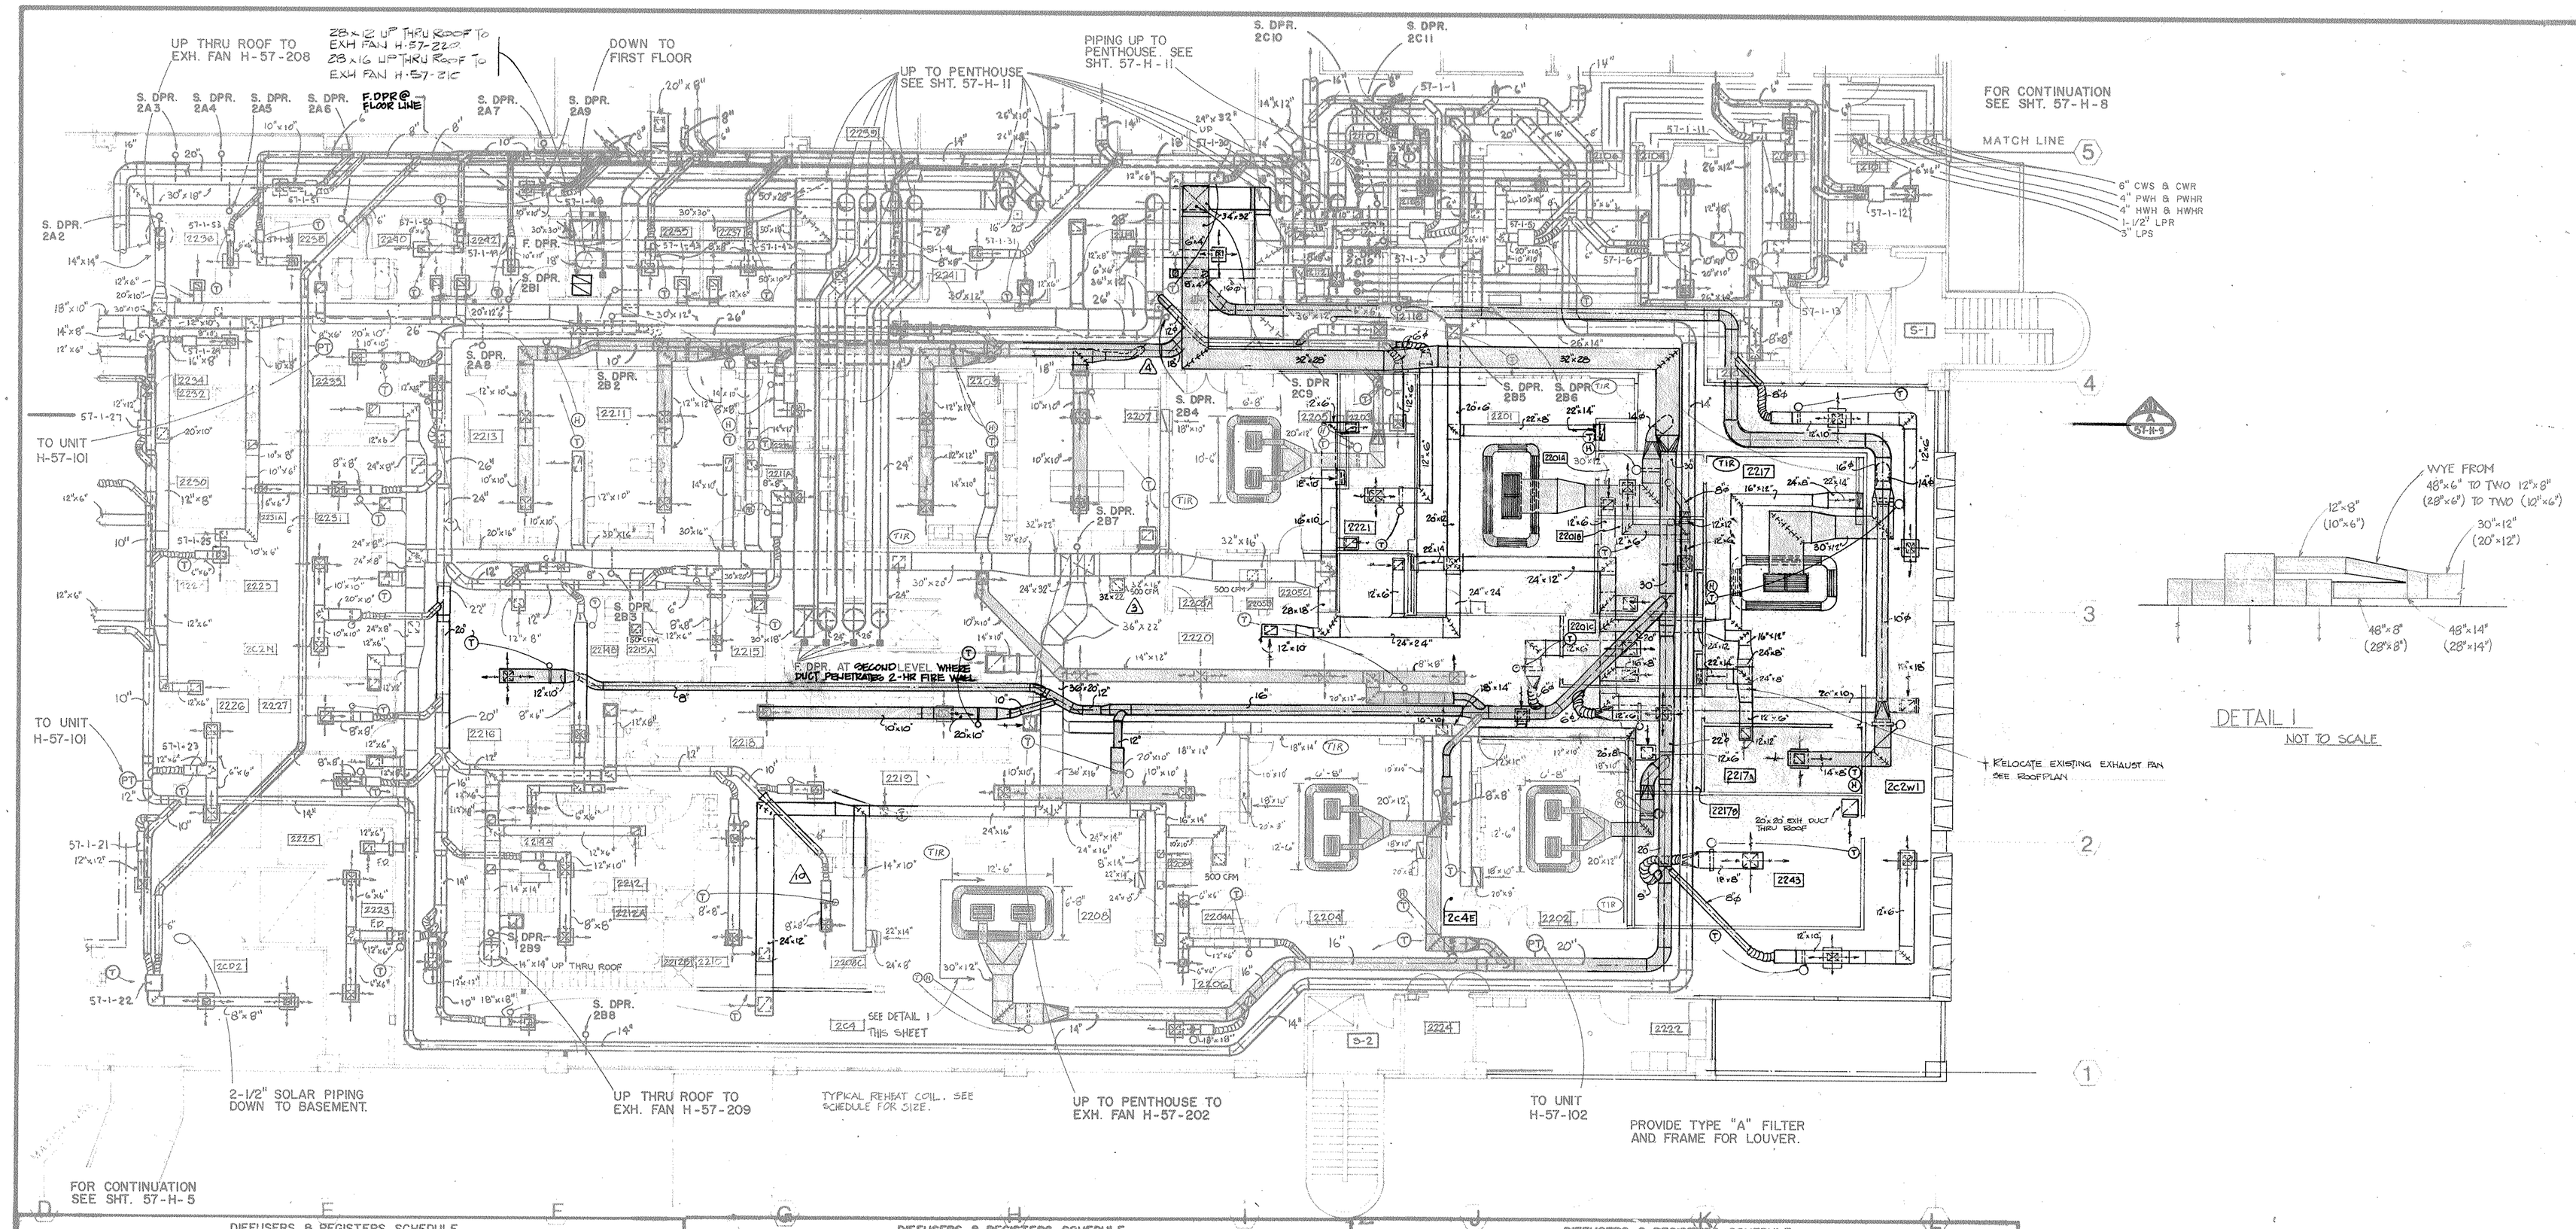

DIFFUSERS & REGISTERS SCHEDULE

ROOM NO.	ROOM NAME	SUPPLY AIR CFM	NO.	SIZE	TYPE	SYSTEM	RETURN/EXHAUST AIR CFM	R/E	NO.	SIZE	TYPE	SYSTEM
2201	OR. VASCULAR	1500	--	-------	S	H-57-102	1200	E	2	22 x 14	BW	H-57-202
2201A	X-RAY CONTROL	140	1	8 X 8	A	H-57-102	150	E	1	10 X 10	A	H-57-202
2202	OR. GENERAL	1000	--	-------	A	H-57-102	700	E	2	18 x 10	BW	H-57-202
2201B	SPEC. REC. EQUIPMENT	220	1	10 x 10	A	H-57-102	240	E	1	10 X 10	A	H-57-202
2201C	WORK ROOM	210	1	10 x 10	A	1-57-102	300	E	1	14 x 14	A	H-57-202
2217A	PUMP ROOM	270	1	10 x 10	A	1-57-102	300	E	1	12 x 12	A	H-57-202
2217B	SCRUB	140	1	8 X 8	A	H-57-102	120	E	1	10 X 10	A	H-57-202
2203	X-RAY CONTROL	160	1	8 X 8	A	H-57-102	170	E	1	10 X 10	A	H-57-202
2204	OR. GENERAL	1000	--	-------	S	H-57-102	700	E	2	18 X 10	BW	H-57-202
2204A	STERILIZATION ROOM	120	1	6 X 6	A	H-57-102	110	E	1	10 X 10	A	H-57-202
2204B	SCRUB	200	1	10 X 10	A	H-57-102	0	E	0	EXHAUST TO ROOM 208A		
2205	OR. GENERAL	1000	--	-------	S	H-57-102	700	E	2	18 X 10	BW	H-57-202
2205A	STERILIZATION ROOM	0	0	-------	---	H-57-102	0	E	0	-------	----	H-57-202
2205B	SCRUB	0	0	-------	---	H-57-102	0	E	0	-------	----	H-57-202
2206	X-RAY ROOM	100	1	6 X 6	A	H-57-102	110	E	1	10 X 10	A	H-57-202
2207	ANESTHESIA WORK ROOM	470	2	10 X 10	A	H-57-102	520	E	1	14 x 14	A	H-57-202
2208	OR. ORTHOPEDIC	1500	--	-------	S	H-57-102	1200	E	2	22 x 14	BW	H-57-202
2208A	SCRUB	0	--	-------	--	H-57-102	180	E	1	10 X 10	B	H-57-202

DIFFUSERS & REGISTERS SCHEDULE

ROOM NO.	ROOM NAME	SUPPLY AIR CFM	NO.	SIZE	TYPE	SYSTEM	RETURN/EXHAUST AIR CFM	R/E	NO.	SIZE	TYPE	SYSTEM
2208B	EQUIPMENT STERL.	0	0	-------	----	H-57-102	0	E	0	-------	----	H-57-202
2208C	PLASTER & SPLINT	190	1	8 X 8	A	H-57-102	210	E	1	10 X 10	A	H-57-202
2209	OR. CYSTO	900	2	12 X 12	A	H-57-102	720	E	1	16 X 16	A	H-57-202
2209A	X-RAY ROOM	160	1	8 X 8	A	H-57-102	180	E	1	10 X 10	A	H-57-202
2210	EMPLOYEE LOUNGE	270	2	8 X 8	A	H-57-102	240	E	1	10 X 10	A	H-57-202
2211	OR. CYSTO	900	2	12 X 12	A	H-57-102	720	E	1	16 X 16	A	H-57-202
2212	TOILET WITH SUPPLY	530	1	15 X 15	A	H-57-102	580	E	2	10 X 10	A	H-57-209
2212A	LOCKER ROOM	200	1	10 X 10	A	H-57-102	220	E	1	10 X 10	A	H-57-209
2212B	SHOWER	0	0	-------	----	H-57-102	0	E	0	-------	----	H-57-202
2213	MINOR OR.	700	2	10 X 10	A	H-57-102	490	E	1	12 X 12	A	H-57-202
2214	TOILETS WITH SUPPLY	0	1	SUPPLY TO ROOM 214B			100	E	1	10 X 10	B	H-57-209
2214A	TOILETS WITH SUPPLY	100	1	6 X 6	A	H-57-102	110	E	1	10 X 10	A	H-57-209
2214B	SHOWER	90	1	6 X 6	A	H-57-102	250	E	1	10 X 10	A	H-57-209
2215	STERILIZATION ROOM	180	1	8 X 8	A	H-57-102	160	E	1	10 X 10	A	H-57-202
2215A	EQUIPMENT STERL.	0	0	-------	----	H-57-102	0	E	0	-------	----	H-57-202
2216	NERVE BLOCK INDUCTION	280	1	10 X 10	A	H-57-102	230	E	1	10 X 10	A	H-57-202
2217	CARDIAC O.R.	1500	-	-------	S	H-57-102	1200	E	2	22 x 14	BW	H-57-202
2218	STORAGE WITH SUPPLY	640	2	10 X 10	A	H-57-102	580	E	1	14 x 14	A	H-57-202

DIFFUSERS & REGISTERS SCHEDULE

ROOM NO.	ROOM NAME	SUPPLY AIR CFM	NO.	SIZE	TYPE	SYSTEM	RETURN/EXHAUST AIR CFM	R/E	NO.	SIZE	TYPE	SYSTEM
2219	ADMIN. EXH	850	1	10 x 10	A	H-57-102	230	E	1	10 x 10	A	H-57-202
2220	UTILITY ROOM CLEAN	1100	4	10 x 10	A	H-57-102	990	E	2	12 x 12	A	H-57-202
2221	H.A.C.	200	1	10 x 10	A	H-57-102	220	E	1	10 x 10	A	H-57-202
2223	STORAGE WITH SUPPLY	250	2	8 X 8	A	H-57-102	230	E	1	10 x 10	A	H-57-202
2225	DOCTORS LOUNGE	170	1	8 X 8	A	H-57-102	150	E	1	10 x 10	A	H-57-202
2227	WORK ROOM GENERAL	180	1	8 X 8	A	H-57-102	160	E	1	10 X 10	A	H-57-202
2229	GENERAL CAR. ROOM	250	1	10 X 10	A	H-57-102	400	E	1	12 X 12	A	H-57-202
2231	DRESSING ROOM	120	1	6 X 6	A	H-57-102	110	E	1	10 X 10	A	H-57-202
2231A	TOILETS W/SUPPLY	120	1	6 X 6	A	H-57-102	130	E	1	10 X 10	A	H-57-208
2233	UTILITY ROOM SOILED	300	1	10 X 10	A	H-57-102	270	E	1	10 X 10	A	H-57-202
2C2	CORRIDOR EXH. OR SUITE	1240	3	12 X 12	A	H-57-102	1120	E	2	14 X 14	A	H-57-202
2C3	CORRIDOR EXH. OR SUITE	490	2	10 X 10	A	H-57-102	440	E	1	12 X 12	A	H-57-202
2C4	CORRIDOR EXH. OR SUITE	1800	2	18 X 18	A	H-57-102	1620	E	1	22 X 22	A	H-57-202
2C2N	CORRIDOR EXH. OR SUITE	190	1	8 X 8	A	H-57-102	0	E	0	EXH. TO ROOM 229		
2C2W1	CORRIDOR EXH. OR SUITE	1200	4	10 x 10	A	H-57-102	950	E	1	18 X 18	A	H-57-202
2C2W2	CORRIDOR EXH. OR SUITE	790	2	12 X 12	A	H-57-102	710	E	2	12 X 12	A	H-57-202
2C4E	CORRIDOR EXH. OR SUITE	190	1	8 X 8	A	H-57-102	170	E	1	10 X 10	A	H-57-202
2S2	STAIR WAY	0	0	-------	---	H-57-102	0	---	0	-------	---	H-57-202
2243	SHELL SPACE	675	1	15 x 15	A	H-57-102	725	E	1	18 x 12	A	H-57-215

NOTE:
ALL ROOM NUMBERS FOR BUILDING 57 ARE PREFIXED WITH A "0"

FOR REHEAT COIL AND STEAM HUMIDIFIER SEE SHT. 57-H-7.

BOTTOM OF REGISTER IS ABOUT 7" ABOVE FINISH FLOOR IN OPERATING ROOMS.

(H) HUMIDSTAT

(T/R) WALL MOUNTED TEMPERATURE & RELATIVE HUMIDITY RECORDER

CHANGE ORDER MODIFIES 57-H-6 R3

SCALE 1/8" = 1'-0"

KEY PLAN

Revisions	Date
10 CARDIAC OR. ADDITION	5/7/84
9 STERLIZER EQUIPMENT REQUIRED REVISIONS	12-15-83
4 MODIFICATIONS TO STAINLESS STL. DUCTS.	10.9.83
3 MODIFICATIONS TO SURGERY & RECOVERY	10.21.83

AS-BUILT 9/2/86

A Tucson Joint Venture
Finical & Dombrowski and Friedman Keim & McFerron AIA
732 North Stone Avenue Tucson, Arizona 85705 792-1220

Registration

Drawing Title: HVAC PLAN SECOND FLOOR- CENTER
Approved: Project Director
Drawn: PUP
Checked: WIN
Project Title: Clinical Addition
Building Number: 57
Location: Tucson, Arizona
Date
Project No. 678-048
DRAWING NO. 57-H-6 R4
Sheet 24 of 51

Veterans Administration

VA FORM 08-6231, OCT 1978