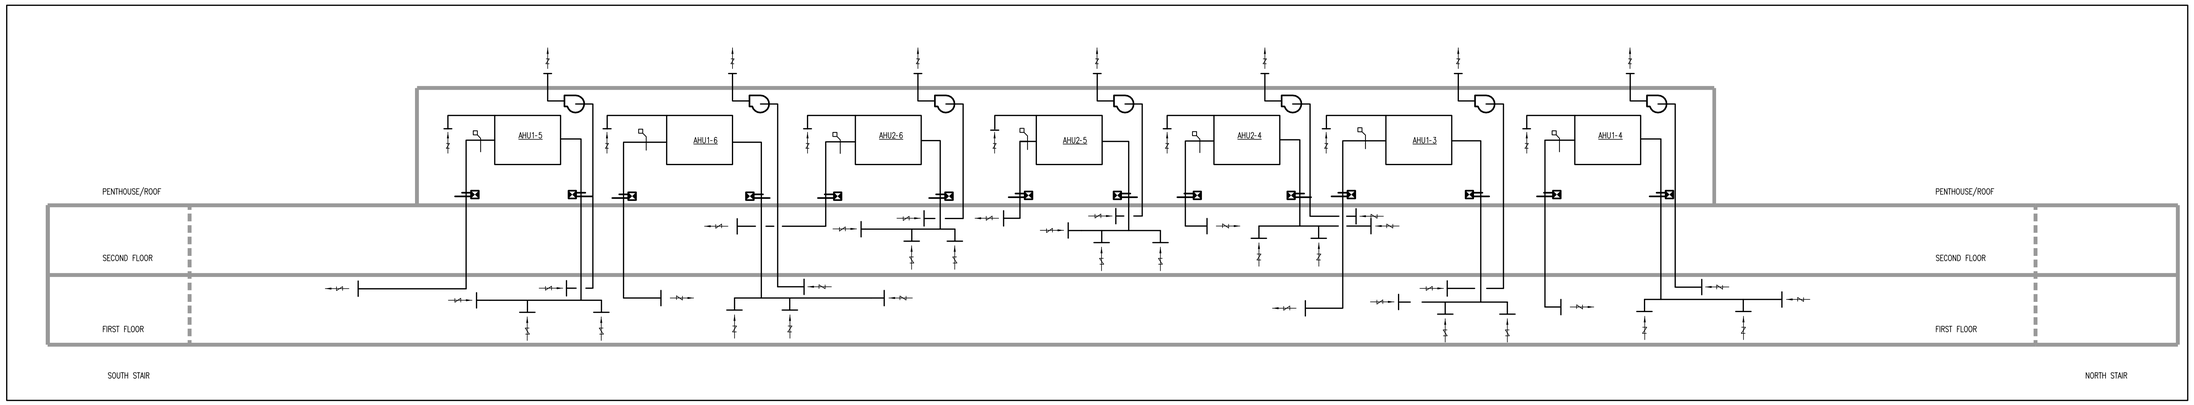

AIR HANDLER RISER DIAGRAM FOR D&T BUILDING
No Scale

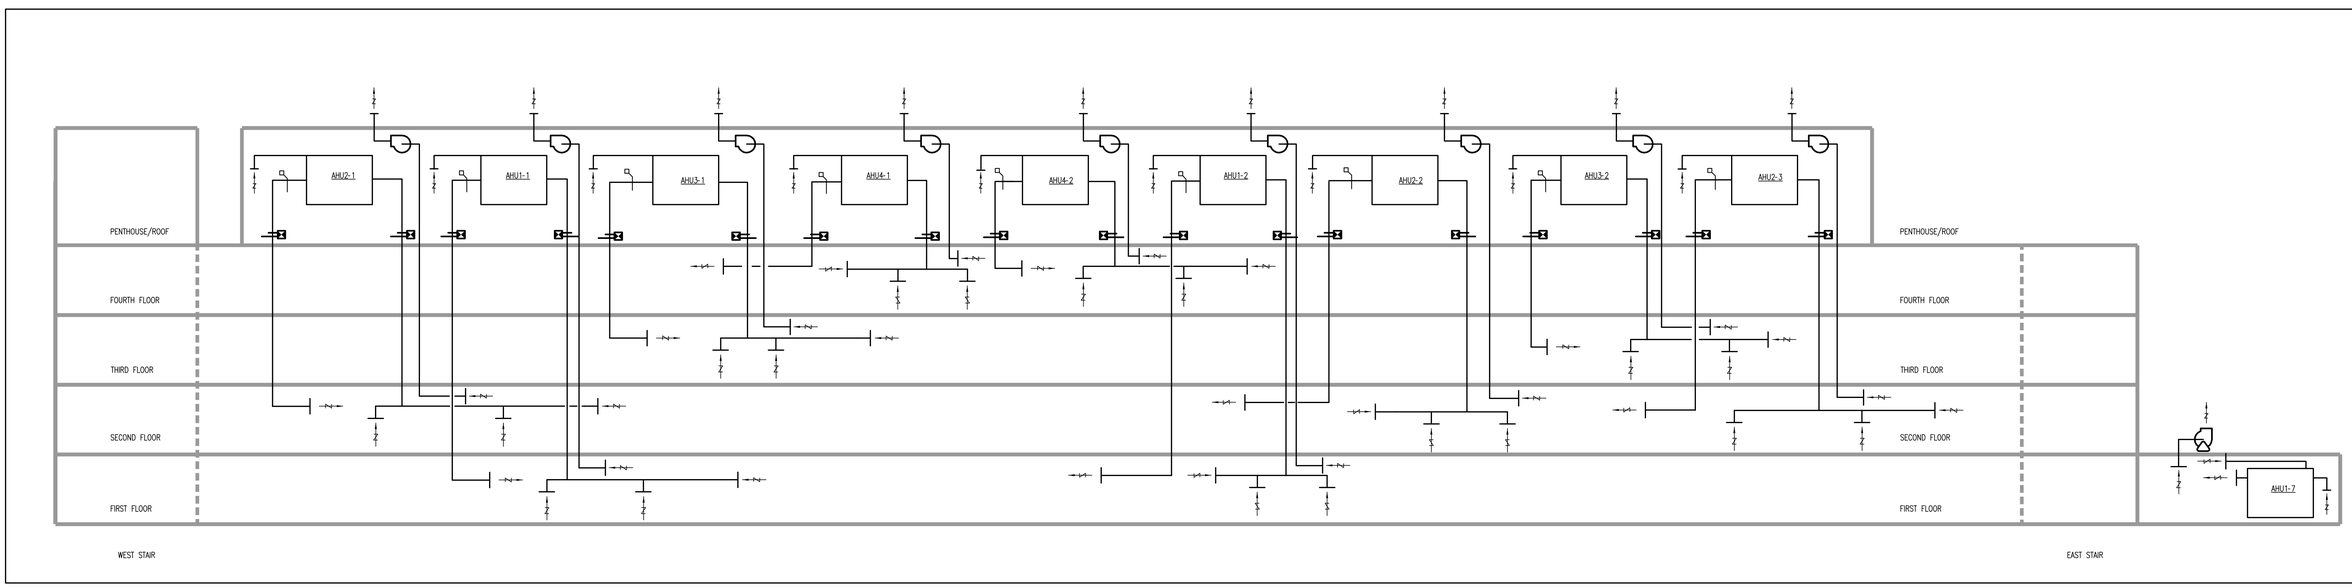

AIR HANDLER RISER DIAGRAM FOR CLINIC BUILDING
No Scale

RECORD DRAWINGS

Revisions Date

CONSULTANTS

TLC ENGINEERING FOR ARCHITECTURE
255 S. Orange Avenue
Suite 1600
Orlando, Florida 32801
Phone: 407-841-9050
Fax: 407-843-5445
www.tlc-engineers.com
© Copyright 2008 TLC Engineering for Architecture, Inc.
EB #0000015 TLC NO: 108302

Eric S. Cepull, P.E.
Florida License #64750

Seal

ARCHITECT/ ENGINEERS:

HELLMUTH, OBATA & KASSABAUM, INC.
ARCHITECTURE, ENGINEERING, PLANNING, INTERIORS, GRAPHICS, CONSULTING
One Tampa City Center, Suite 1600, Tampa, FL, 33602
Voice: | 813 | 229 - 0300
Fax: | 813 | 223 - 7116
Internet: http://www.hok.com
FL. Reg. AAC001139
All reproduction & intellectual property rights reserved © 2008
Contract No: 6CA2400

Drawing Title:
HVAC RISER DIAGRAMS
DUCTWORK

Approved: Checker

Project Title
Lee County Outpatient Clinic

Client Location
Cape Coral, Florida

Date 12/07/12 | Checked: DCB | Drawn EMF

Project Number
516CA2400

Building Number

Drawing Number:
H701

Office of Construction and Facilities Management

Department of Veterans Affairs

three inches = one foot
one and one half inches = one foot
one inch = one foot
three quarters inch = one foot
one half inch = one foot
three eighths inch = one foot
one quarter inch = one foot
one eighth inch = one foot
\\Tlc12\work\2008-Jobs\108302-VA Ft Myers Outpatient Clinic\CAD-MEP\Sheets H701.dwg 12/11/2012 11:20:16 AM burns.bradford