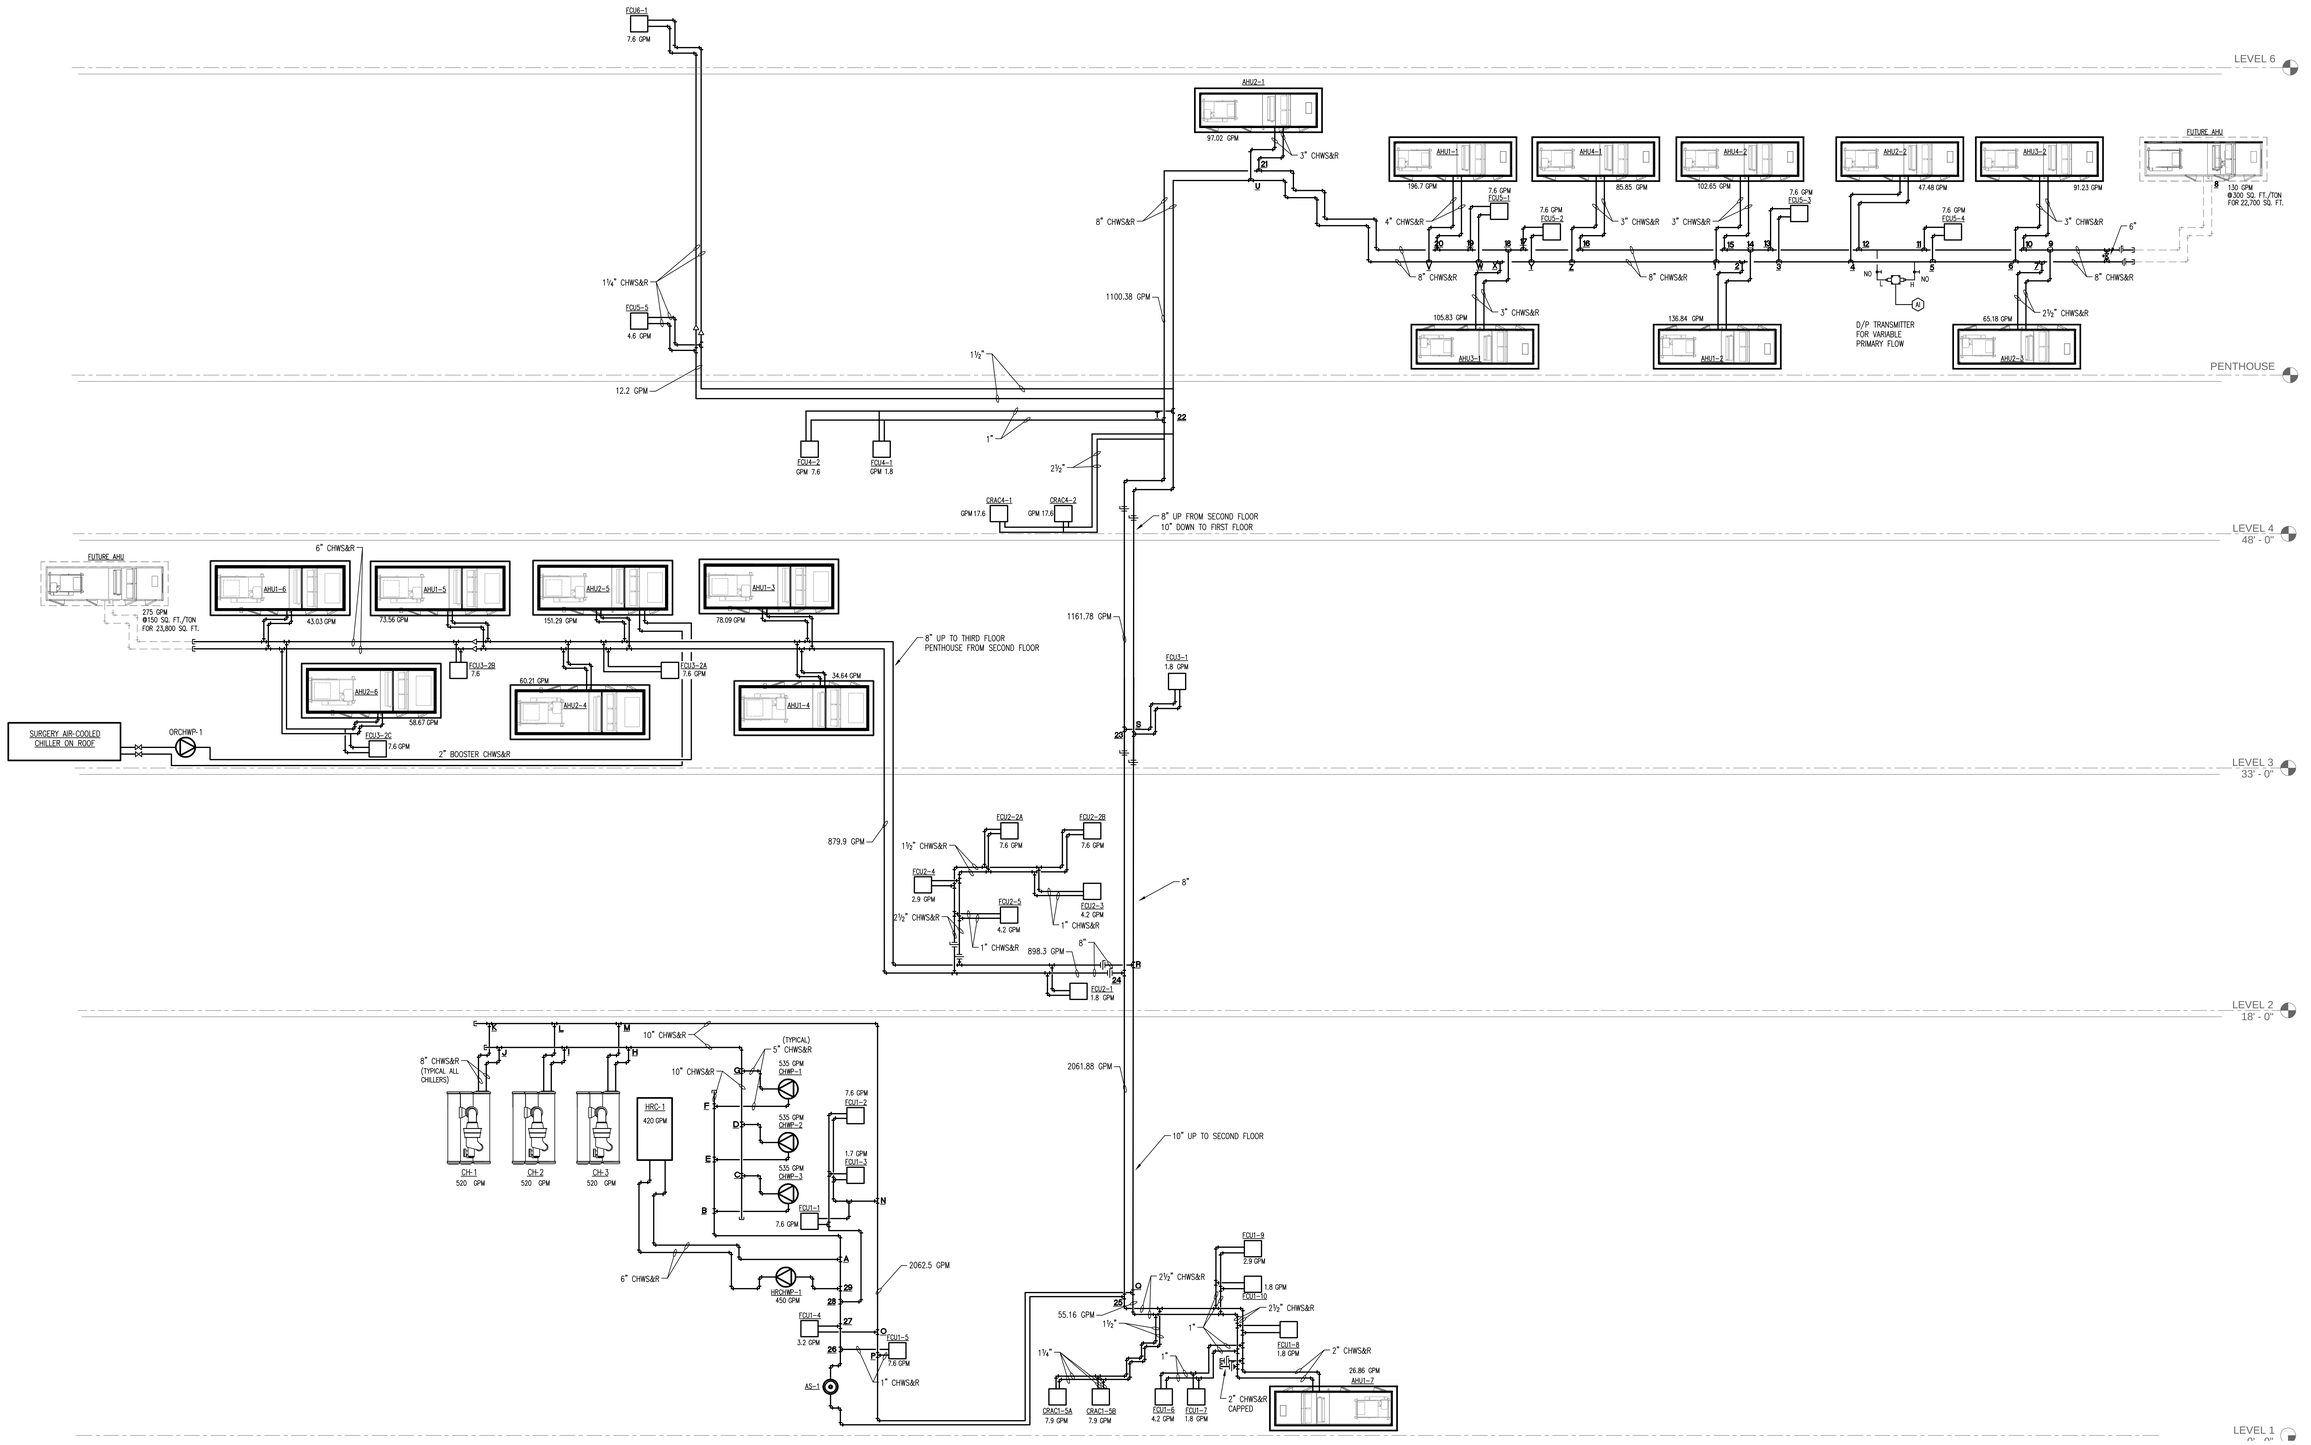

RECORD DRAWINGS

Revisions	Date

CONSULTANTS

TLC ENGINEERING FOR ARCHITECTURE
255 S. Orange Avenue
Suite 1600
Orlando, Florida 32801
Phone: 407-841-9050
Fax: 407-843-5445
www.tlc-engineers.com
© Copyright 2008 TLC Engineering for Architecture, Inc.
EB #0000015 TLC NO: 108302

Eric S. Cepull, P.E.
Florida License #64750
Seal

ARCHITECT/ ENGINEERS:

HELLMUTH, OBATA & KASSABAUM, INC.
ARCHITECTURE, ENGINEERING, PLANNING, INTERIORS, GRAPHICS, CONSULTING
One Tampa City Center, Suite 1800, Tampa, FL, 33602
Voice: | 813 | 229 - 0300
Fax: | 813 | 223 - 7116
Internet: http://www.hok.com
FL Reg. AAC001139
All reproduction & intellectual property rights reserved © 2008
Contract No: .6CA2400

Drawing Title: CHILLED WATER SCHEMATIC
Approved: Checker
Project Title: Lee County Outpatient Clinic
Client Location: Cape Coral, Florida
Date: 12/07/12
Checked: TLC
Drawn: TLC
Project Number: 516CA2400
Building Number:
Drawing Number: H704

Office of Construction and Facilities Management
Department of Veterans Affairs

\\Tlc12\work\2008-Jobs\108302-VA Ft Myers Outpatient Clinic\CAD-MEP\Sheets H704.dwg 12/11/2012 11:21:36 AM burns.bradford
one inch = one foot
three quarters inch = one foot
one half inch = one foot
three eighths inch = one foot
one quarter inch = one foot
one eighth inch = one foot