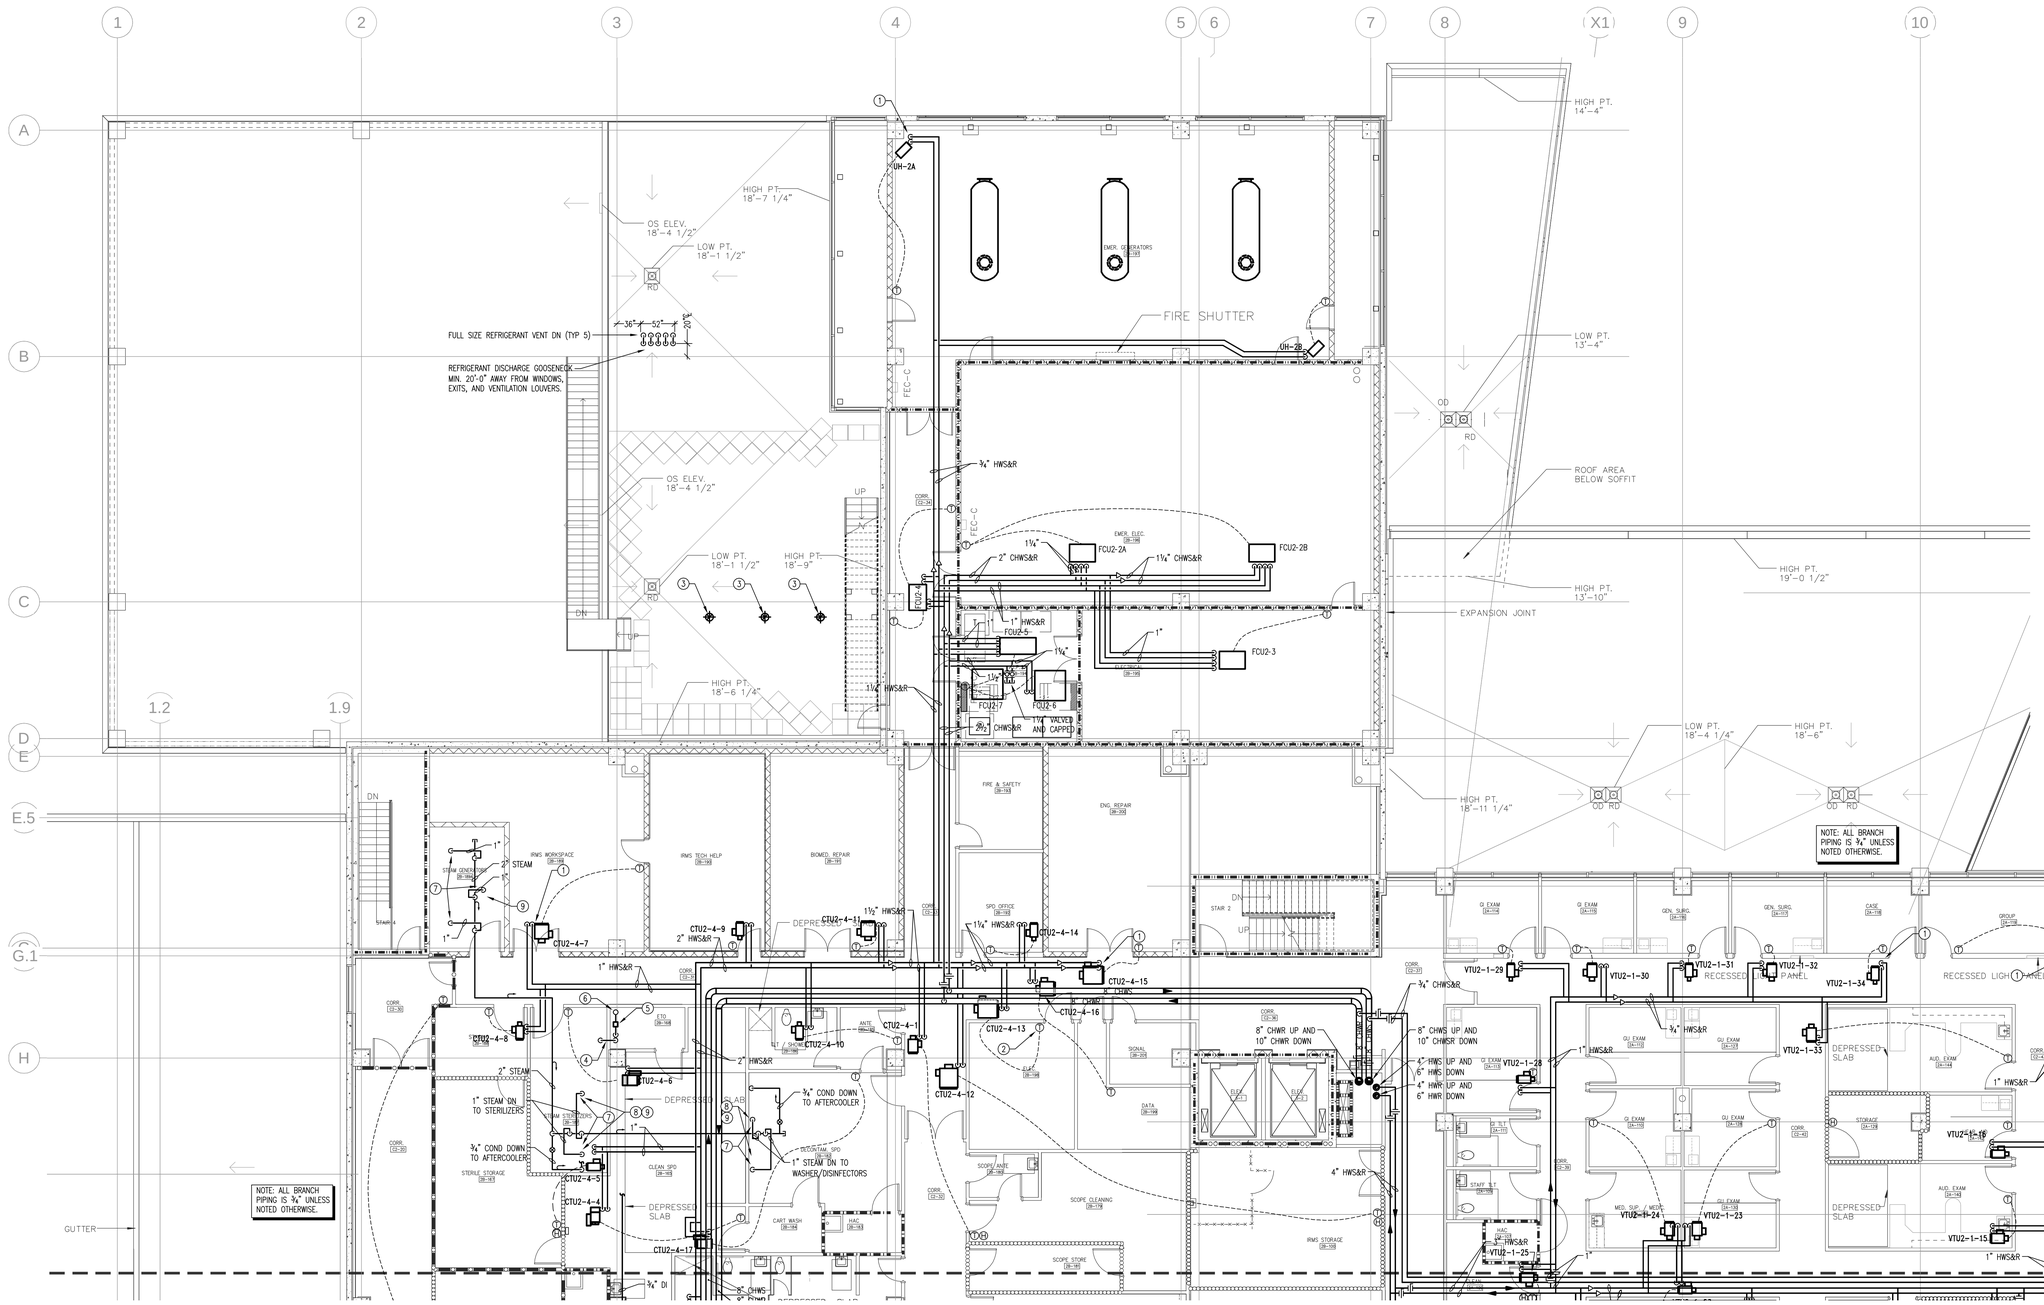

SHEET NOTES:

1. PROVIDE 3-WAY VALVE AT THIS LOCATION
2. ALARM AT CONTROL PANEL SHOULD SPACE TEMPERTURE EXCEED 95°F (35°C)
3. 12" BOILER FLUE THRU ROOF. MAINTAIN MINIMUM 8'-0" FROM ANY VERTICAL WALL.
4. ½" ETO GAS EXHAUST PIPE FROM ETO STERILIZERS TO ETO SCRUBBER IN STEAM STERILIZERS 2B-187.
5. MOISTURE TRAP IN GAS EXHAUST PIPE.
6. ¾" ETO GAS EXHAUST PIPE TO ROOF FOR EMERGENCY VENTING. SEE DETAIL SHEET H503 #7 FOR EXHAUST ROUTING.
7. PROVIDE ISOLATION VALVE ON LEG TO EQUIPMENT.
8. PROVIDE AFTERCOOLER AT FLOOR DRAIN, PIPE STEAM CONDENSATE DOWN AFTERCOOLER AT DRAIN.
9. DRAWINGS NOT FOR CONSTRUCTION. COORDINATE LAYOUT WITH ACTUAL FIELD INSTALLED LOCATION OF EQUIPMENT.

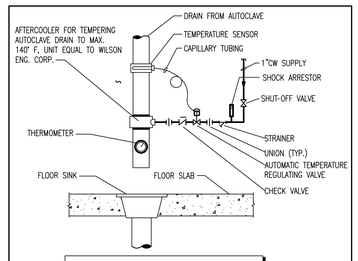

NOTE: PROVIDE PIPE SUPPORT FOR AFTERCOOOLER CONSISTING OF GALVANIZED STEEL PIPE CLAMPS SECURED TO UNI-STRUT FRAME SUPPORTS WITH GALVANIZED FINISH, SECURED TO FLOOR SLAB WITH ANCHORS.

AFTERCOOLER
No Scale

1

Key Plan

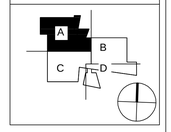

PARTIAL FLOOR PLAN LEVEL 2 AREA A - HVAC PIPING
1/8" = 1'-0"

RECORD DRAWINGS

Revisions		Date
1	ADDENDUM 05	08-25-2009
2	ASI #024	
3	RFI #393	07-19-2010
4	ASI 138	04-15-2011
5	RFI #975	05-11-2011
6	RFI #898.003	05-13-2011
7	RFI RE 0062	08-13-2012

CONSULTANTS

TLC ENGINEERING FOR ARCHITECTURE
255 S. Orange Avenue
Suite 1600
Orlando, Florida 32801
Phone: 407-841-9050
Fax: 407-843-5445
www.tlc-engineers.com
© Copyright 2008 TLC Engineering for Architecture, Inc.
EB #0000015 TLC NO: 108302

Eric S. Cepull, P.E.
Florida License #64750

Seal

ARCHITECT/ ENGINEERS:

HELLMUTH, OBATA & KASSABAUM, INC.
ARCHITECTURE, ENGINEERING, PLANNING, INTERIORS, GRAPHICS, CONSULTING
One Tampa City Center, Suite 1600, Tampa, FL 33602
Voice: | 813 | 229 - 0300
Fax: | 813 | 223 - 7116
Internet: http://www.hok.com
FL Reg. AAC001139
All reproduction & intellectual property rights reserved ©2008
Contract No: 6CA2400

Drawing Title: PARTIAL FLOOR PLAN LEVEL 2 AREA A - HVAC PIPING

Approved: Checker

Project Title: Lee County Outpatient Clinic

Client Location: Cape Coral, Florida

Date: 12/07/12 | Checked: DCB | Drawn: ESC

Project Number: 516CA2400

Building Number:

Drawing Number: HP102-A

Office of Construction and Facilities Management

Department of Veterans Affairs

three inches = one foot
one and one half inches = one foot
one inch = one foot
three quarters inch = one foot
one half inch = one foot
three eighths inch = one foot
one quarter inch = one foot
one eighth inch = one foot

\\Tlc12\work\2008-Jobs\108302-VA Ft Myers Outpatient Clinic\CAD-MEP\Sheets HP102-A.dwg 12/11/2012 10:54:48 AM Burns.bradford