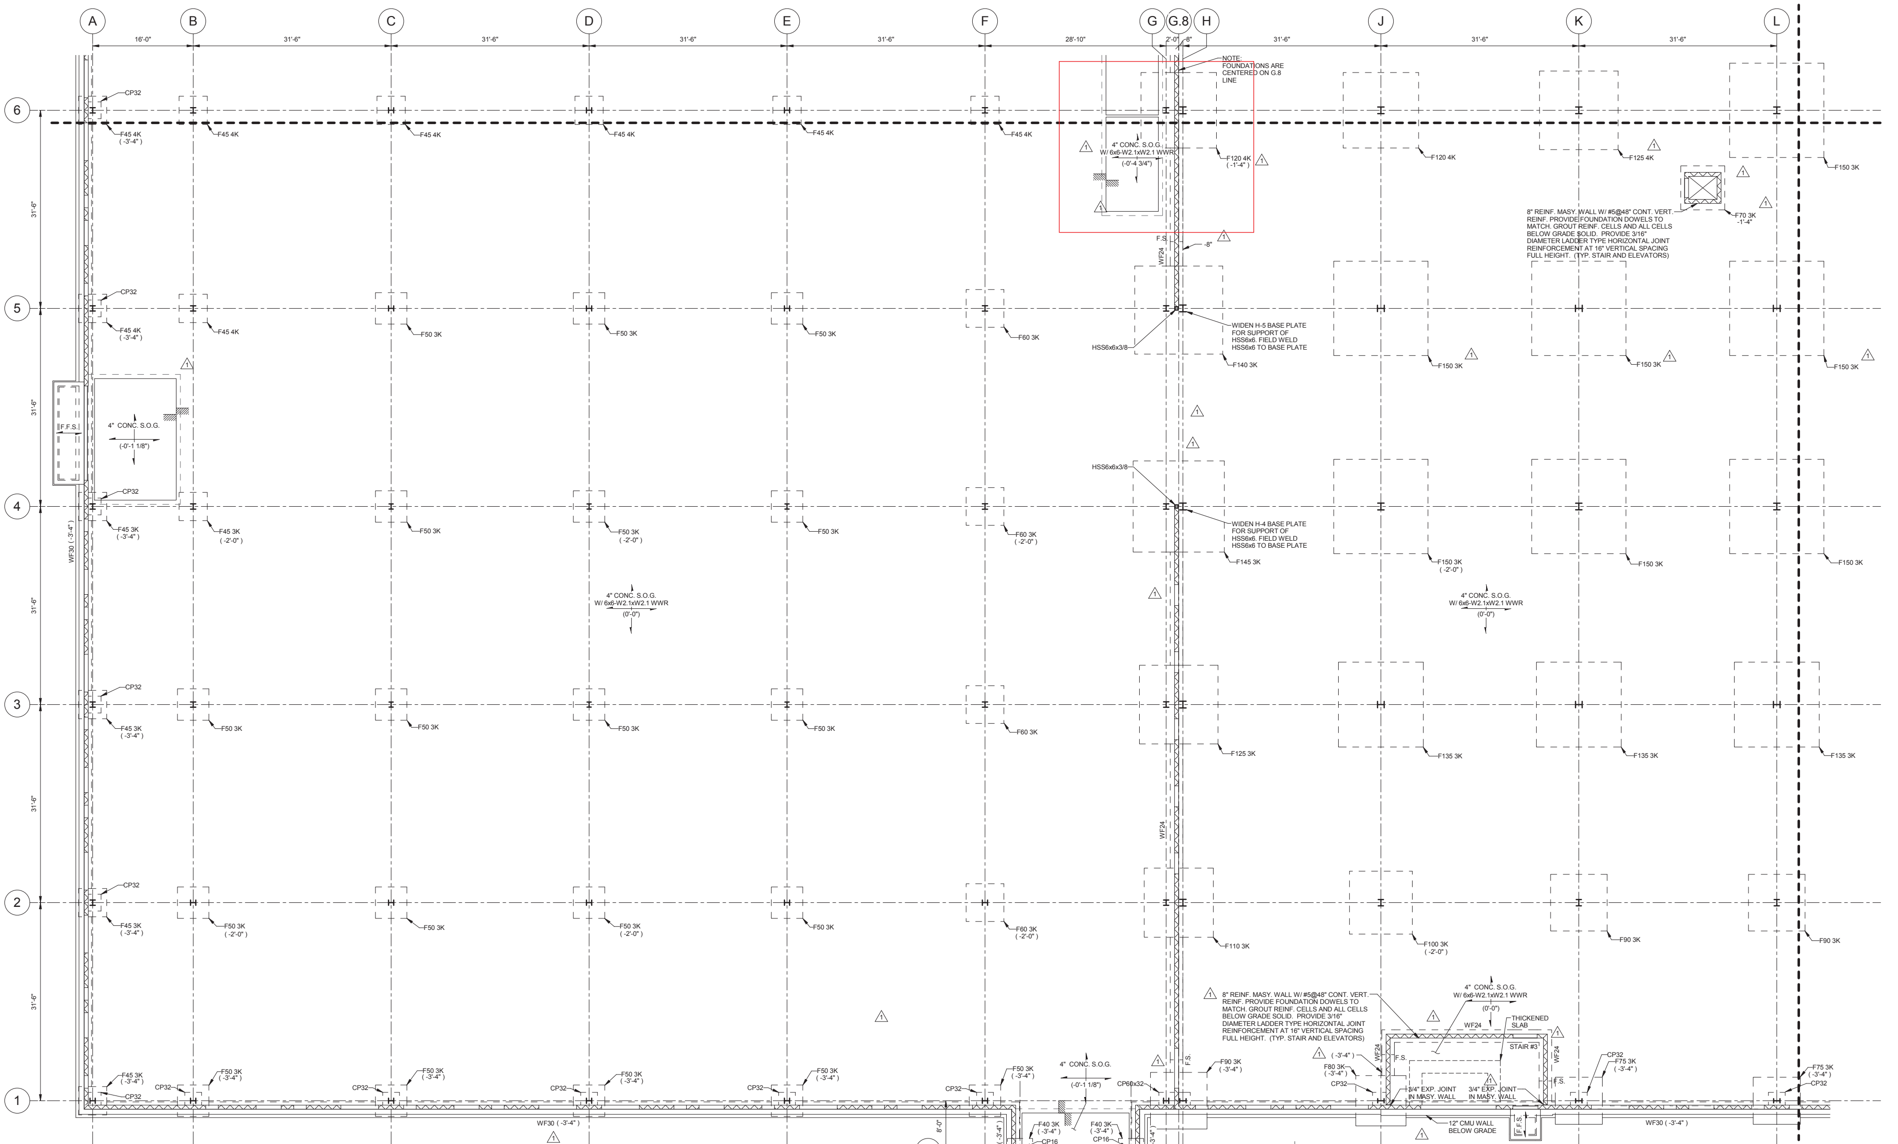

NOTES:

1. FINISHED FIRST FLOOR ELEVATION AT 0'-0". REFERENCE ELEVATION (0'-0") TOP OF FOOTING AND TOP OF CONCRETE PIERS AT (-0'-8") U.O.N.
2. WF24: DENOTES 2'-0" WIDE BY 1'-0" THICK CONTINUOUS CONCRETE WALL FOOTING W/ (3)#5 CONTINUOUS.

   WF30: DENOTES 2'-6" WIDE BY 1'-0" THICK CONTINUOUS CONCRETE WALL FOOTING W/ (3)#5 CONTINUOUS.
3. FXX: DENOTES COLUMN FOOTING. SEE TYPICAL DETAIL.
4. CPXX: DENOTES CONCRETE PIER, SEE TYPICAL DETAIL.
5. F.S.: DENOTES FOOTING STEP, SEE TYPICAL DETAIL.
6. F.F.S. :DENOTES FROST FREE SLAB, SEE TYPICAL DETAIL.
7. :DENOTES 8" REINFORCED MASONRY WALL W/ #7@2'-0" CONTINUOUS VERTICAL REINFORCEMENT IN GROUTED CELLS WITH DOWELS IN FOOTINGS TO MATCH. GROUT ALL CELLS BELOW GRADE SOLID. SEE NOTES, SECTIONS AND TYPICAL DETAILS FOR ADDITIONAL REINFORCING. TYPICAL UNLESS NOTED OTHERWISE ON PLAN.

PARTIAL FOUNDATION PLAN AREA C

1/8" = 1'-0"

AREA - A	AREA - B
AREA - C	AREA - D

CONSTRUCTION DOCUMENTS CD-2

1/8" = 1'-0"

Number	Revision	YY.MM.DD	Issued to	Issued by
1	RESET DRAWING CD-1	12/23/15		

Stantec
650 Smithfield Street
Suite 2500
Pittsburgh, PA 15222
www.stantec.com

BARBER & HOFFMAN, INC.
Consulting Engineers
215 Executive Drive, Suite 202
Cranberry Township, PA 16066
724-741-0848 | (F) 724-741-0849
barberhoffman.com

CAVEO
1821 Cumberland Avenue, Suite 100
Charlotte, NC 28203
704-348-3097
www.caveoeng.com

HINMAN
1800 Diagonal Road, Suite 525 |
Alexandria, VA 22314
P 703.416.6780 | F 703.836.4423
www.hce.com

careMAPS, LLC
Medical Equipment Planning Solutions

Cambridge

The Contractor shall verify and be responsible for all dimensions. DO NOT scale the drawing - any errors or omissions shall be reported to Stantec without delay. The Copyrights to all designs and drawings are the property of Stantec. Reproduction or use for any purpose other than that authorized by Stantec is forbidden.

COMMONWEALTH OF PENNSYLVANIA — MICHAEL RAY MILLER
BARBER & HOFFMAN, INC.

Drawing Title	PARTIAL FOUNDATION PLAN AREA C
	1
Approved: Project Director	Butler VA
Project Title	BUTLER VA HEALTHCARE CLINIC
Location	BUTLER, PENNSYLVANIA
Date	2015.04.23
Checked	
Drawn	
Project Number	SFO NO. VA-101-10-RP-0105
Building Number	
Drawing Number	SB103
Dwg.	of 99

Office of Construction and Facilities Management

Department of Veterans Affairs