


one and one half inches = one foot
one inch = one foot
one inch = one foot
three quarters inch = one foot
one half inch = one foot
one half inch = one foot
three eighths inch = one foot
one quarter inch = one foot
one eighth inch = one foot
one eighth inch = one foot

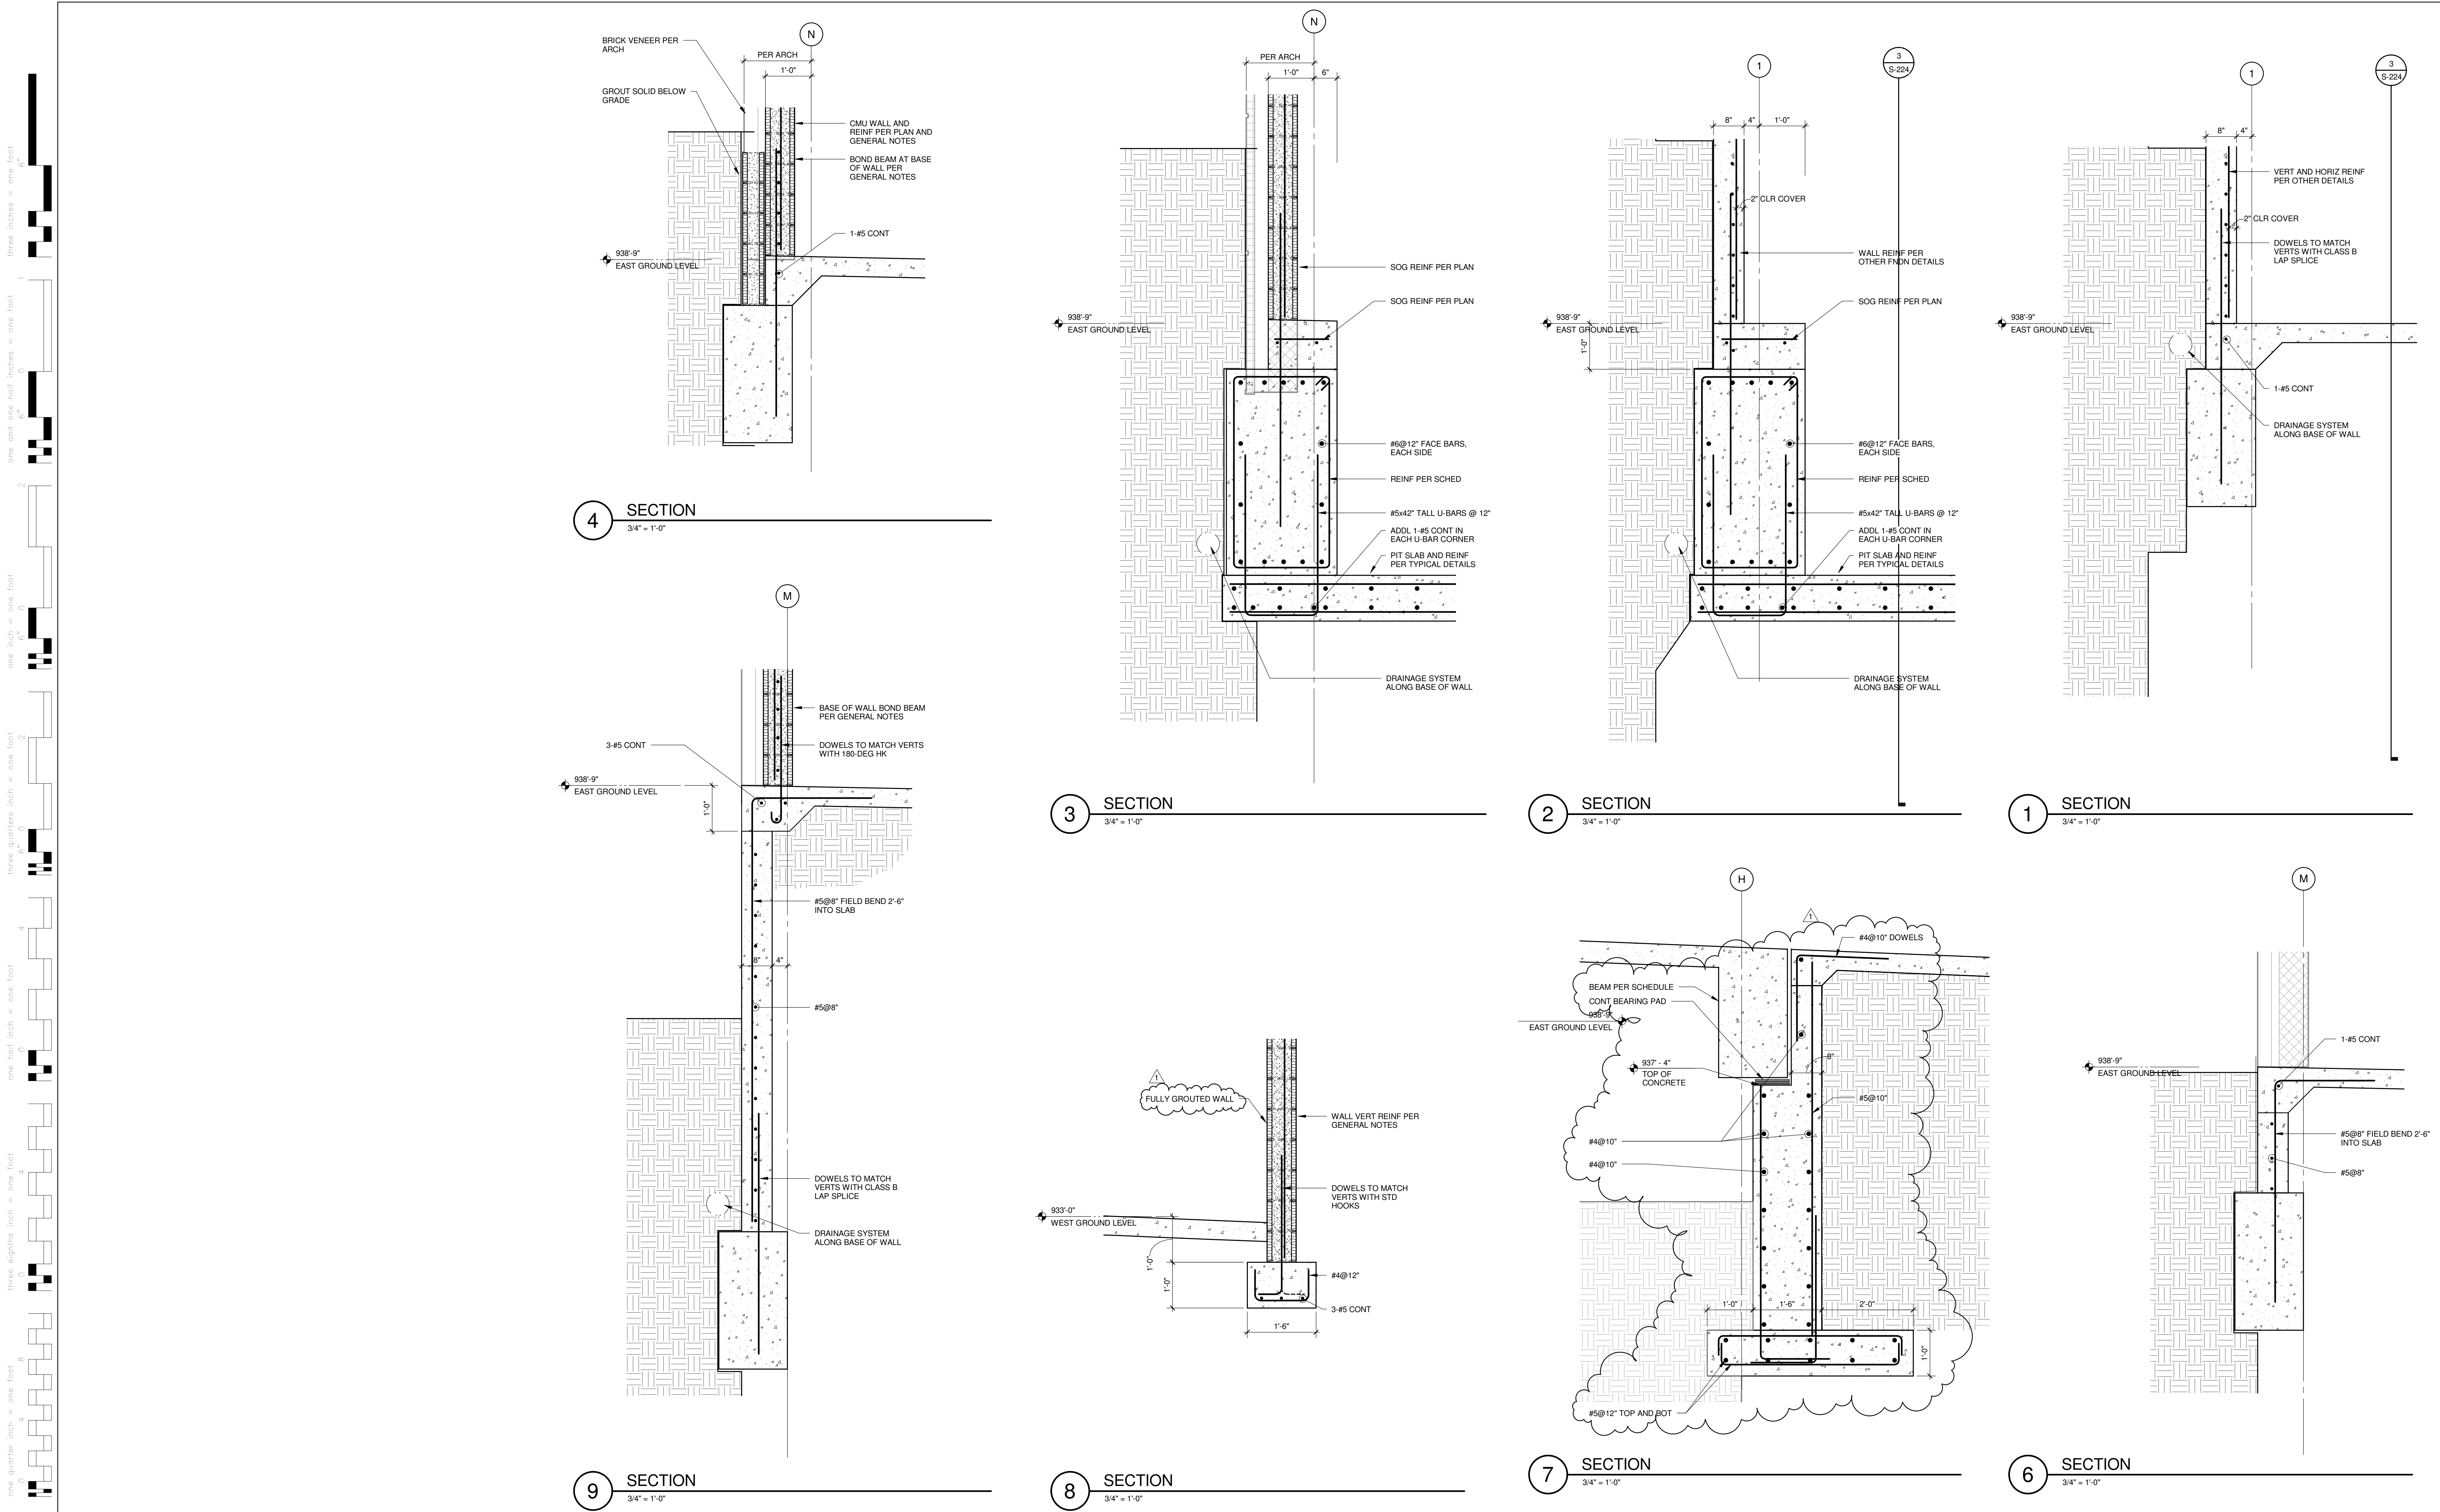


1	ADDENDUM #01	04-07-2016
Revisions:	Date	

CONSULTANTS:

WALTER P MOORE
WALTER P. MOORE AND ASSOCIATES, INC.
801 MAIN STREET, TENTH FLOOR
KANSAS CITY, MISSOURI 64105
PHONE: 816.701.2100 FAX: 816.701.2200

FSC, Inc.
CONSULTING ENGINEERS
9225 Indian Creek Pkwy, Suite 300
Overland Park, KS 66210

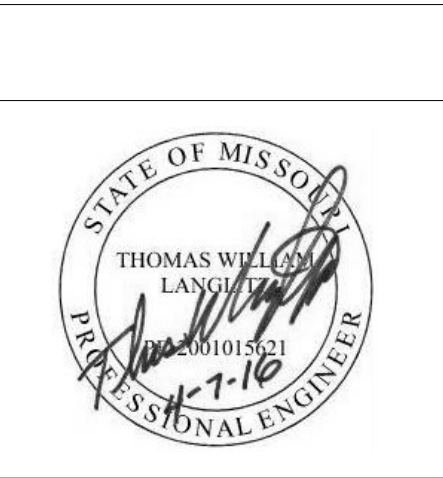

ARCHITECT/ENGINEERS:

GLMVArchitecture
9229 Ward Parkway, Kansas City, MO 64114
Tel: (816) 444-4200
www.glmv.com

Drawing Title
FOUNDATION DETAILS

Approved: Project Director

Project Title
CONSTRUCT PATIENT PARKING GARAGE

Location
KANSAS CITY, MISSOURI

Date
OCT. 28, 2014

Checked
S-312

Drawn
S-312

Project Number
589-370

Building Number

Drawing Number
S-312

Dwg. of

Office of Construction and Facilities Management

Department of Veterans Affairs