

A

B

C

D

E

F

three inches = one foot

one and one half inches = one foot

2

one inch = one foot

three quarters inch = one foot


4

one half inch = one foot


three eighths inch = one foot

one quarter inch = one foot


one eighth inch = one foot

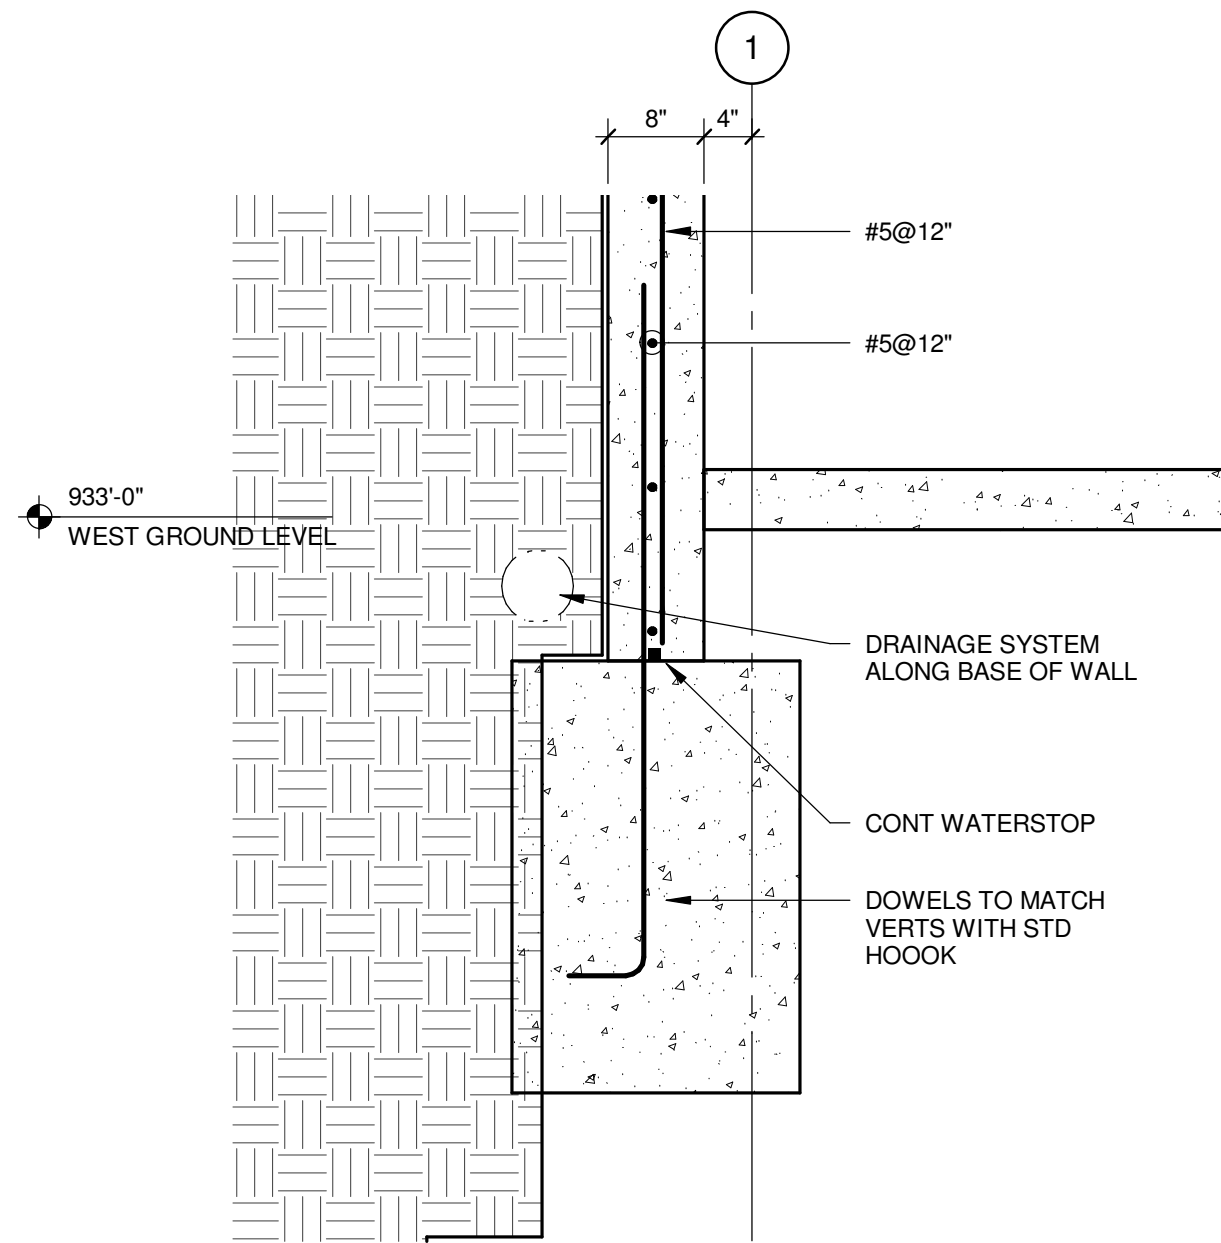

3 SECTION
3/4" = 1'-0"

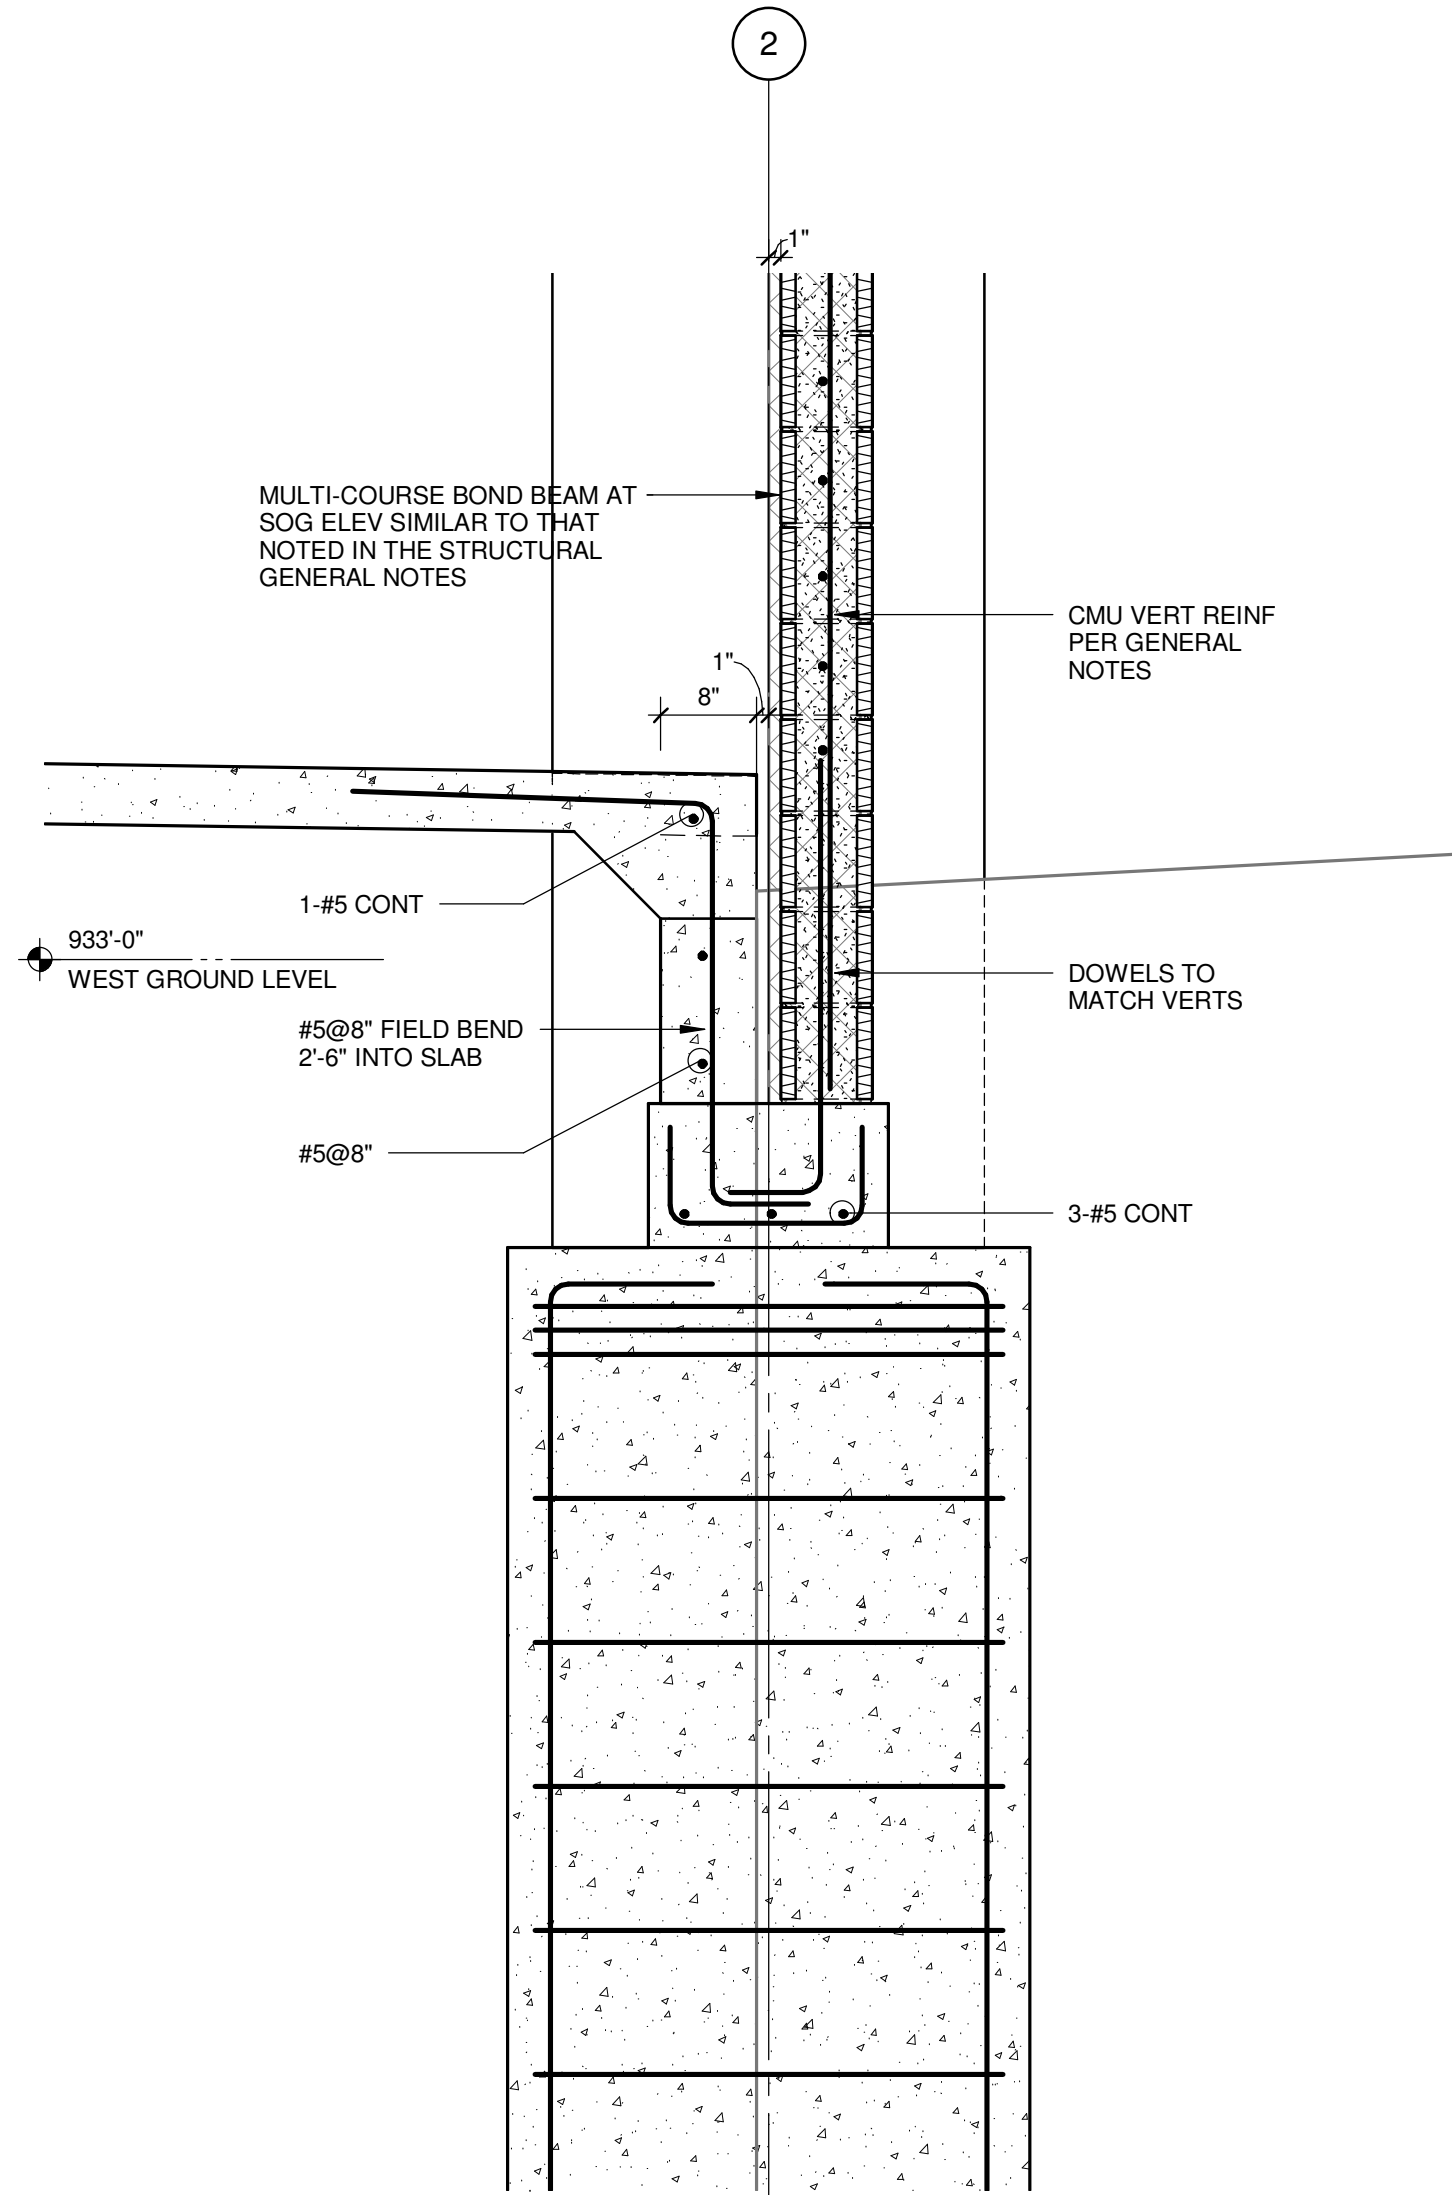

7 SECTION
3/4" = 1'-0"

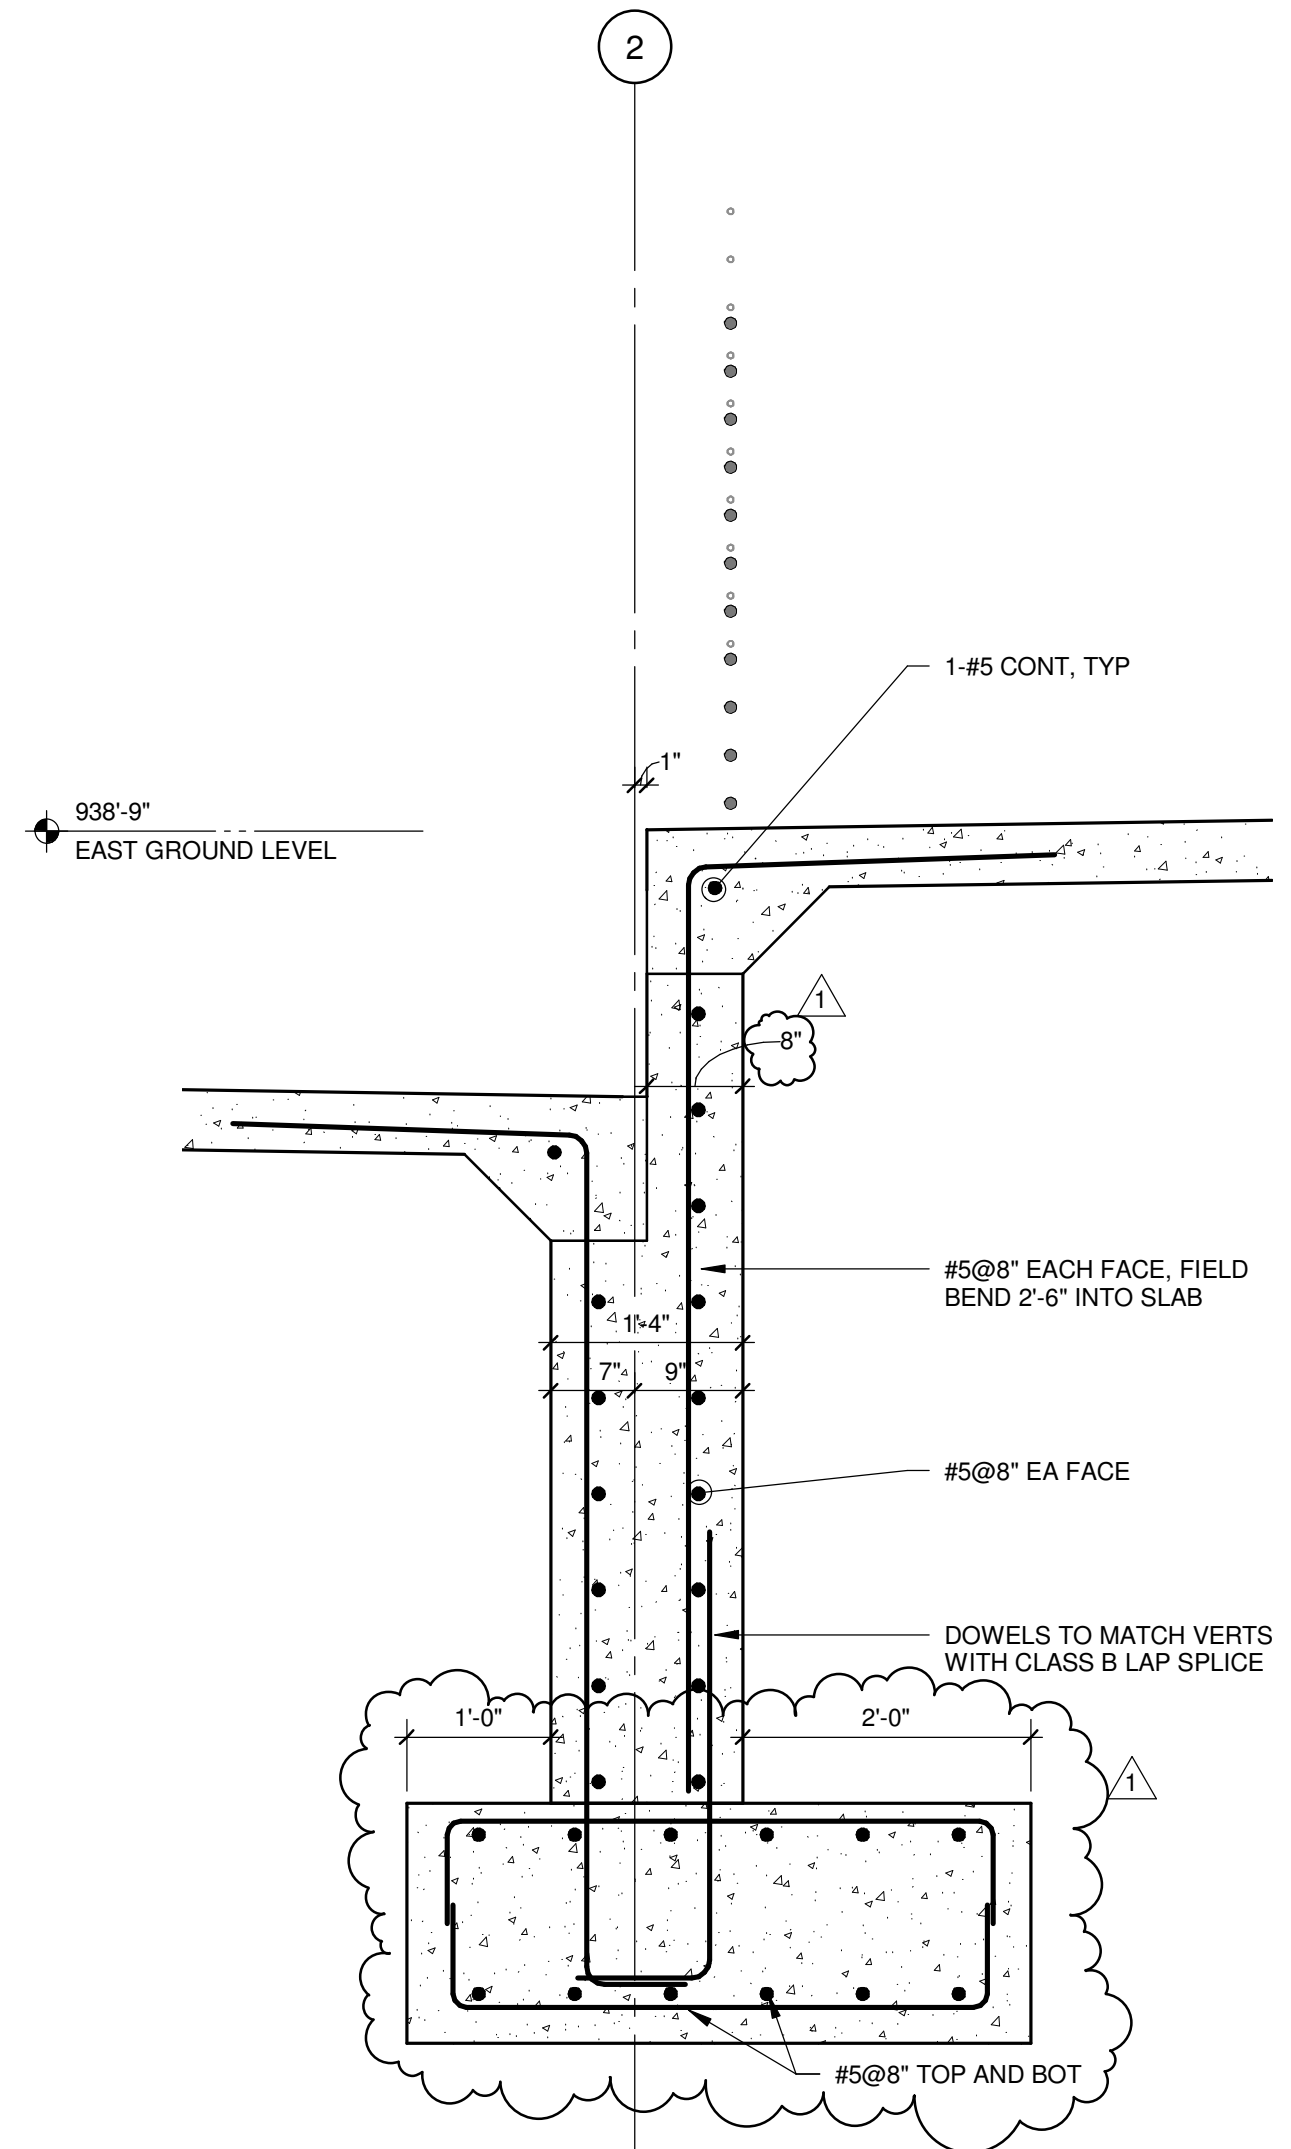


6 SECTION
3/4" = 1'-0"

1	ADDENDUM #01	04-07-2016
Revisions:	Date	

CONSULTANTS:

FSC, Inc.
CONSULTING ENGINEERS
9225 Indian Creek Pkwy, Suite 300
Overland Park, KS 66210

WALTER P. MOORE
WALTER P. MOORE AND ASSOCIATES, INC.
801 MAIN STREET, TENTH FLOOR
KANSAS CITY, MISSOURI 64105
PHONE: 816.701.2100 FAX: 816.701.2200

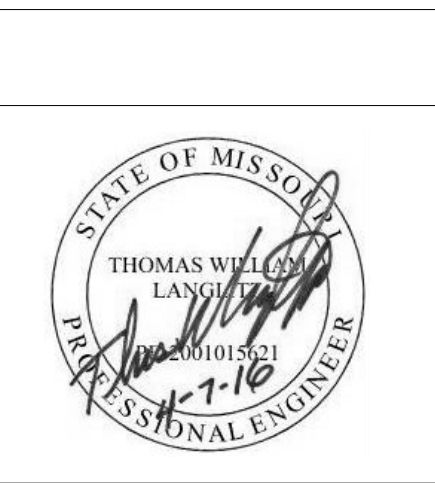

ARCHITECT/ENGINEERS:

GLMVArchitecture
9229 Ward Parkway, Kansas City, MO 64114
Tel: (816) 444-4200
www.glmv.com

Drawing Title
FOUNDATION DETAILS

Approved: Project Director

Project Title
CONSTRUCT PATIENT PARKING GARAGE

Location
KANSAS CITY, MISSOURI

Date
OCT. 28, 2014

Checked
Drawn

Project Number
589-370

Building Number

Drawing Number
S-313

Dwg. of

Office of Construction and Facilities Management

Department of Veterans Affairs