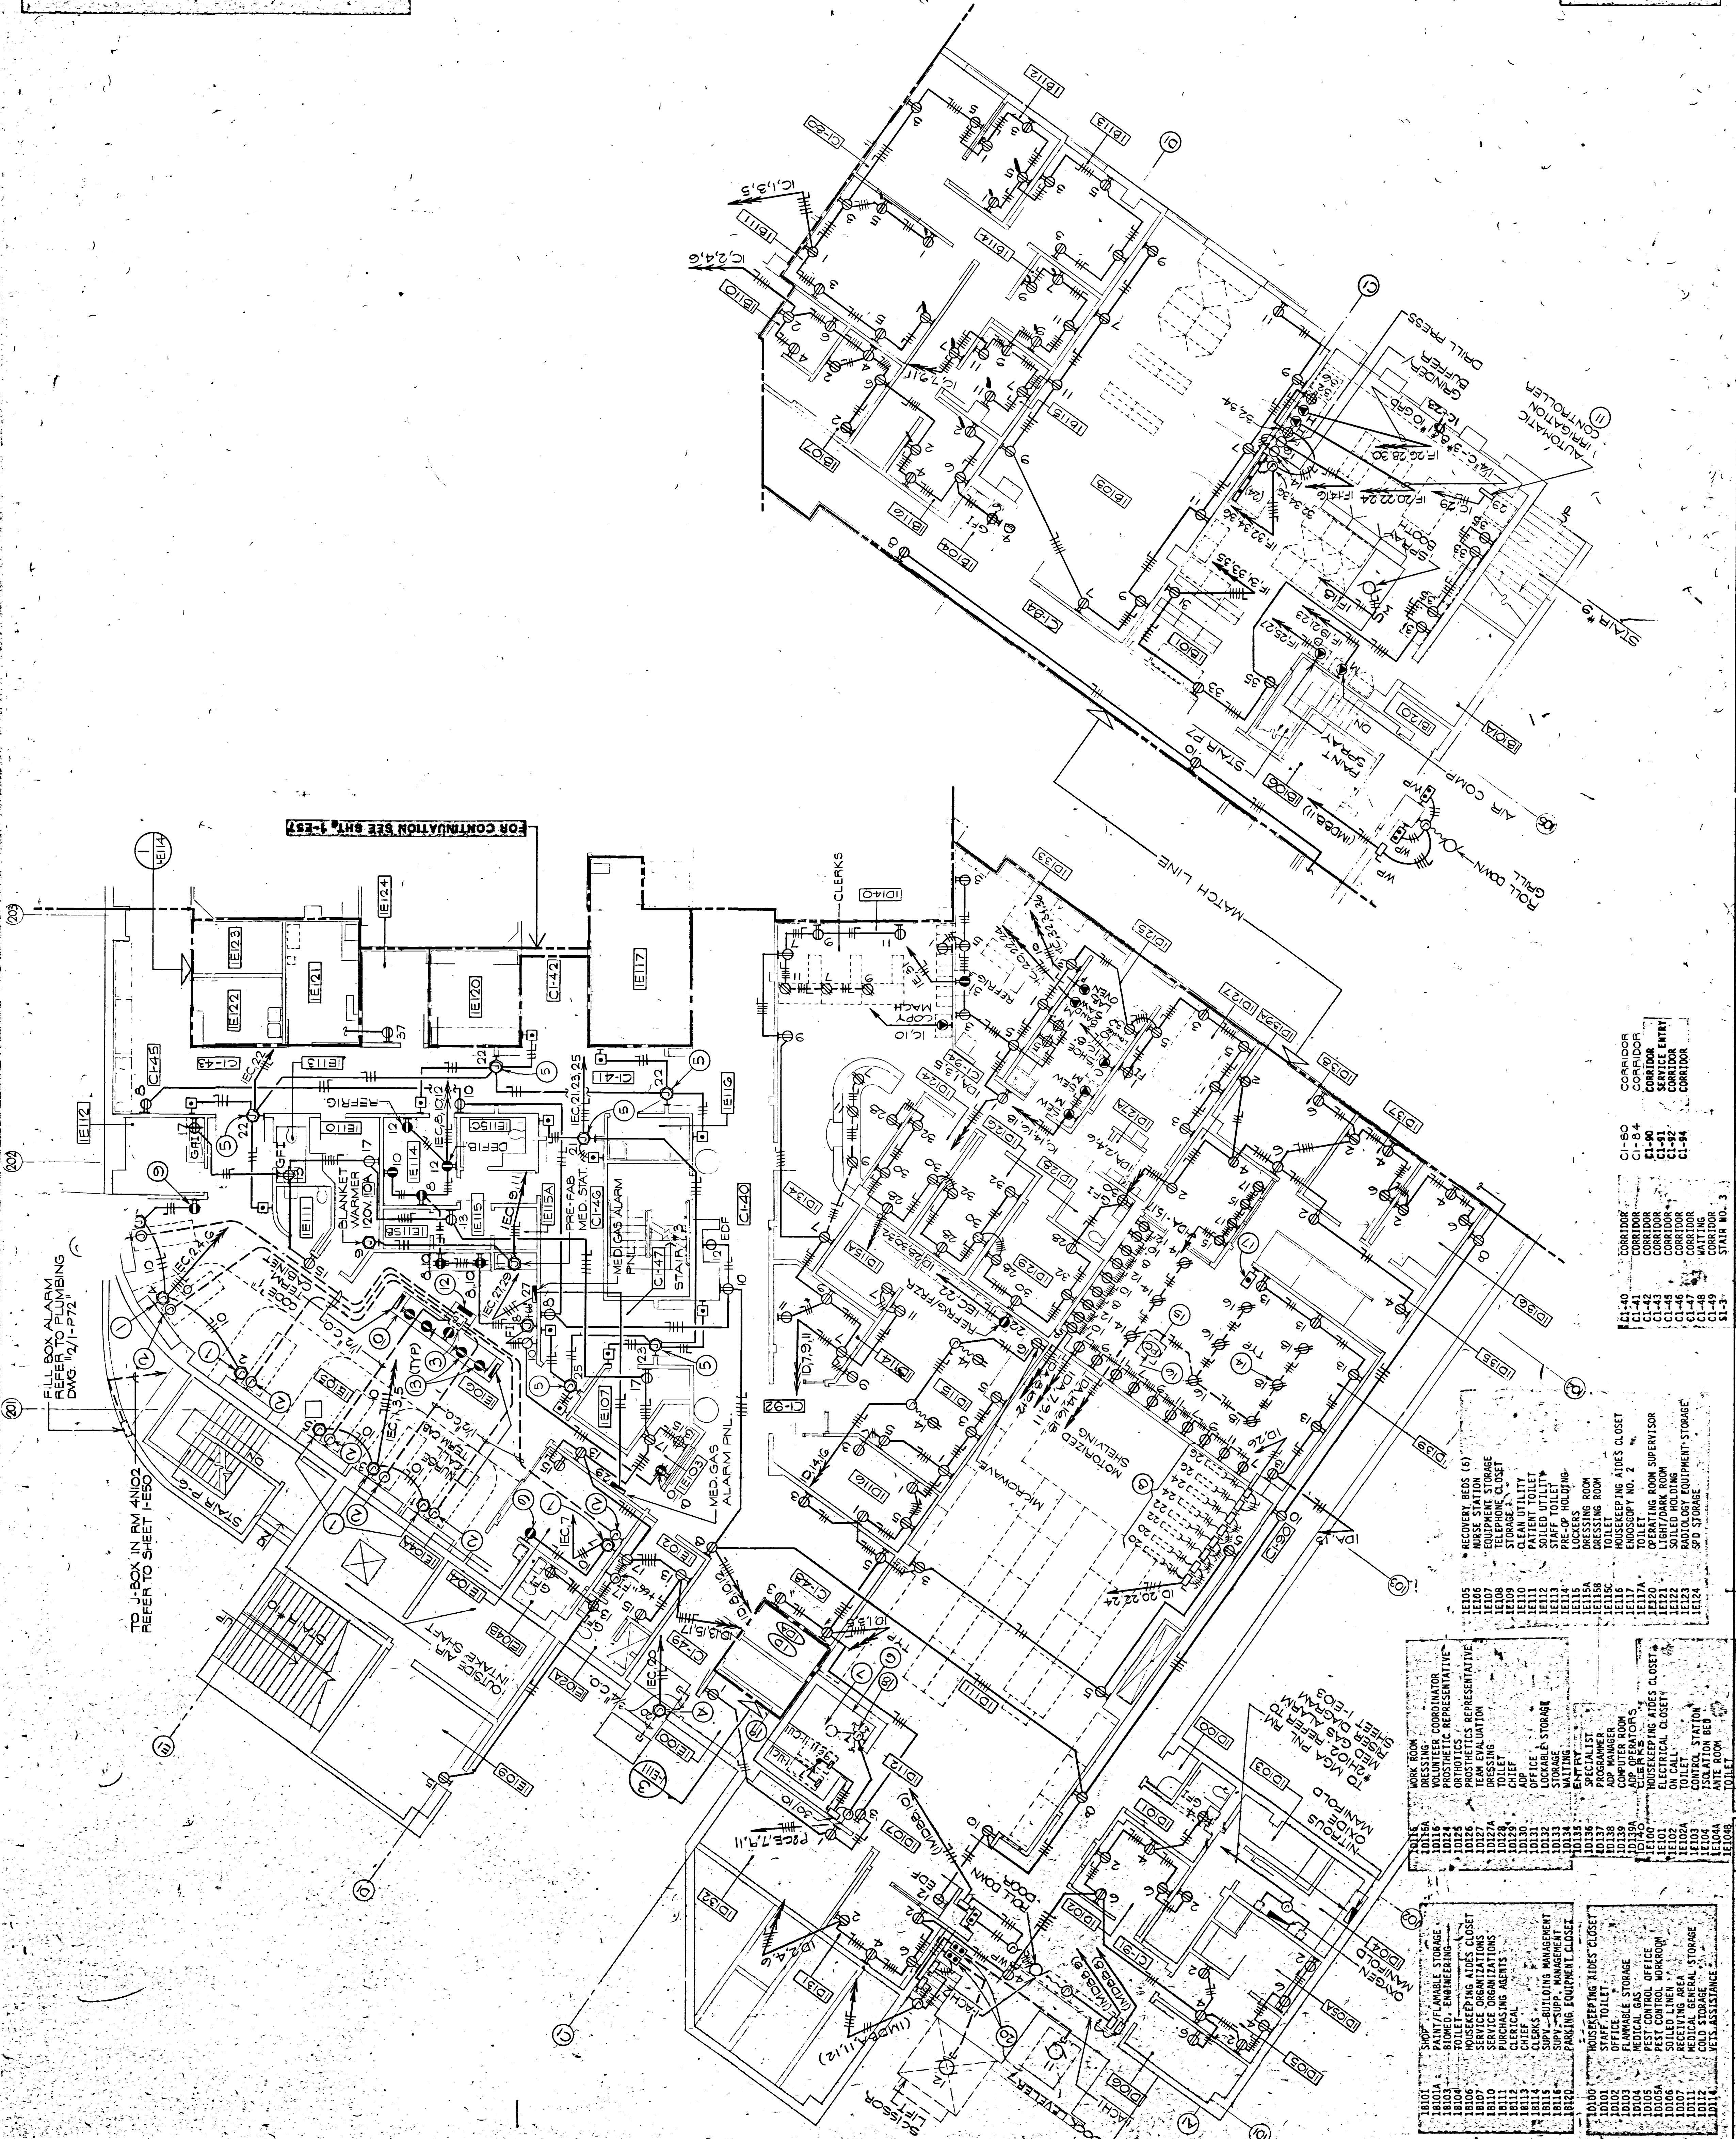
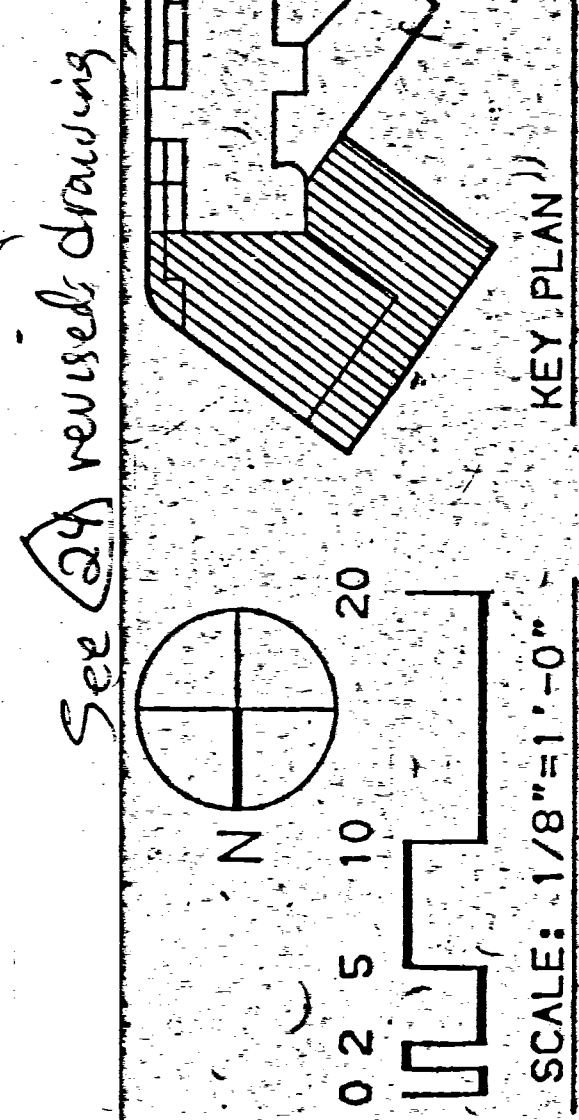

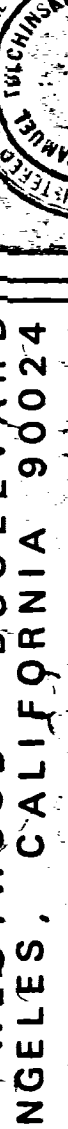


- [illegible]



18001	SHOP	10100	HOUSEKEEPING AIDS CLOSET
18002	PAINT/FINISHES STORAGE	10101	STAFF TOILET
18003	ELECTRICAL ENGINEERING	10102	TOILET
18004	TOILET	10103	FLAMMABLE STORAGE
18006	HOUSEKEEPING AIDS CLOSET	10104	MEDICAL GAS
18007	SERVICE ORGANIZATIONS	10105	PEST CONTROL OFFICE
18008	TOILET	10106	POILED LINEN
18011	PURCHASING AGENTS	10107	RECEIVING AREA
18112	CERAMIC	10108	HOUSEKEEPING AIDS CLOSET
18113	CLERICAL	10109	ELECTRICAL CLOSET
18114	CLERKS	10110	TOILET
18115	SUPV.-BUILDING MANAGEMENT	10111	CONTROL STATION
18116	SUPV.-SUPP. MANAGEMENT	10112	COLD STORAGE
18117	PAKING EQUIPMENT CLOSET	10113	PETS ASSISTANCE
18118	CLERICAL	10114	TOILET
10119	TOILET	10120	HOUSEKEEPING AIDS CLOSET
10121	TOILET	10121	ELECTRICAL CLOSET

BOBBROW/THOMAS AND ASSOCIATES, INC. ARCHITECTS/PLANNERS/CONSULTANTS 1001 WESTWOOD BOULEVARD LOS ANGELES, CALIFORNIA 90024				CYNGA CONSULTING ENGINEERS 33 FLORENCE ENGINEER MECHANICAL AND ELECTRICAL SUITE 309 1180 SOUTH BEVERLY DRIVE MARINA DEL REY, CA 90291 LOS ANGELES, CA 90035		HAYAKAWA ASSOCIATES CONSULTING ENGINEERS 1180 SOUTH BEVERLY DRIVE MARINA DEL REY, CA 90291 LOS ANGELES, CA 90035	
Drawing Title LEVEL 1 NORTH POWER PLAN		Project Title NEW OUTPATIENT CLINIC BUILDING		Date AUG. 9, 1988		Project No. 752-002	
Approved Project Director 		Building Number 1		Checked SKT		Drawn PGB, N.N.	
Drawing No. 1E56		Location LOS ANGELES, CALIFORNIA		Revision 1		Date Aug. 30, 1988	