


# 1 SPD HVAC DUCTWORK PLAN

1/4"=1'-0"

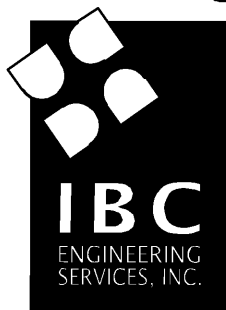

N8 W22195 JOHNSON DR, SUITE 180  
WAUKESHA, WISCONSIN 53186  
262.549.1190 fx 262.549.1620

PROJECT

VA MADISON – SPD  
UPGRADE PROJECT  
VA MEDICAL CENTER – 2500 OVERLOOK TERRACE  
MADISON, WI 53705

REVISION

Amendment 01

DATE

JULY 5, 2011

PROJECT NO.

VA: 607-10-105  
IBC: 2010059

SHEET NO.

MH100  
-01