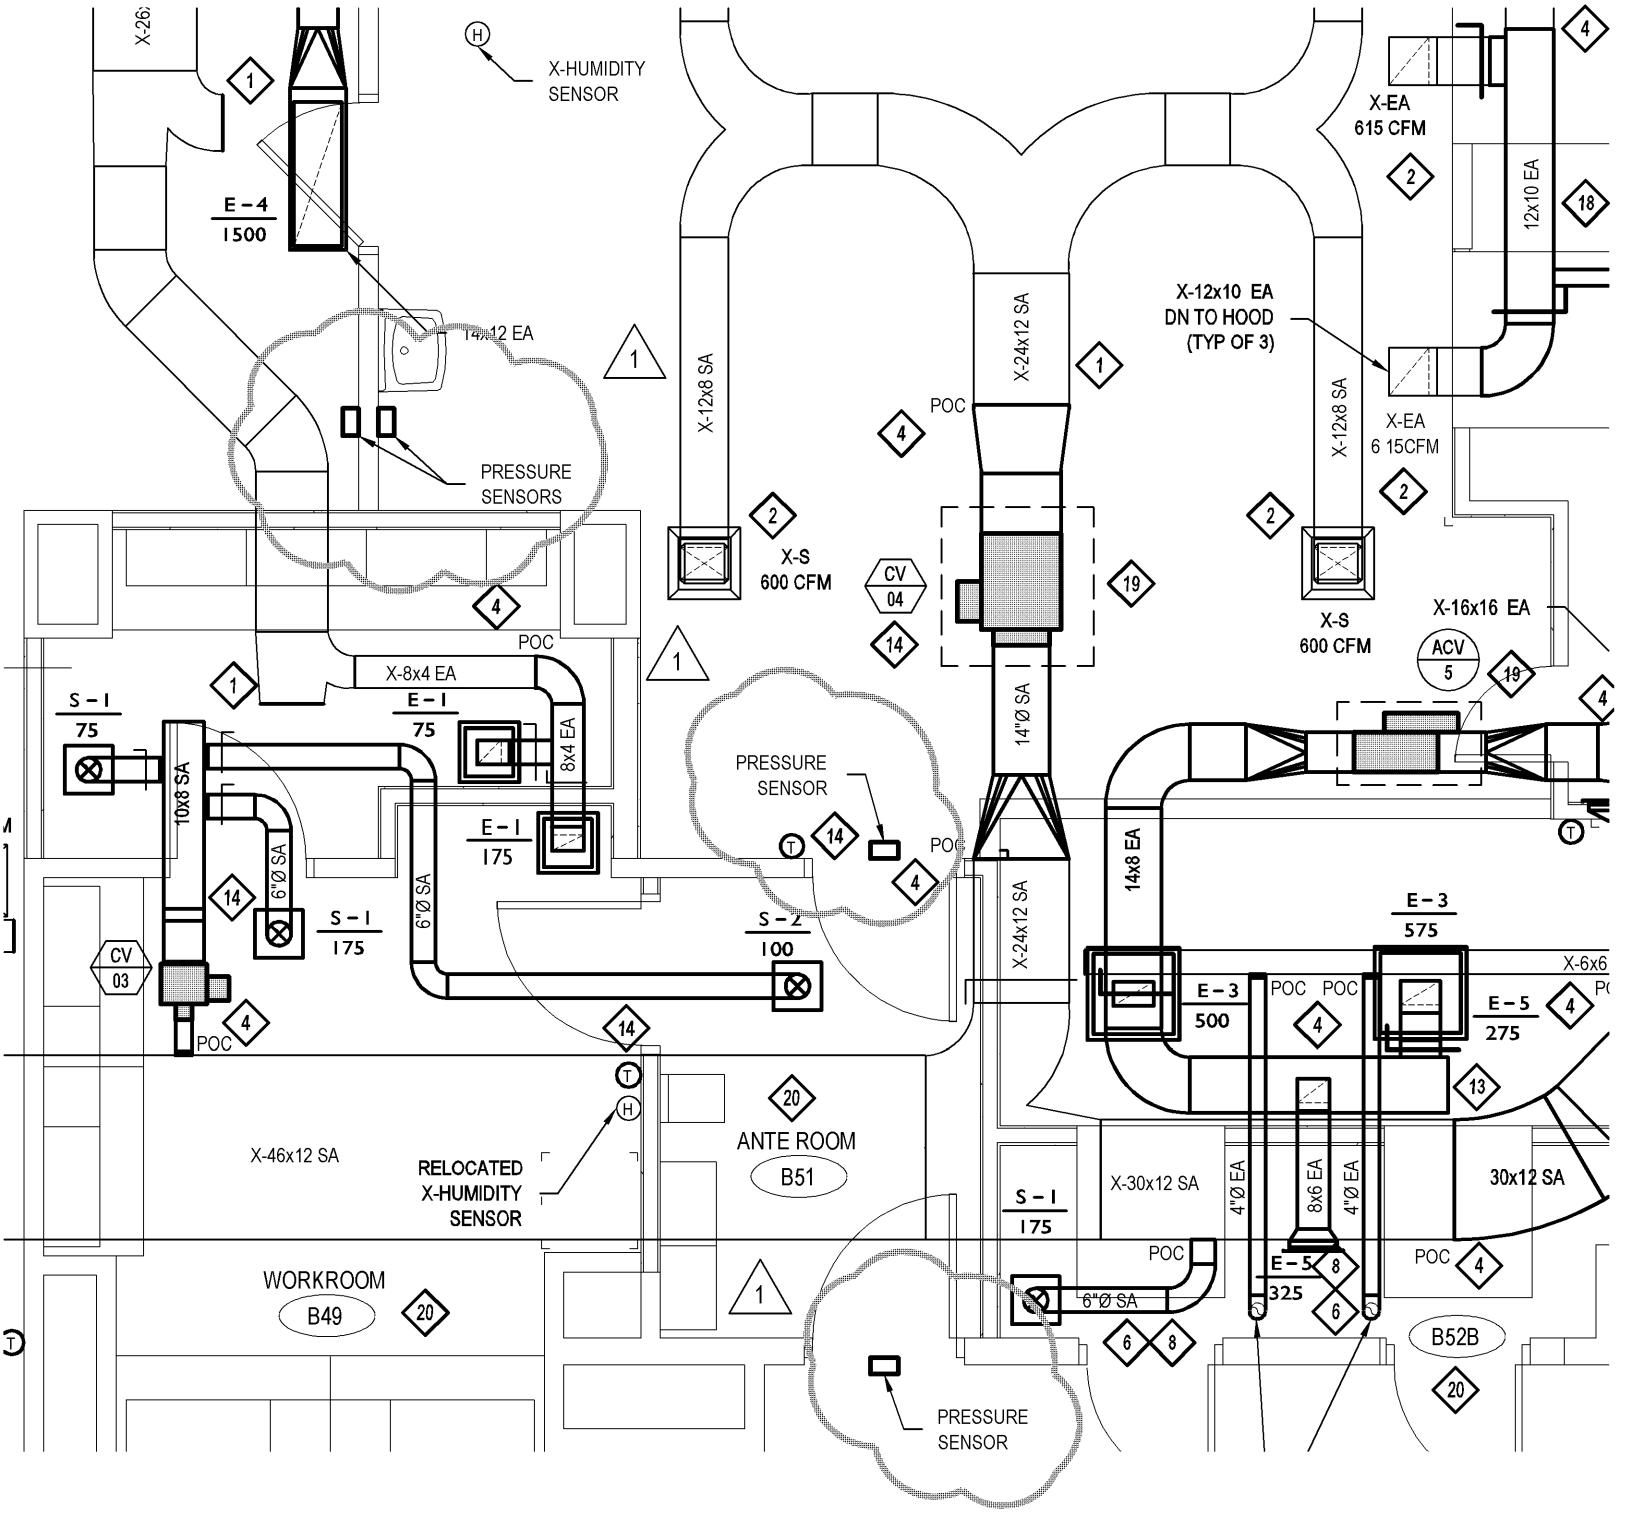

1 SPD HVAC DUCTWORK PLAN

1/4"=1'-0"

IBC ENGINEERING SERVICES, INC.
N8 W22195 JOHNSON DR, SUITE 180
WAUKESHA, WISCONSIN 53186
262.549.1190 fx 262.549.1620

PROJECT

VA MADISON - SPD UPGRADEPROJECT

VA MEDICAL CENTER - 2500 OVERLOOK TERRACE
MADISON, WI 53705

REVISION	Amendment 01
DATE	JULY 5, 2011
PROJECT NO.	VA: 607-10-105 IBC: 2010059
SHEET NO.	MH100 -02