SOUTH ELEVATION

SCALE 1/4" = 1'-0"

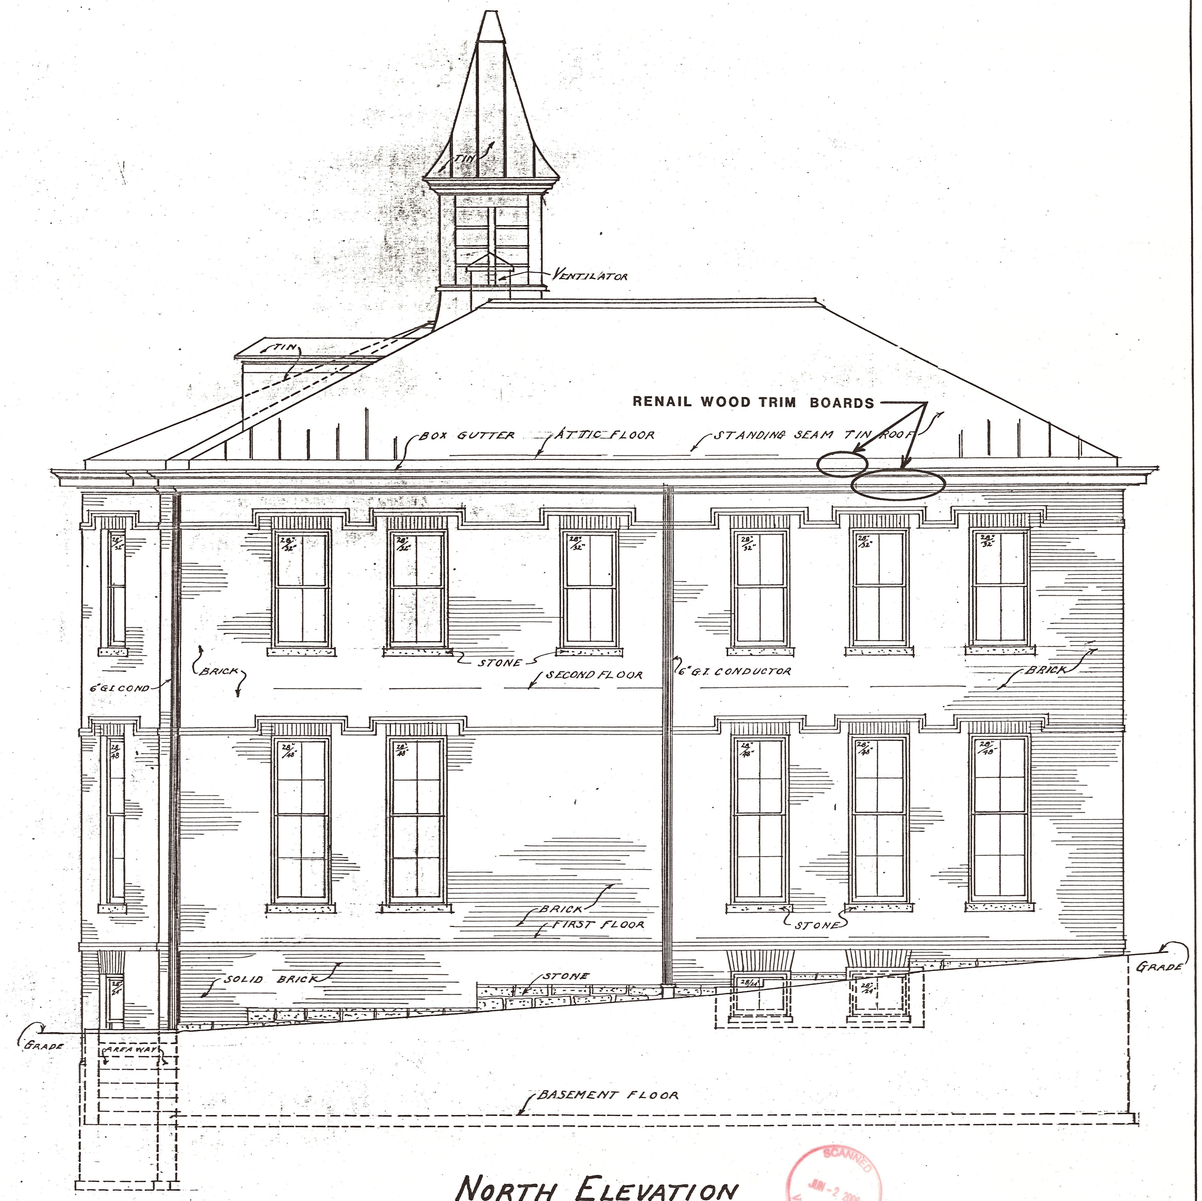

NORTH ELEVATION

SCALE 1/4" = 1'-0"

SCANNED JAN - 2 2009 VA MILWAUKEE

VETERANS ADMINISTRATION CENTER
MILWAUKEE, WISCONSIN 53193

FEB 1 - 1989

THOMAS A. HEYDEL
CHIEF, ENGINEERING SERVICE

NORTH & SOUTH ELEVATION BLDG No. 1		
VETERANS ADMINISTRATION FACILITY ~~MILWAUKEE~~ WIS.		
DRAWN MATZKE	BUILDING No. 1	1-56 R1
CHECKED		
DATE 4-17-35		