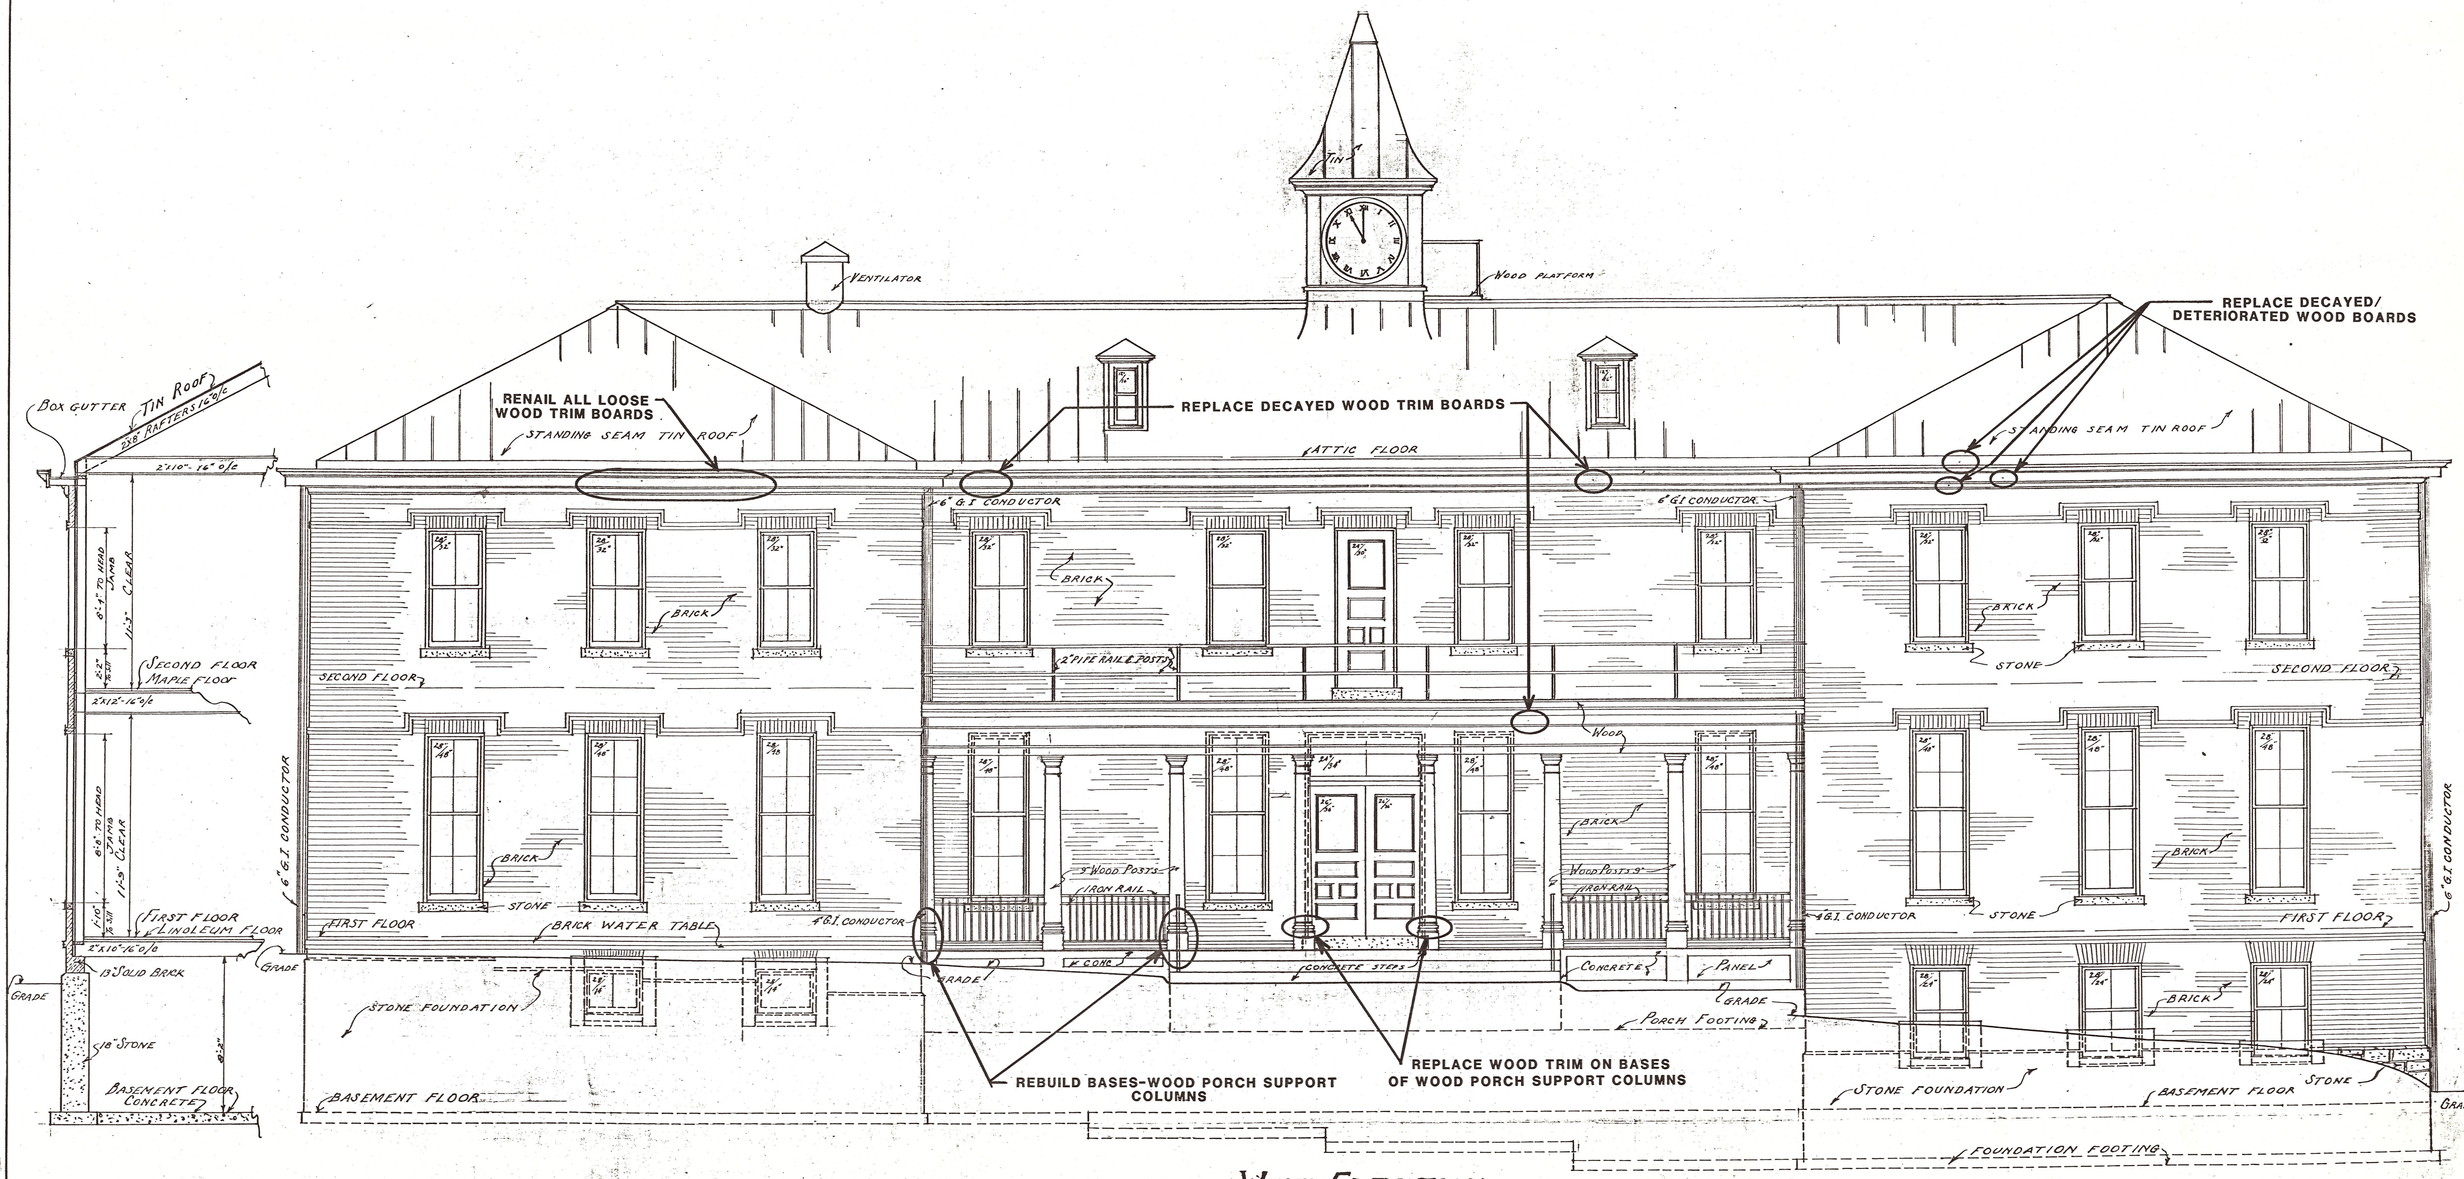

WEST ELEVATION

Scale 1/4" = 1'-0"

VETERANS ADMINISTRATION CENTER
MILWAUKEE, WISCONSIN 53193
FEB 1 - 1989
THOMAS A. HEYDEL
CHIEF, ENGINEERING SERVICE

WEST ELEVATION BLDG No. 1	
VETERANS ADMINISTRATIONS FACILITY MILWAUKEE WIS.	
DRAWN MATZKE	BUILDING No 1
CHECKED	
DATE 4-12-35	

1-54
R1