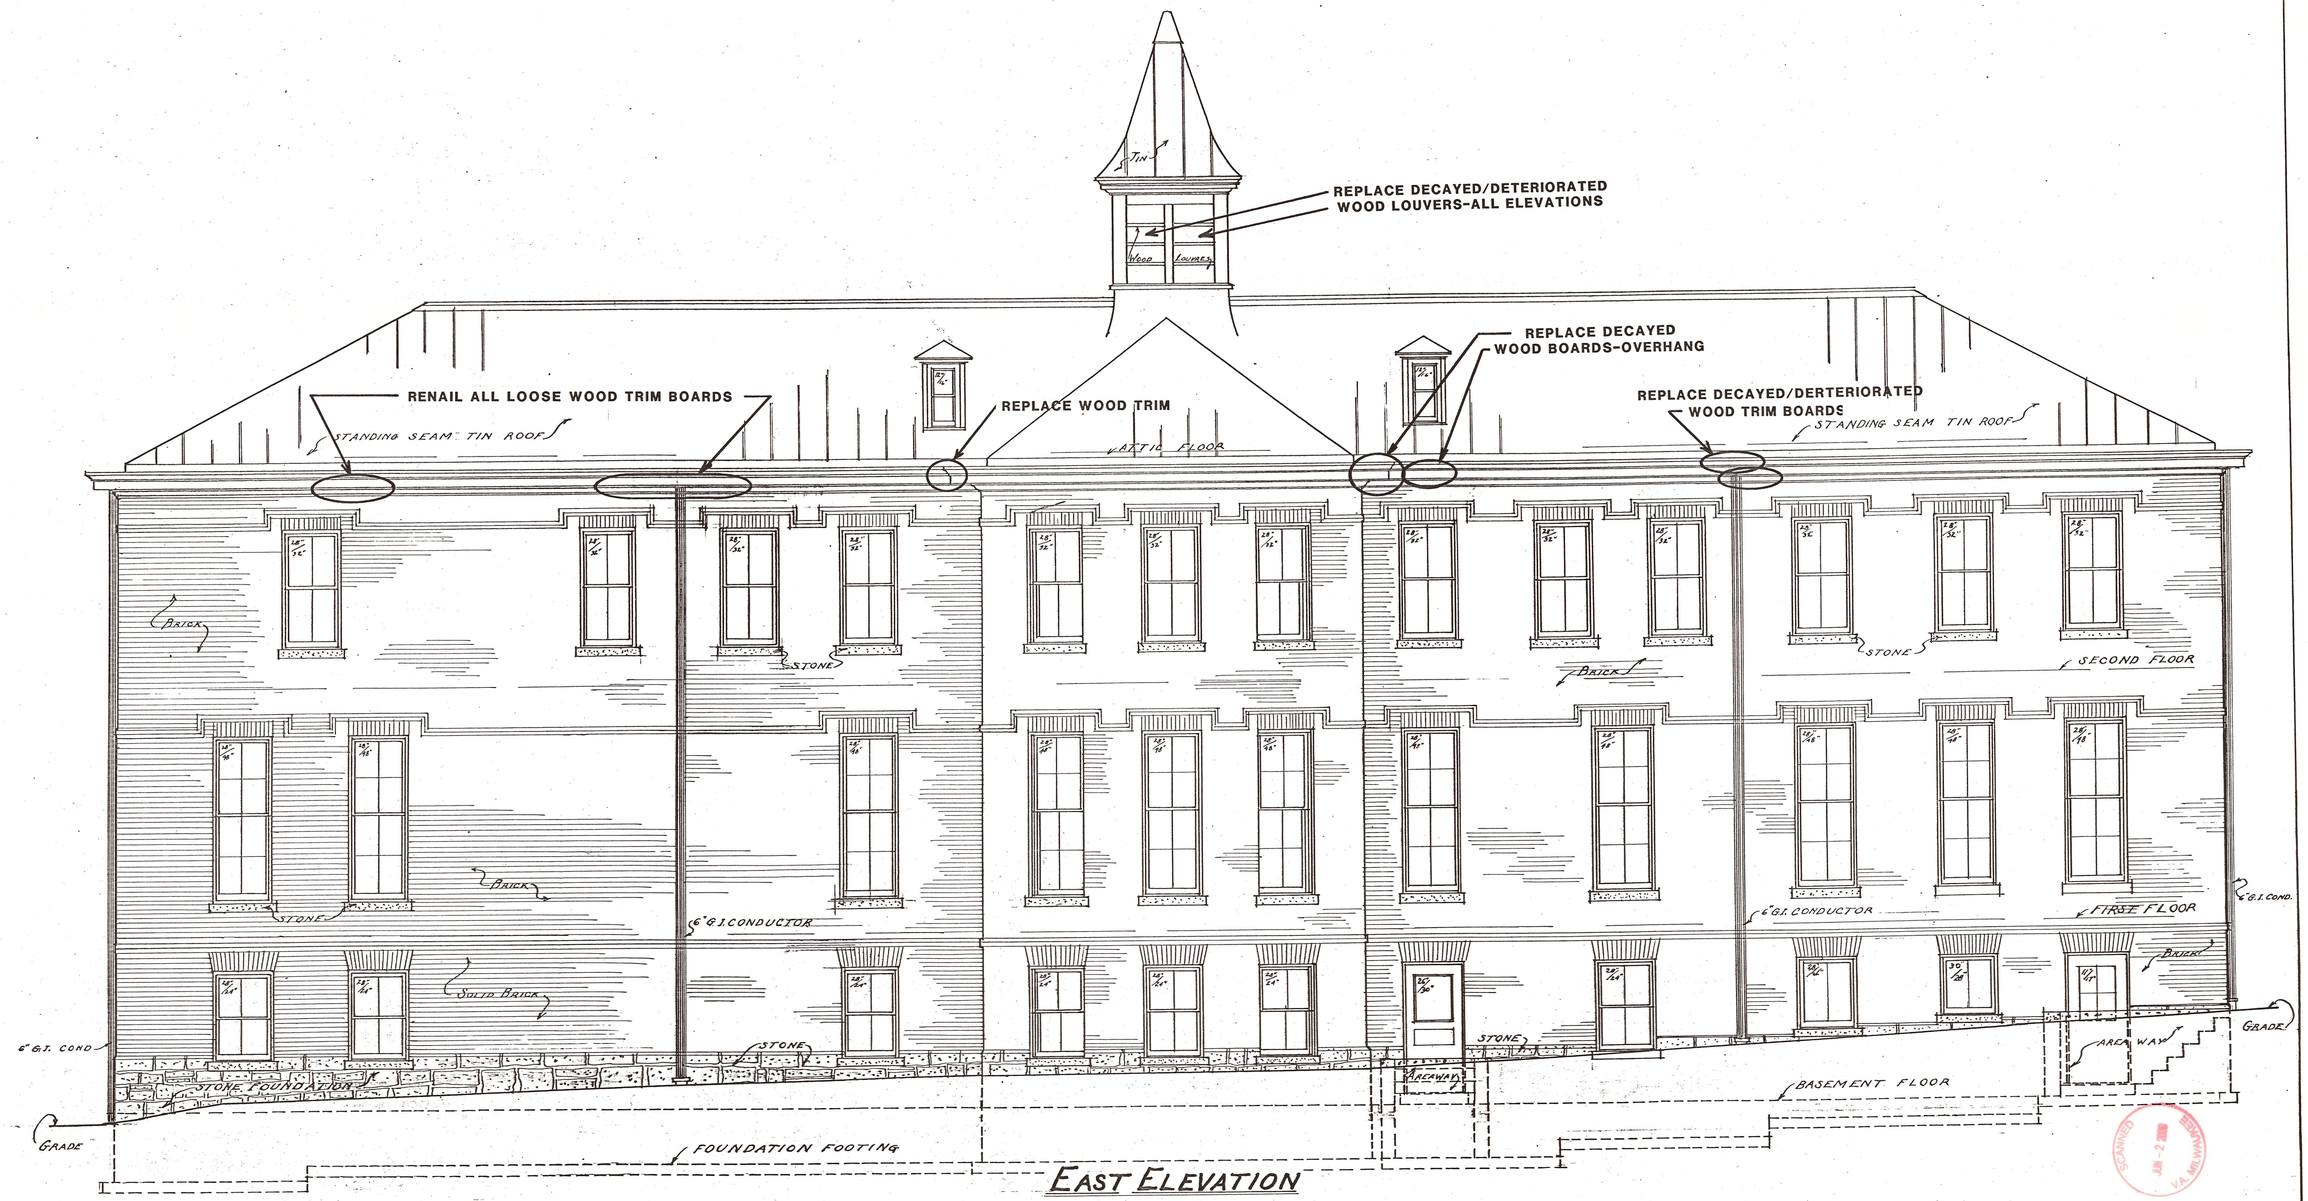

EAST ELEVATION

SCALE 1/4" = 1'-0"

VETERANS ADMINISTRATION CENTER
MILWAUKEE, WISCONSIN 53193

FEB 1 - 1989

THOMAS A. HEYLER
CHIEF ENGINEERING SERVICE

EAST ELEVATION BLDG No. 1	
VETERANS ADMINISTRATION FACILITY ~~MILWAUKEE~~ WIS.	
DRAWN MATZKE	BUILDING NO. 1.
CHECKED	
DATE 4-16-35	

1-55
R1

SCANNED JAN - 2 2008 V.A. MILWAUKEE