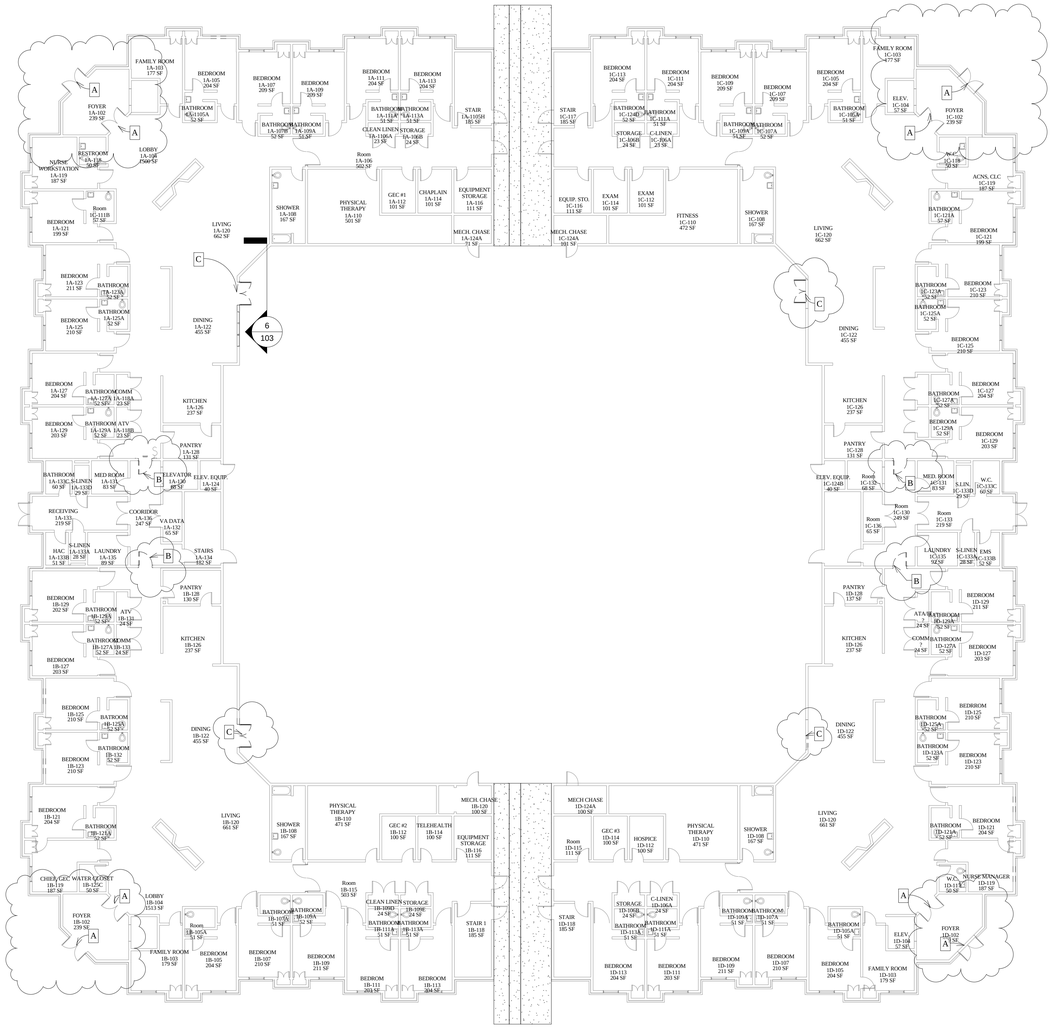

1 Level 1 - EXISTING
1/16" = 1'-0"

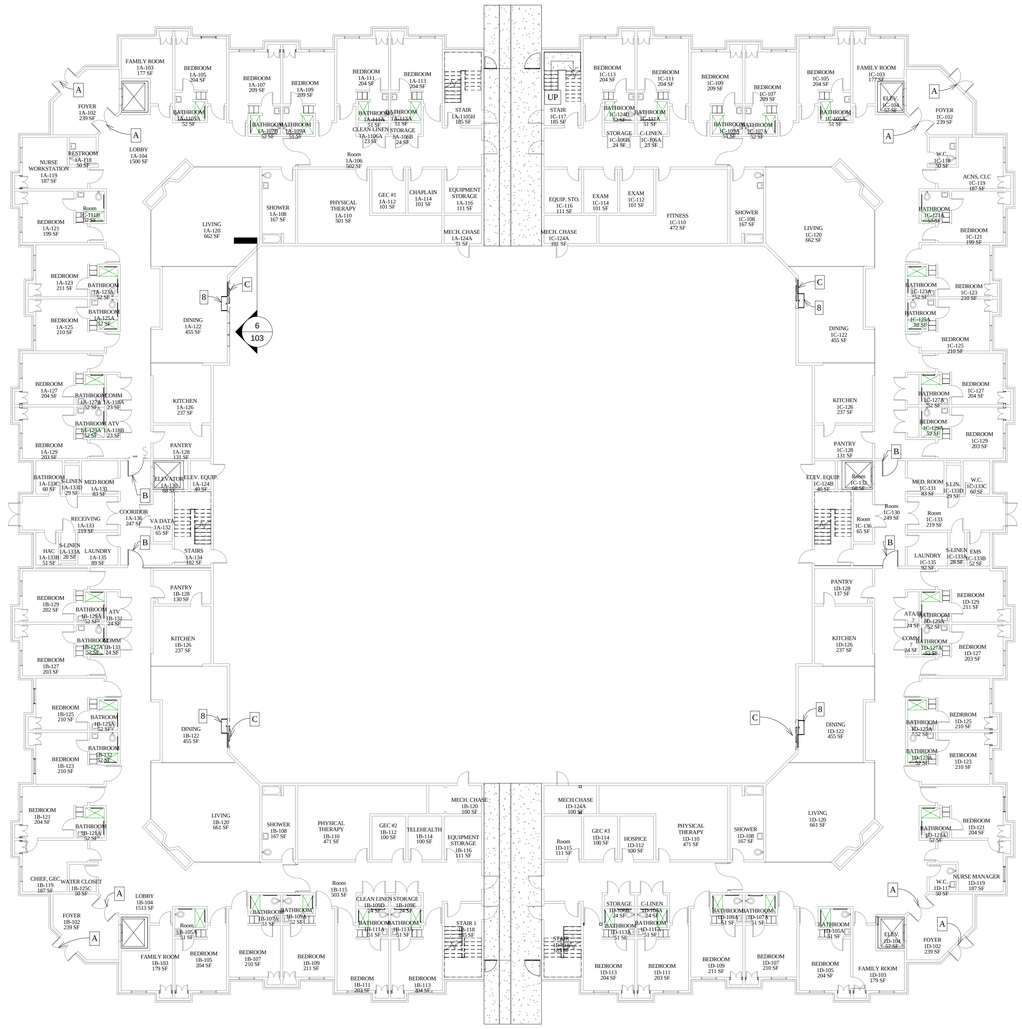

2 Level 1 New
1/16" = 1'-0"

GENERAL NOTES
1/4" = 1'-0"

1. ALL FINISHES TO MATCH EXISTING FINISHES
2. FIELD VERIFY ALL DIMENSIONS, DOOR TYPES, AND DOOR SWINGS.

NOTE BY SYMBOL
1/4" = 1'-0"

1 EXISTING FIRE STROBE TO BE RELOCATED AS NEEDED
2 EXISTING FIRE PULL TO BE RELOCATED AS NEEDED
3 EXISTING KEY PAD TO BE RELOCATED AS NEEDED
4 EXISTING LIGHT SWITCH TO BE RELOCATED AS NEEDED
5 EXISTING PANIC BAR TO BE REMOVED AND INSTALLED ON NEW DOOR
6 EXISTING AUTOMATIC OPENER TO BE REMOVED AND INSTALLED ON NEW DOOR
7 EXISTING EXIT SIGN TO REMAIN
8 NEW AIR CURTAIN TO BE INSTALLED

A DOORS ARE TO HAVE SINGLE AUTOMATIC OPENERS REMOVED AND REPLACE WITH DOUBLES.
B CURRENT 42" WIDE DOORS TO BE REMOVED AND REPLACED WITH 1-HR FIRE RATED DOORS OF THE SAME TYPE. RELOCATED ADJACENT INFASTRUCTURE AS NEEDED
C CURRENT DOORS TO BE REMOVED AND REPLACED WITH A 48" SLIDING DOOR. NEW DOOR AND ADJACENT PANEL(S) ARE TO BE NO WIDER THAN THE EXISTING OPENING (6'). NEW DOOR TO BE INSTALLED WITH AN AIR CURTAIN THAT COVERS THE WIDTH OF THE NEW DOOR OPENING

Revisions:	Date

CONSULTANTS:

ARCHITECT/ENGINEERS:

Drawing Title: LEVEL 1

Approved: Project Director

Project Title: BUILDING 221 DOOR REPLACEMENTS AND UPGRADES

Location: TEMPLE, TX

Date: 2/26/2016 10:42:14 AM

Checked: CY

Drawn: TB

Project Number: N/A

Building Number: 221

Drawing Number: 101

Office of Construction and Facilities Management

Department of Veterans Affairs

VA FORM 08-6231