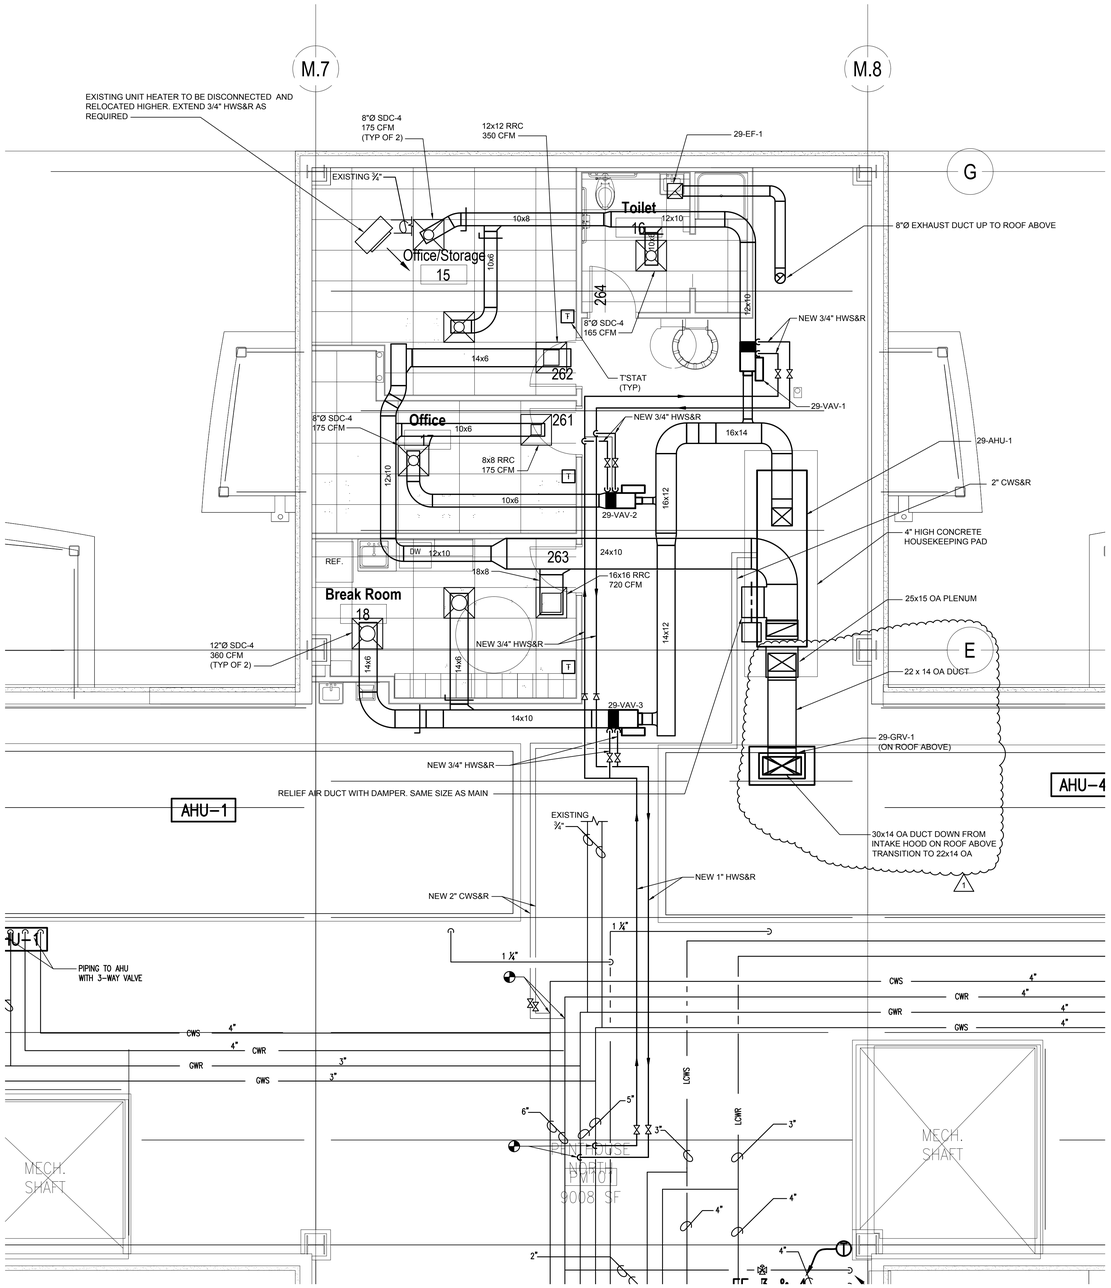

NORTH

A 29M-1 **BUILDING 29 - PENTHOUSE PLAN**

SCALE: 1/4" = 1'-0"

CONTRACT DOCUMENTS SUBMISSION

Revisions	Date
1 AMENDMENT No. 5	10/07/11

Professional Stamp/Seal: COMMONWEALTH OF PENNSYLVANIA REGISTERED PROFESSIONAL ENGINEER DAVID E. PALMER 043216-E 6-23-11

H.F. LENZ COMPANY
Engineers
Planners
Surveyors
Energy Consultants
1407 Scalp Avenue Johnstown, PA 15904
Phone: 814-269-9300 FAX: 814-269-9301
cadd@hflenz.com www.hflenz.com

IKM
architecture
planning
interior design
IKM Incorporated
One PPG Place
Pittsburgh, PA 15222
412-281-1337
www.ikminc.com

Approved:
Approved: Director, VA Pittsburgh Healthcare System
Approved:
Approved: Associate Director, VAPHCS
Approved:
Approved: Vice President, Facilities Management
Approved: Site Manager
Approved:
Approved: Manager, Projects Section
Approved: Project Manager

Drawing Title: BUILDING 29 PARTIAL PENTHOUSE PLAN MECHANICAL

Project Title: COOLING TOWER REPLACEMENT

Date: 23 JUNE 2011
Project No. 646-09-126
Building No. 8
Scale 1/4" = 1'-0"
Drawn/Checked CRE/DEP
Location: VA PITTSBURGH HEALTHCARE SYSTEM UNIVERSITY DRIVE DIVISION PITTSBURGH, PA 15240

DRAWING NO. 29M-1
Dwg. X of X

Veterans Affairs

*U.S. GOVERNMENT PRINTING OFFICE: 1983-400-285

VA FORM 08-6231, FEB. 1983