


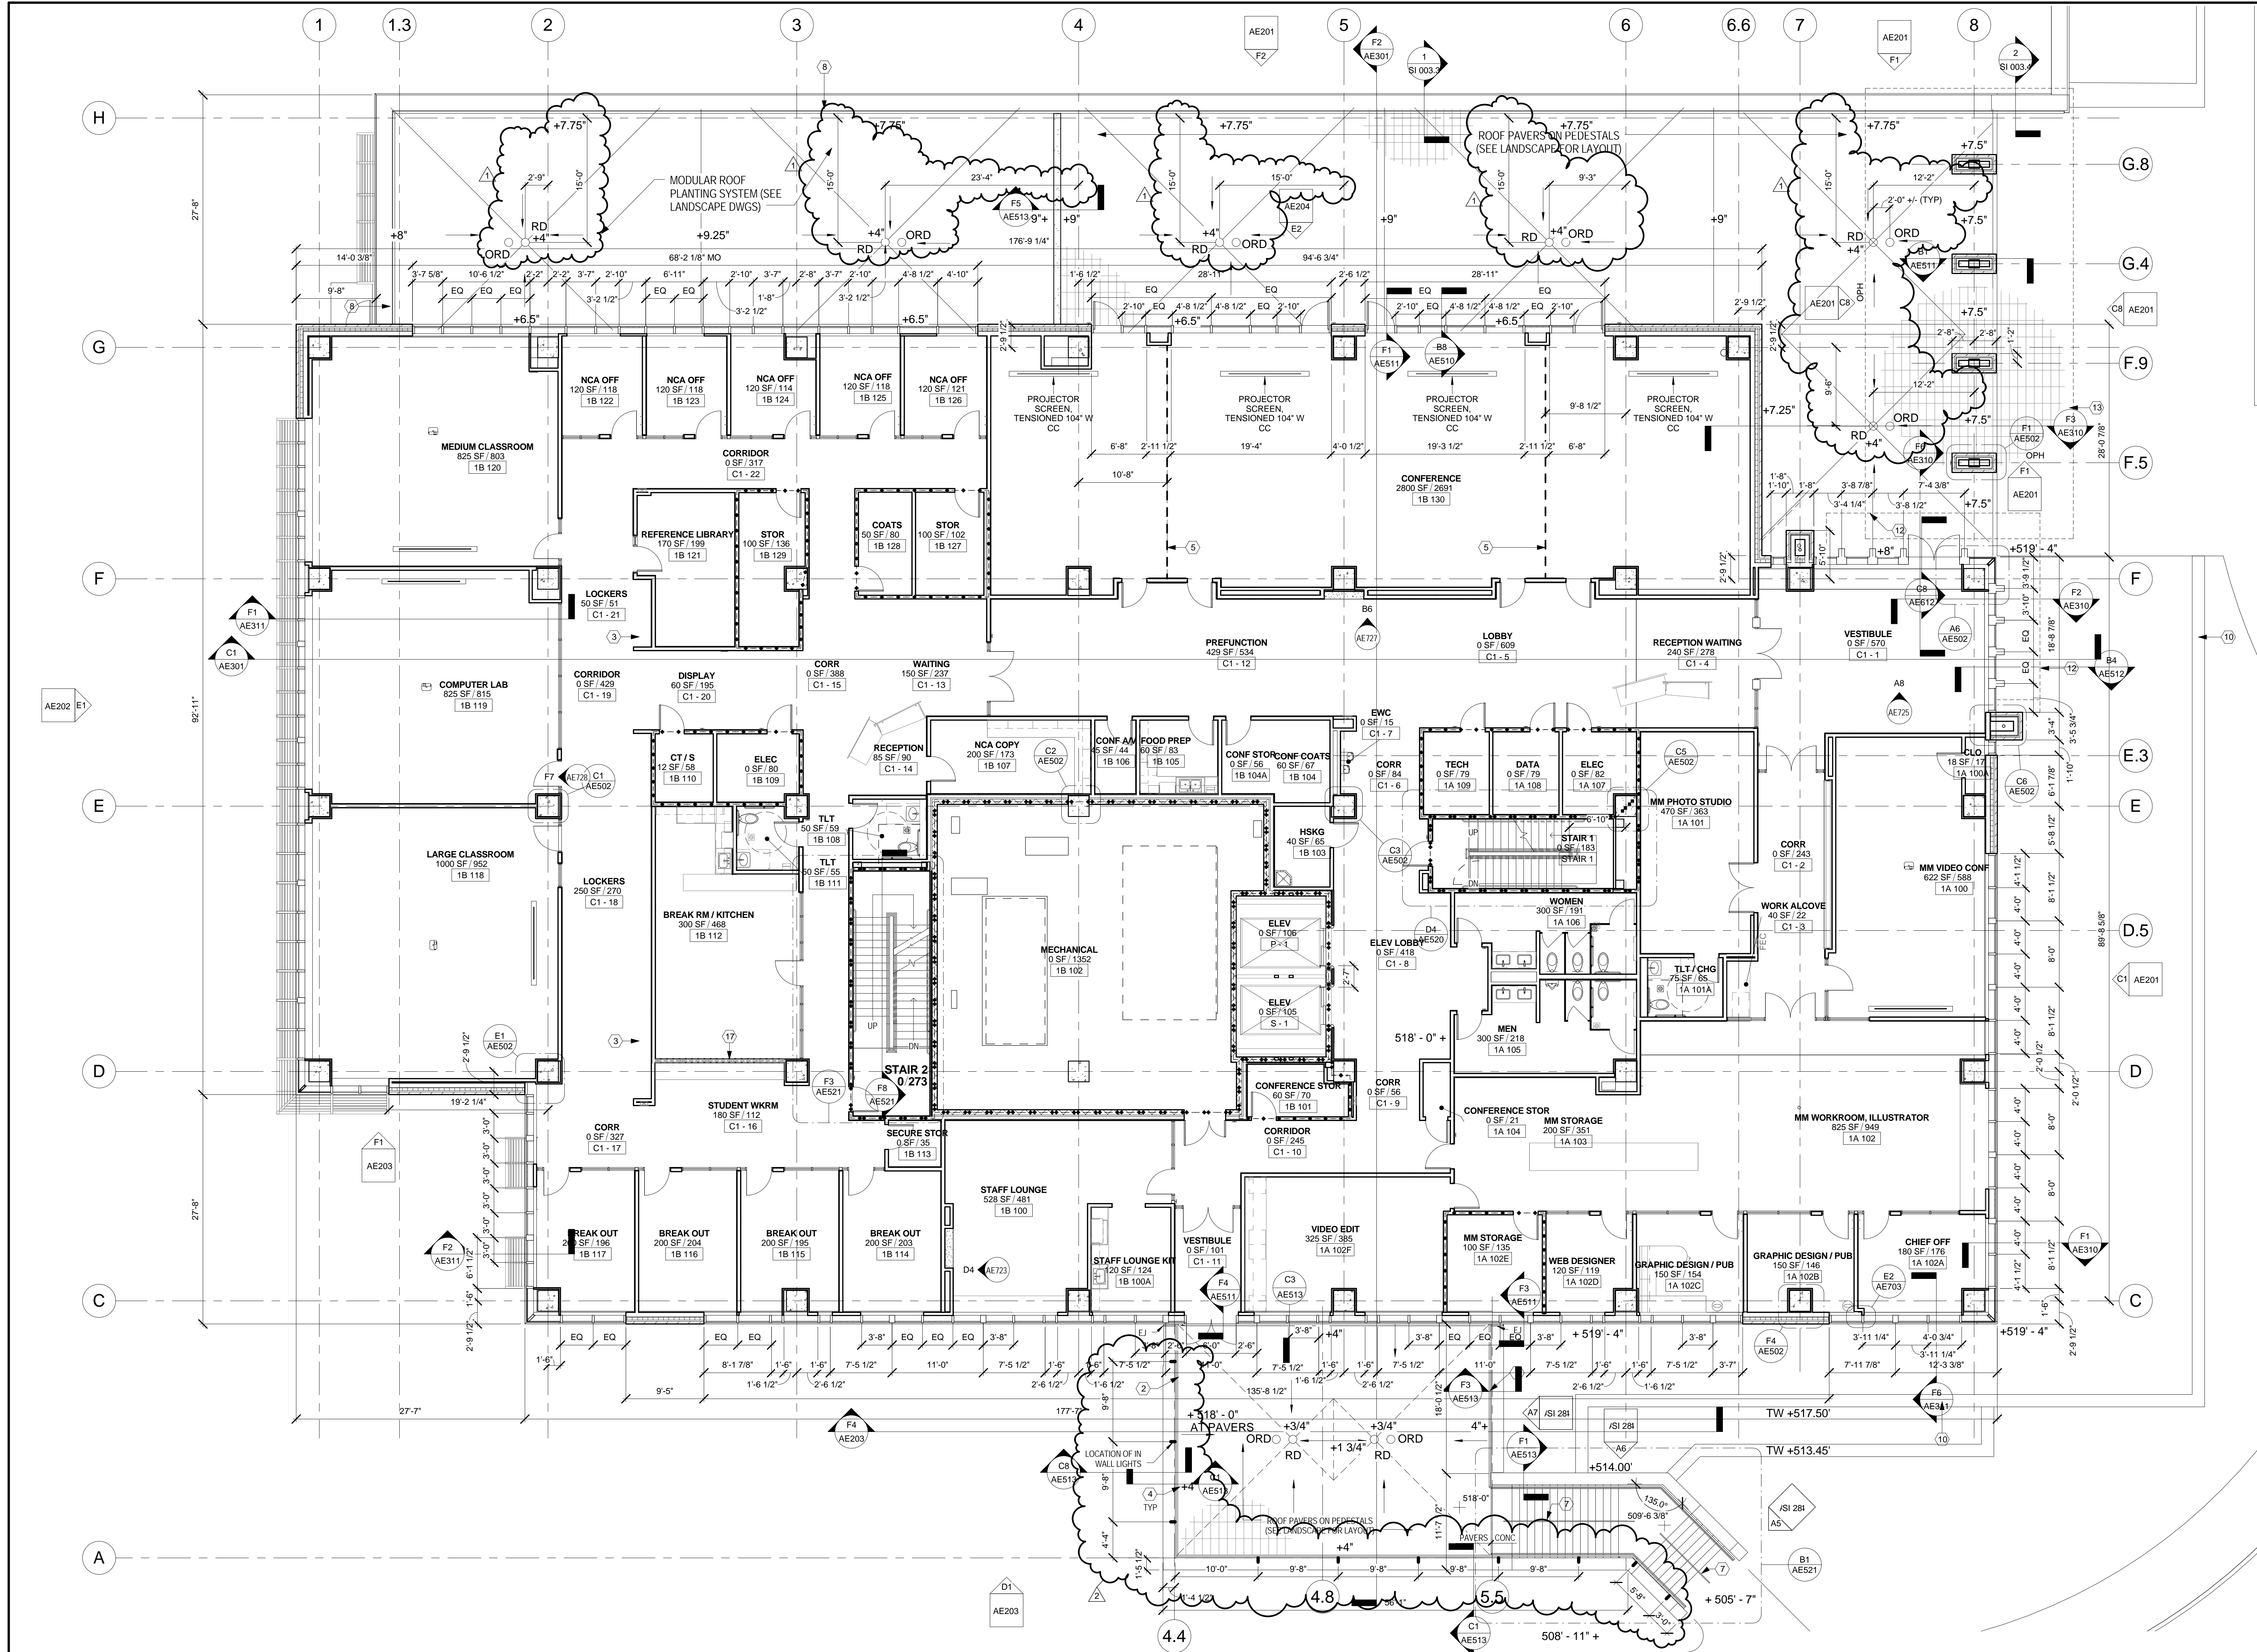

- GENERAL NOTES:**
- A. NOT ALL KEYED NOTES USED ON THIS SHEET.
- B. EXTERIOR DIMENSIONS ARE SHOWN ON THE LOWEST LEVEL WHERE THEY APPLY. DIMENSIONS REMAIN THE SAME ASCENDING THE BUILDING UNLESS THE CONFIGURATION CHANGES. IF SO, THE DIMENSIONS WILL BE ADDED AND/OR CHANGED ON THE FIRST FLOOR WHERE THEY APPLY.
- KEYED NOTES - PLAN**
1. EXTENT OF RAISED/COMPUTER FLOOR (SHADED AREA)
 2. GUARDRAIL
 3. RECESSED LOCKERS
 4. VALUE INDICATES THICKNESS OF INSULATION ON ROOF DECK
 5. RETRACTABLE VERTICAL ACUSTICAL WALL PANEL SYSTEM
 6. ROOF TOP EQUIPMENT (SEE MECHANICAL)
 7. HANDRAIL
 8. GUARDRAIL (MASONRY PARAPET W/STEEL HANDRAIL)
 9. WALKPAD
 10. STONE WALL - SEE LANDSCAPE
 11. SCREEN WALL PER E5/AE513. REFER TO CIVIL FOR EXTENT.
 12. ROOF ABOVE
 13. CANOPY ABOVE
 14. TRANSOM ABOVE - 2'-0" HIGH. BOTTOM OF TRANSOM AT 7'-0" AFF
 15. REMOVABLE GUARDRAIL SECTION
 16. INSULATION DRAINAGE PANELS
 17. BORROWLITE. SEE BORROWLITE SCHEDULE ON SHEET AE610
 18. LIMIT OF RECESSED SLAB DIMENSION
 19. REFER TO DETAIL D1/AE530 FOR PARTITION AT EDGE OF RECESSED SLAB. PARTITION OVERHANGS SLAB 7/8"
 20. PARTITIONS WITHIN RECESSED FLOOR AREA (DENOTED BY SHADING PATTERN) EXTEND TO RECESSED FLOOR SLAB

CONSULTANTS:			CERTIFICATE OF AUTHORITY: 000842		ARCHITECT/ENGINEERS:		Drawing Title		Project Title		Project Number	
STRUCTURAL ENGINEER: KPFF CONSULTING ENGINEERS 1630 DES PERES ROAD, SUITE 100 ST. LOUIS, MO 63131 PHONE: (314) 835-0524			HAZARDOUS MATERIALS: ALTEC ENVIRONMENTAL CONSULTING, LLC P.O. BOX 17867 SHREVEPORT, LA 71138-0867 PHONE: (720) 283-8182		CHRISTNER		LEVEL 1 FLOOR PLAN		TENANT BUILDING		657-313D	
MECHANICAL/ELECTRICAL/PLUMBING: KJWW ENGINEERING CONSULTANTS #15 SUNNEN DRIVE, SUITE 104 ST. LOUIS, MO 63143 PHONE: (314) 645-1132			ESTIMATING: KRAMER BUILDING GROUP, INC. 1204 WASHINGTON AVENUE, SUITE 200 ST. LOUIS, MO 63103 PHONE: (314) 862-5344		ARCHITECTS DESIGNERS PLANNERS LANDSCAPE ARCHITECTS 168 N. MERAMEC AVENUE ST. LOUIS, MISSOURI 63105 TEL 314 725 2927 FAX 314 725 2928 CHRISTNERINC.COM		Approved: Project Director <i>[Signature]</i>		Location JEFFERSON BARRACKS DIVISION		Building Number 56	
2 7/22/14 SI 019 re: RFI 166			1 6/12/14 RFI 130				Date 29 OCTOBER 2012		Checked ADB		Drawn AK	
Revisions											AE101 Dwg. 96 of 177	

VA FORM 08-6231 PRINTED ON 9/21/2015 12:13:17 PM - ORIGINAL SIZE OF SHEET IS 30" X 42"