



GENERAL NOTES

1. WALLS ARE WALL TYPE B13 UNLESS NOTED OTHERWISE.  
2. FINISHED ROOM SIDE ONLY.

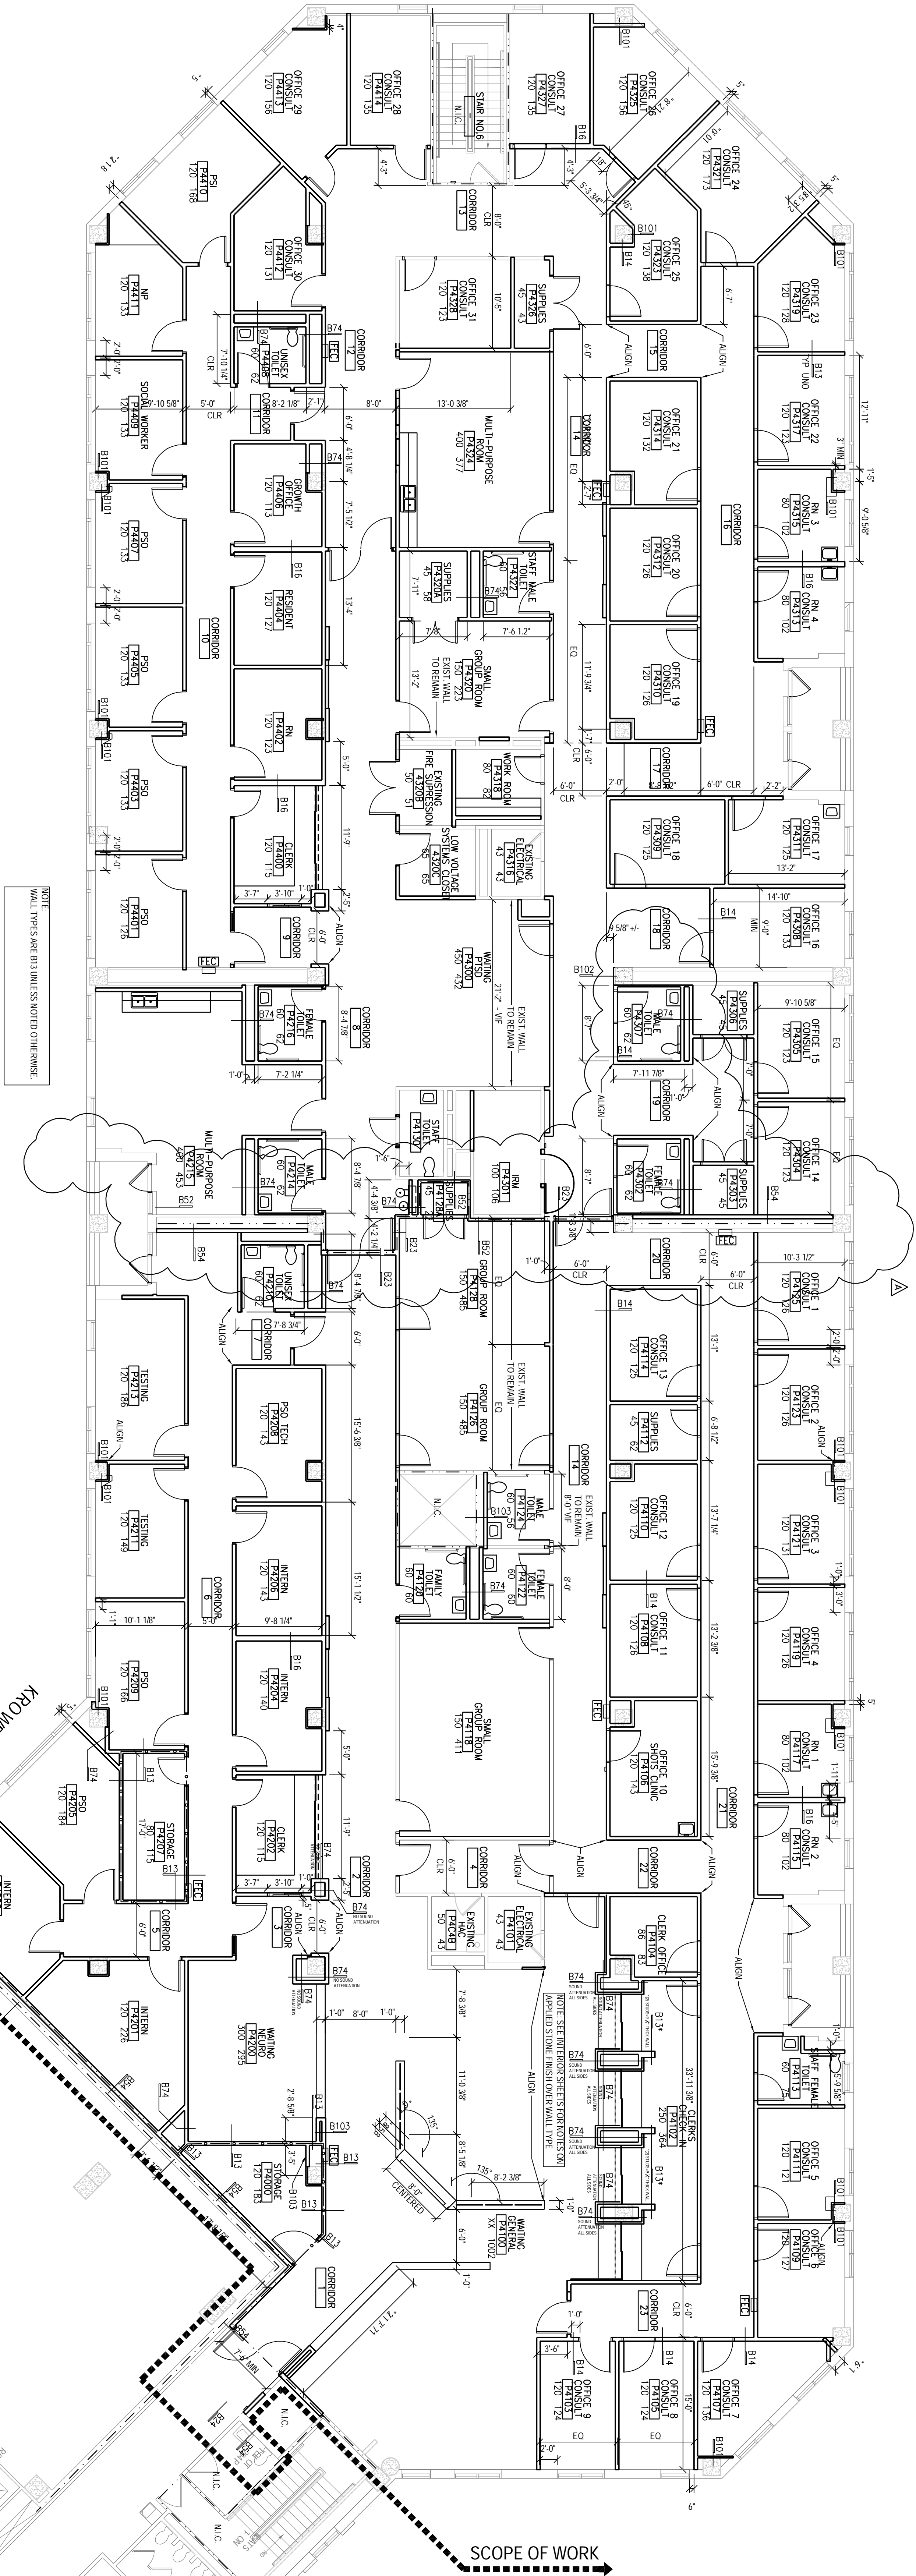

KEY PLAN (NTS)

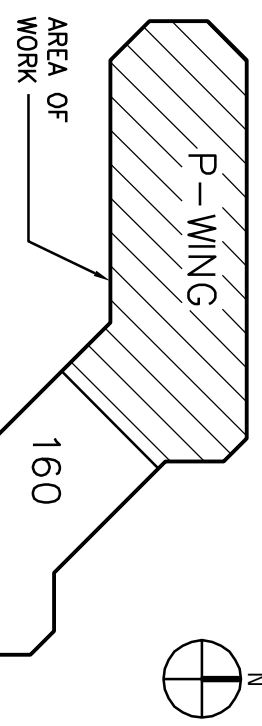

THIRD FLOOR DIMENSION PLAN – MENTAL HEALTH P-SIDE

SCALE: 1/8" = 1'-0"



100% FINAL CONSTRUCTION DOCUMENTS - FULLY SPRINKLERED

--	--	