




| | |
|------------|----------|
| ADDENDUM A | Revision |
| | Date |
| | 3/25/16 |

CONSULTANTS:

FreemanWhite
8845 Reid Oak Blvd
Charlotte, NC 28217-5593
Phone: 704.523.2230
Fax: 704.523.2235

Legend Engineering, Inc.
215 Park Ave SE
Atlanta, GA 30302-0657
Phone: 800.843.4848
Fax: 800.843.4848

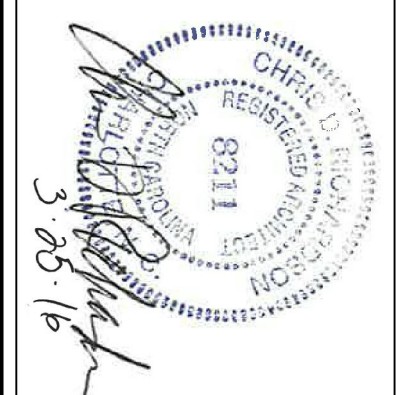

ARCHITECT/ENGINEERS:

Atriax
www.atriagroup.com

Atriax, LLC
102 3rd Avenue, NE
PO Box 1629, Hickory, NC 28603
Phone: 828.315.9962
Fax: 828.315.9964
NC Engineering License No.: P-2014
NC Architectural License No.: 51254

Drawing Title
ARCHITECTURAL CEILING PLAN:
THIRD FLOOR P-SIDE PARTIAL PLAN

Approved Project Director

Project Title
RENOVATE P-SIDE FOR
SUPER POD PHASE 2

Location
JFH OULLEN VAMC

Building Number
160

DWG
DECEMBER 21, 2015

Checked
TAA

Drawn
DTW

DWG
AE103


of
18

Office of Construction and Facilities Management



Department of Veterans Affairs

100% FINAL CONSTRUCTION DOCUMENTS - FULLY SPRINKLERED

BUILDING 160
THIRD FLOOR

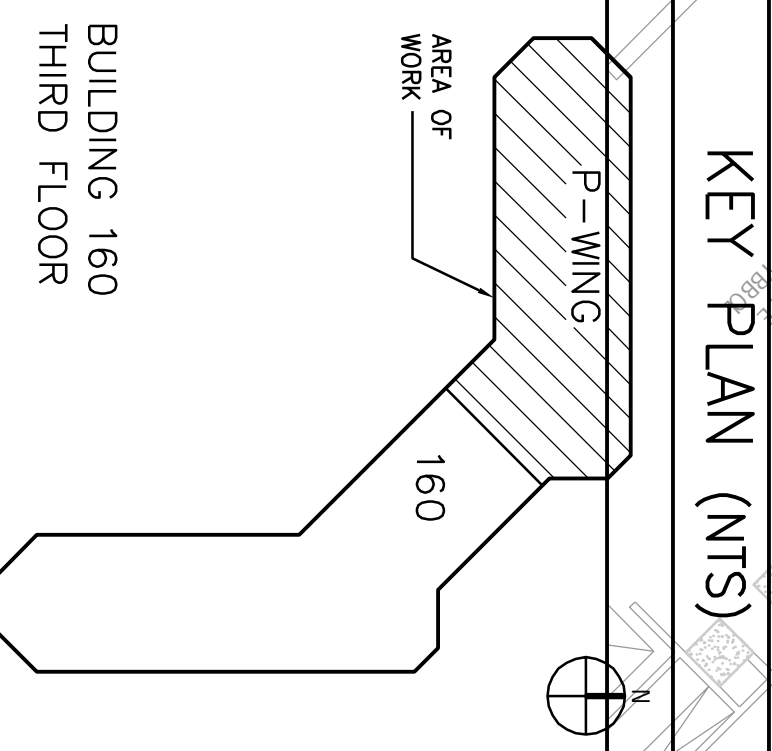

1 THIRD FLOOR REFLECTED CEILING PLAN – MENTAL HEALTH P-SIDE
SCALE: 1/8" = 1'-0"

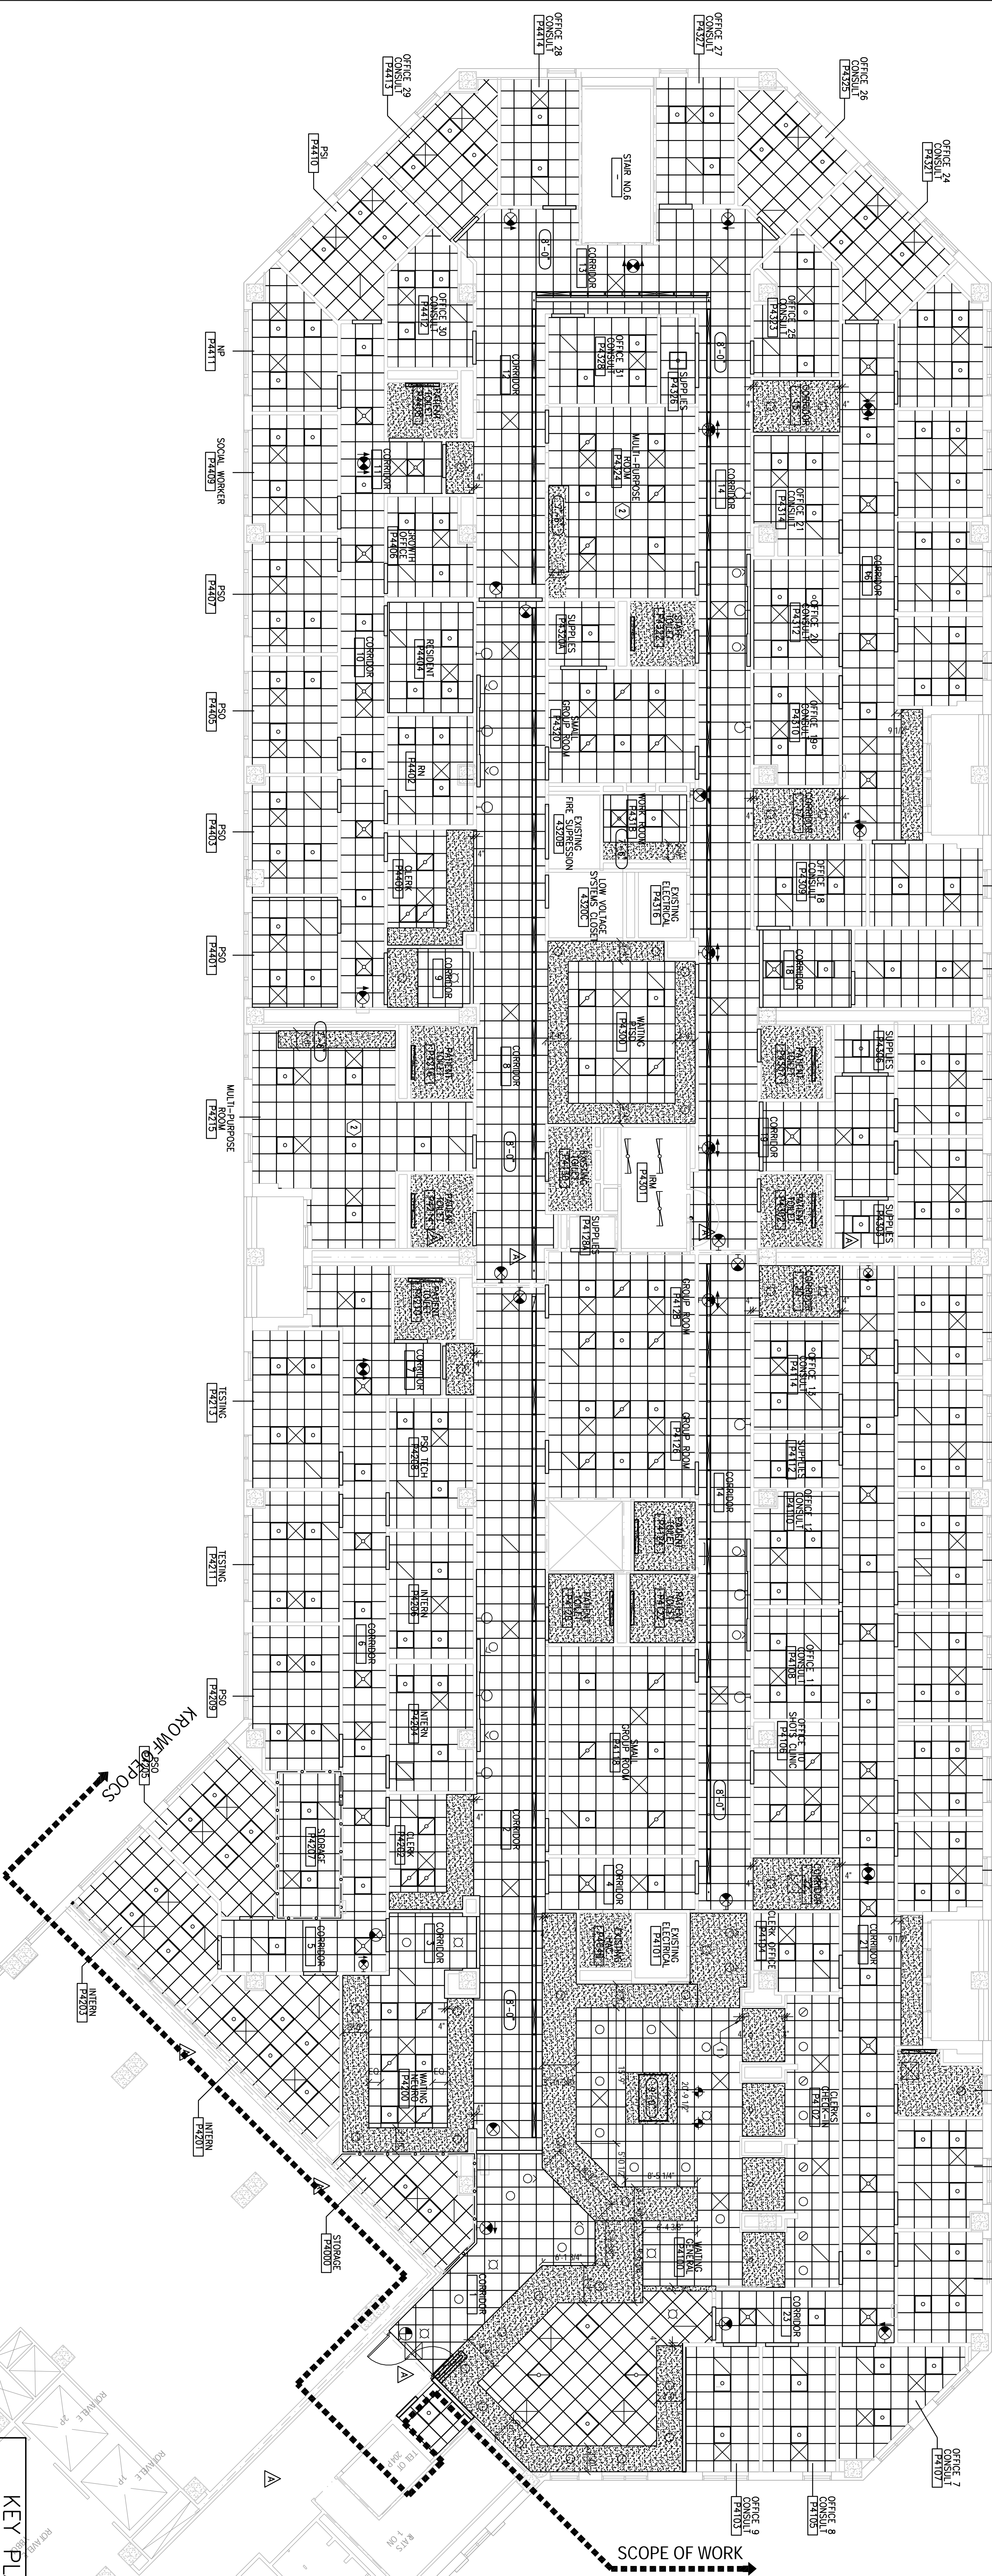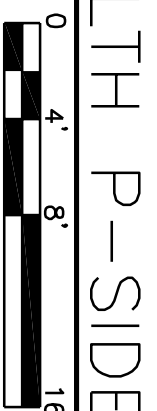

| LEGEND | GENERAL NOTES |
|--|---|
| <ul style="list-style-type: none">PRIMARY LIMITS OF PHASEEXISTING CONST.NEW CONSTRUCTIONUNDERSTANDING OF STRUCTURE ABOVESTRUCTURE ABOVECEILING BOARDCEILING HEIGHT ABOVE FLOOR | <ul style="list-style-type: none">RECESSED EXIT LIGHTWALL SCONCEMECHANICAL SUPPLYMECHANICAL RETURN GRILLEMECHANICAL EXHAUST GRILLEXXX CAMERA |
| <ul style="list-style-type: none">ALUM SOFFIT WITH COUNTER BELOW TYP.CEILING MOUNTED PROJECTOR | <ol style="list-style-type: none">MAJOR MECHANICAL AND ELECTRICAL ITEMS ARE SHOWN ON THIS DRAWING FOR GENERAL LOCATION AND ELECTRICAL DRAWING FOR INFORMATION. DESCRIBE THE SYSTEMS TO WHICH THEY ARE MOUNTED DEVICES.REFER TO G DRAWINGS FOR GENERAL.ACoustical CEILING TILE SHALL BE 8'-0" H.ALL TOILET ROOM OPSHOW CEILING SHALL BE 8'-0" H.UNLESS NOTED OTHERWISE ALL OPSHOW CEILING SHALL BE 8'-0" H.REFER TO INTERIOR DRAWINGS FOR ACoustical, CEILING TILE AND PAINT.REFER TO ELECTRICAL DRAWINGS FOR FIXTURE TYPES AND SPECIFICATIONS.REFER ACoustical CEILING TILE ON ROOM. |