



KEYED NOTES		GENERAL NOTES	
A.	PLUMBING CONTRACTOR SHALL	D.	ALL SANITARY WASTE PIPING IS
	REMOVE EXISTING AND ADD NEW		BELOW FLOOR AND VENT PIPING IS
	WITH OWNER ANY SHUT DOWN OF		EXISTING SYSTEMS OR SPACES IN
	EXISTING SYSTEMS OR SPACES IN		OTHERWISE.
B.	THIS SHEET INDICATES SEQUENCE	C.	REFER TO SHEETS PP303 & PP304
	OF WORK WITH ASSOCIATED PHASE.		FOR NEW WORK SANITARY & VENT
	OF WORK WITH ASSOCIATED PHASE.		RISERS.
	OF WORK WITH ASSOCIATED PHASE.		

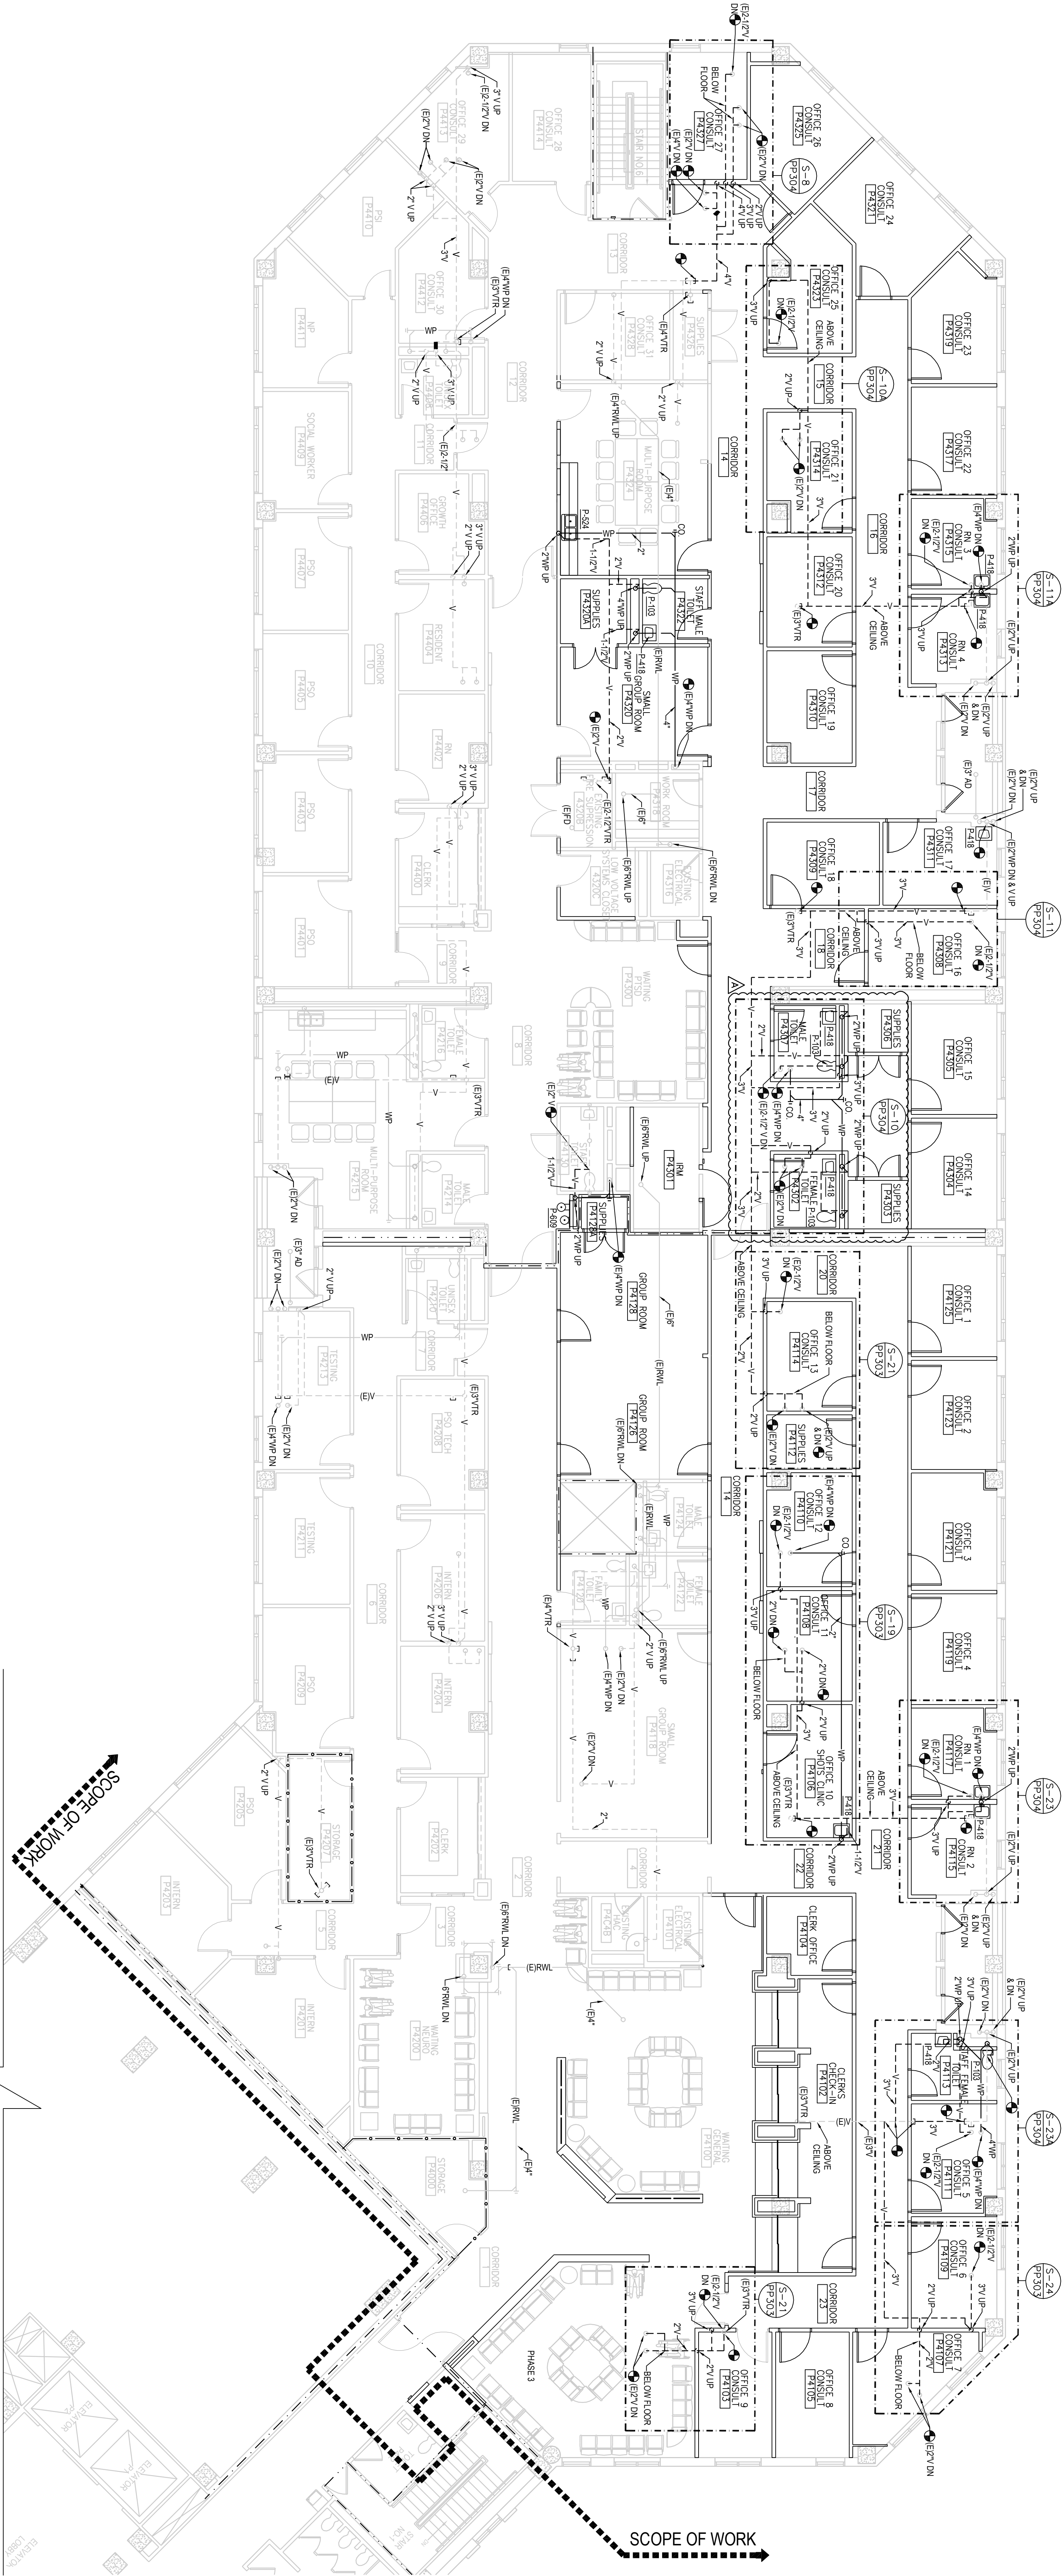

1 PLUMBING THIRD FLOOR PHASING PLAN – WASTE & VENT (PHASE 2)
SCALE: 1/8" = 1'-0"

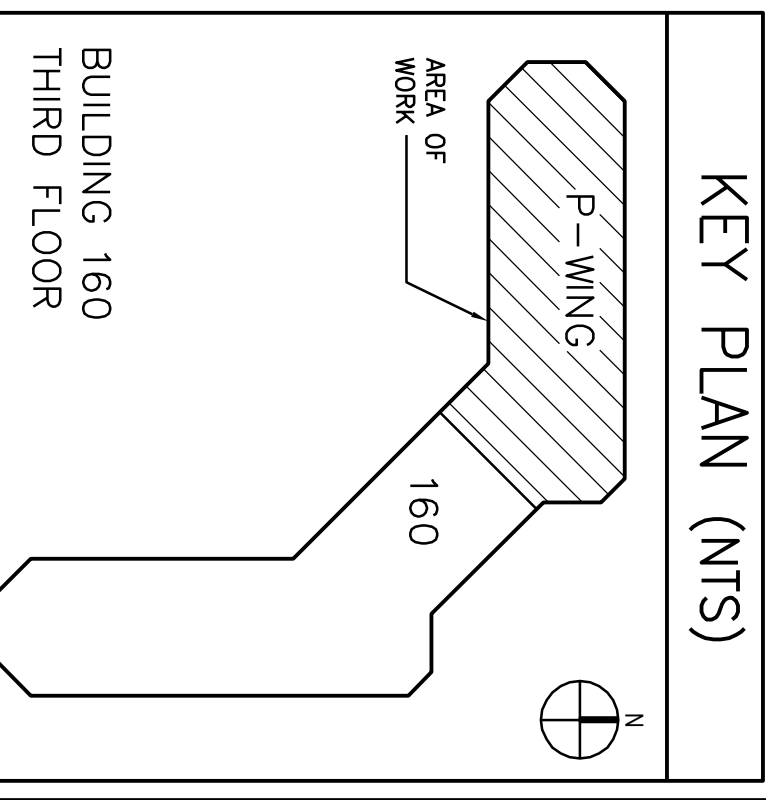

100% FINAL CONSTRUCTION DOCUMENTS - FULLY SPRINKLERED

CONSULTANTS:		ARCHITECT/ENGINEERS:		Drawing Title		Project Title		Drawing Number	
FreemanWhite 8845 Red Oak Blvd Charlotte, NC 28217-5593 Phone: 704.523.2230 Fax: 704.523.2235		Atriax, LLC 102 3rd Avenue, NE PO Box 1629, Hickory, NC 28603 Phone: 828.315.9962 Fax: 828.315.9964 www.atriagroup.com		PLUMBING THIRD FLOOR PHASING PLAN: WASTE/VENT (PHASE 2)		RENOVATE P-SIDE FOR SUPER POD PHASE 2		Building Number 160	
Date 03-25-2016		Approved Project Director J.H. OULLEN VAMC		Location MTN HOME TN		Drawing Number PL102		Office of Construction and Facilities Management	
Revision		Date		Checked S.L.C.		Dwg 50 of 118		Department of Veterans Affairs	