KEYED NOTES

1. REFER TO SENSOR FAUCET DETAIL ON SHEET PP501.

GENERAL NOTES

A. PLUMBING CONTRACTOR SHALL COMMUNICATE AND COORDINATE WITH OWNER ANY SHUT DOWN OF EXISTING SYSTEMS OR SPACES IN WRITING AND RECEIVE APPROVAL A MINIMUM OF SEVEN (7) DAYS PRIOR TO EVENT.

B. THIS SHEET INDICATES SEQUENCE OF WORK WITH ASSOCIATED PHASE.

C. UNLESS NOTED OTHERWISE, ALL DOMESTIC WATER PIPING IS ABOVE CEILING.

D. INSTALL WATER HAMMER ARRESTORS ON DOMESTIC WATER PIPING AS REQUIRED TO ELIMINATE HYDRAULIC SHOCK THROUGHOUT THE PIPING SYSTEM.

E. BALANCE DOMESTIC HOT WATER RETURN SYSTEM TO PROVIDE ADEQUATE CIRCULATION TO MAINTAIN HOT WATER TEMPERATURE THROUGHOUT THE SYSTEM.

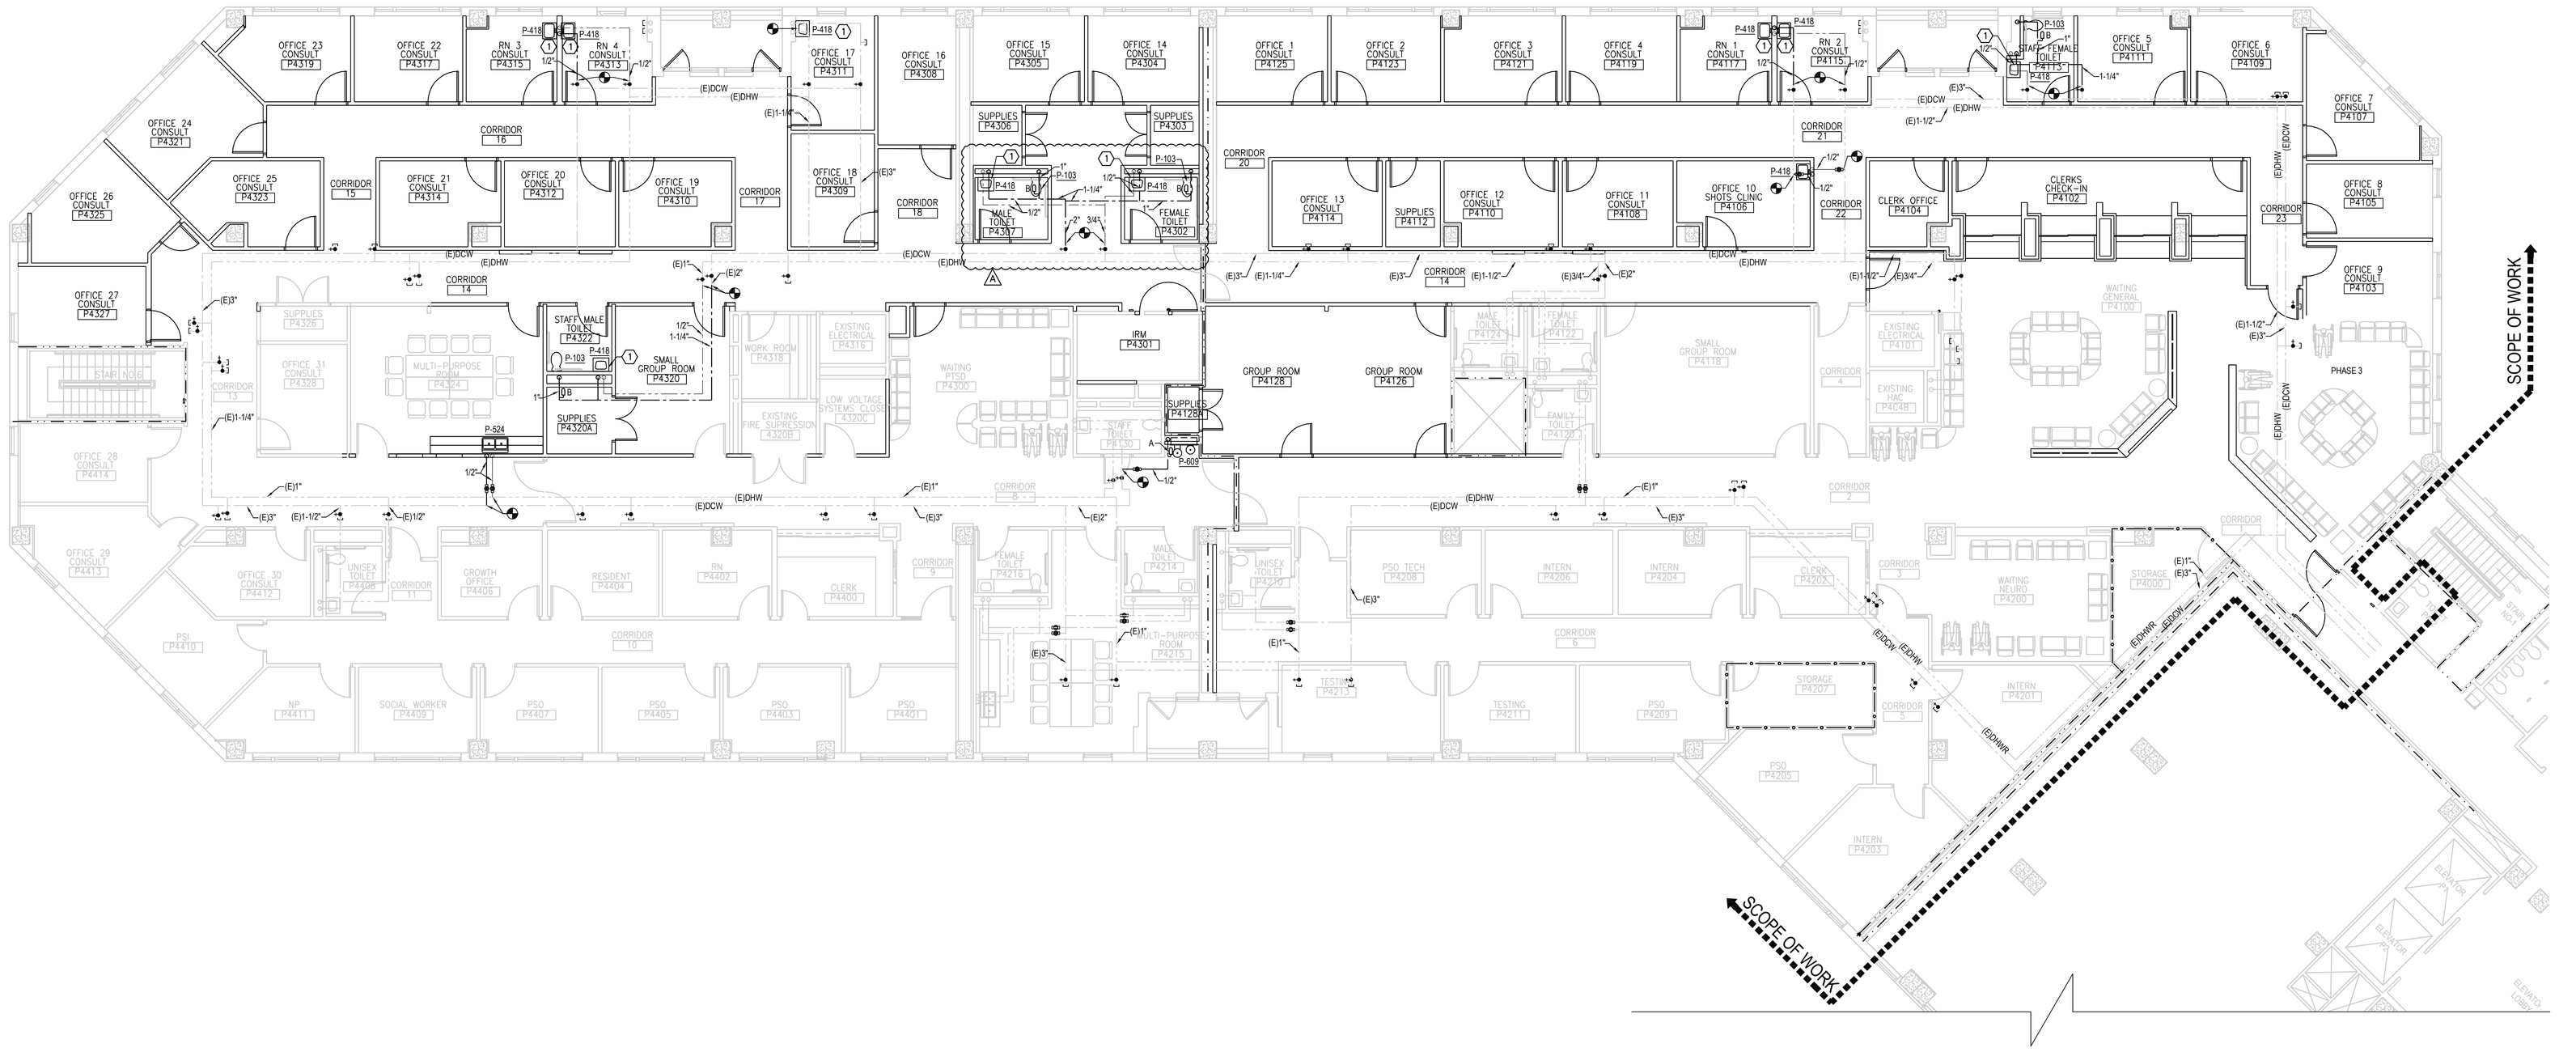

1 PLUMBING THIRD FLOOR PHASING PLAN – WATER (PHASE 2)
SCALE: 1/8" = 1'-0"

0 4' 8' 16'

KEY PLAN (NTS)

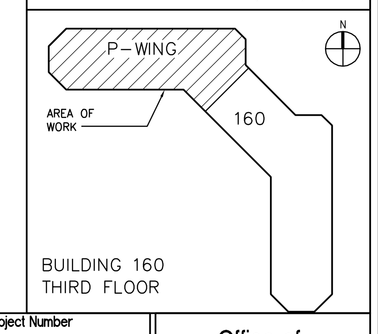

100% FINAL CONSTRUCTION DOCUMENTS - FULLY SPRINKLERED

Revisions	Date
ADDENDUM A	03-25-2016

CONSULTANTS:

FreemanWhite
8845 Red Oak Blvd.
Charlotte, NC 28217-5593
Phone: 704.523.2230
Fax: 704.523.2235

LeGrand Engineering, Inc.
215 Park Ave SE
Aiken, SC 29801
Phone: 803.502.0657
Fax: 803.643.4648

NORTH CAROLINA PROFESSIONAL ENGINEER SEAL 036968 3/25/16 ANDREA G. THOMPSON

ARCHITECT/ENGINEERS:

Atriax GROUP
www.atriaxgroup.com

Atriax, pllc
102 3rd Avenue, NE
PO Box 1629, Hickory, NC 28603
Phone: 828.315.9962
Fax: 828.315.9964

NC Engineering License No.: P-0214
NC Architectural License No.: 51254

Drawing Title: PLUMBING THIRD FLOOR PHASING PLAN: WATER (PHASE 2)

Approved: Project Director

Project Title: RENOVATE P-SIDE FOR SUPER POD PHASE 2 –

Location: J.H. QUILLEN VAMC MTN. HOME TN

Date: DECEMBER 21, 2015 | Checked: AGT | Drawn: SLC

Project Number: 621-15-120

Building Number: 160

Drawing Number: PP102

Dwg. 52 of 118

Office of Construction and Facilities Management

Department of Veterans Affairs

VA FORM 08-6231