



three inches = one foot  
 one and one half inches = one foot  
 one inch = one foot  
 three quarters inch = one foot  
 one half inch = one foot  
 three eighths inch = one foot  
 one quarter inch = one foot  
 one eighth inch = one foot

- | KEYED NOTES  | GENERAL NOTES  |
|--|--|
| <ol style="list-style-type: none"> <li>1 COORDINATE MOUNTING HEIGHT OF DEVICE WITH OWNER.</li> <li>2 PROVIDE CONNECTION BELOW SINK FOR ELECTRONIC SENSOR OPERATED FAUCET AND CONNECTION TO WATER CLOSET FLUSH SENSOR.</li> <li>3 PROVIDE CONNECTION FOR SECURITY SYSTEM AND DOOR CONTROLS PANEL.</li> <li>4 PROVIDE CONTROL VOLTAGE CIRCUIT FOR HVAC CONTROLS ABOVE ACCESSIBLE CEILING.</li> </ol> | <ol style="list-style-type: none"> <li>A. COORDINATE DEVICE LOCATIONS WITH CASEWORK INSTALLER AND FINAL EQUIPMENT LOCATIONS. ENSURE DEVICE LOCATIONS ARE NOT OBSTRUCTED BY FURNITURE OR IMPEDE EQUIPMENT OPERATION.</li> <li>B. PROVIDE SHALLOW OUTLET BOX FOR ANY DEVICE LOCATED IN FURRING AT EXISTING SHEER WALL. COORDINATE DEPTH WITH GENERAL CONTRACTOR.</li> <li>C. FIELD VERIFY FINAL EQUIPMENT CONNECTION REQUIREMENTS WITH NAMEPLATE DATA OF EQUIPMENT ACTUALLY SUPPLIED TO SITE.</li> <li>D. REUSE EXISTING CIRCUIT BREAKERS CURRENTLY SERVING AREA OF RENOVATION. REPLACE ALL CONDUCTORS AND RACEWAY WITHIN AREA OF RENOVATION.</li> <li>E. PROVIDE CONDUIT HANGERS TO SUPPORT AT LEAST 25% ADDITIONAL RACEWAYS ABOVE ACCESSIBLE CEILING TO ALLOW FOR FUTURE BRANCH CIRCUITS.</li> <li>F. PROVIDE HOSPITAL GRADE RECEPTACLES FOR ALL NEW RECEPTACLES IN THIS VA FACILITY. MATCH EXISTING CAMPUS-STANDARD RECEPTACLE TO INCLUDE RIGHT ANGLE PIVOTABLE TERMINAL TO TERMINATE DEVICE - HUBBELL SNAP 8000 INA OR EQUIVALENT.</li> <li>G. PROVIDE 120V, 20-AMP BRANCH CIRCUITS FROM EQUIPMENT BRANCH PANEL EL3D TO SERVE NEW FIRE/SMOKE DAMPERS. CONNECT TO FIRE/SMOKE DAMPERS USING 2#12 AND 1#12 GROUND IN 3/4" CONDUIT.</li> </ol> |

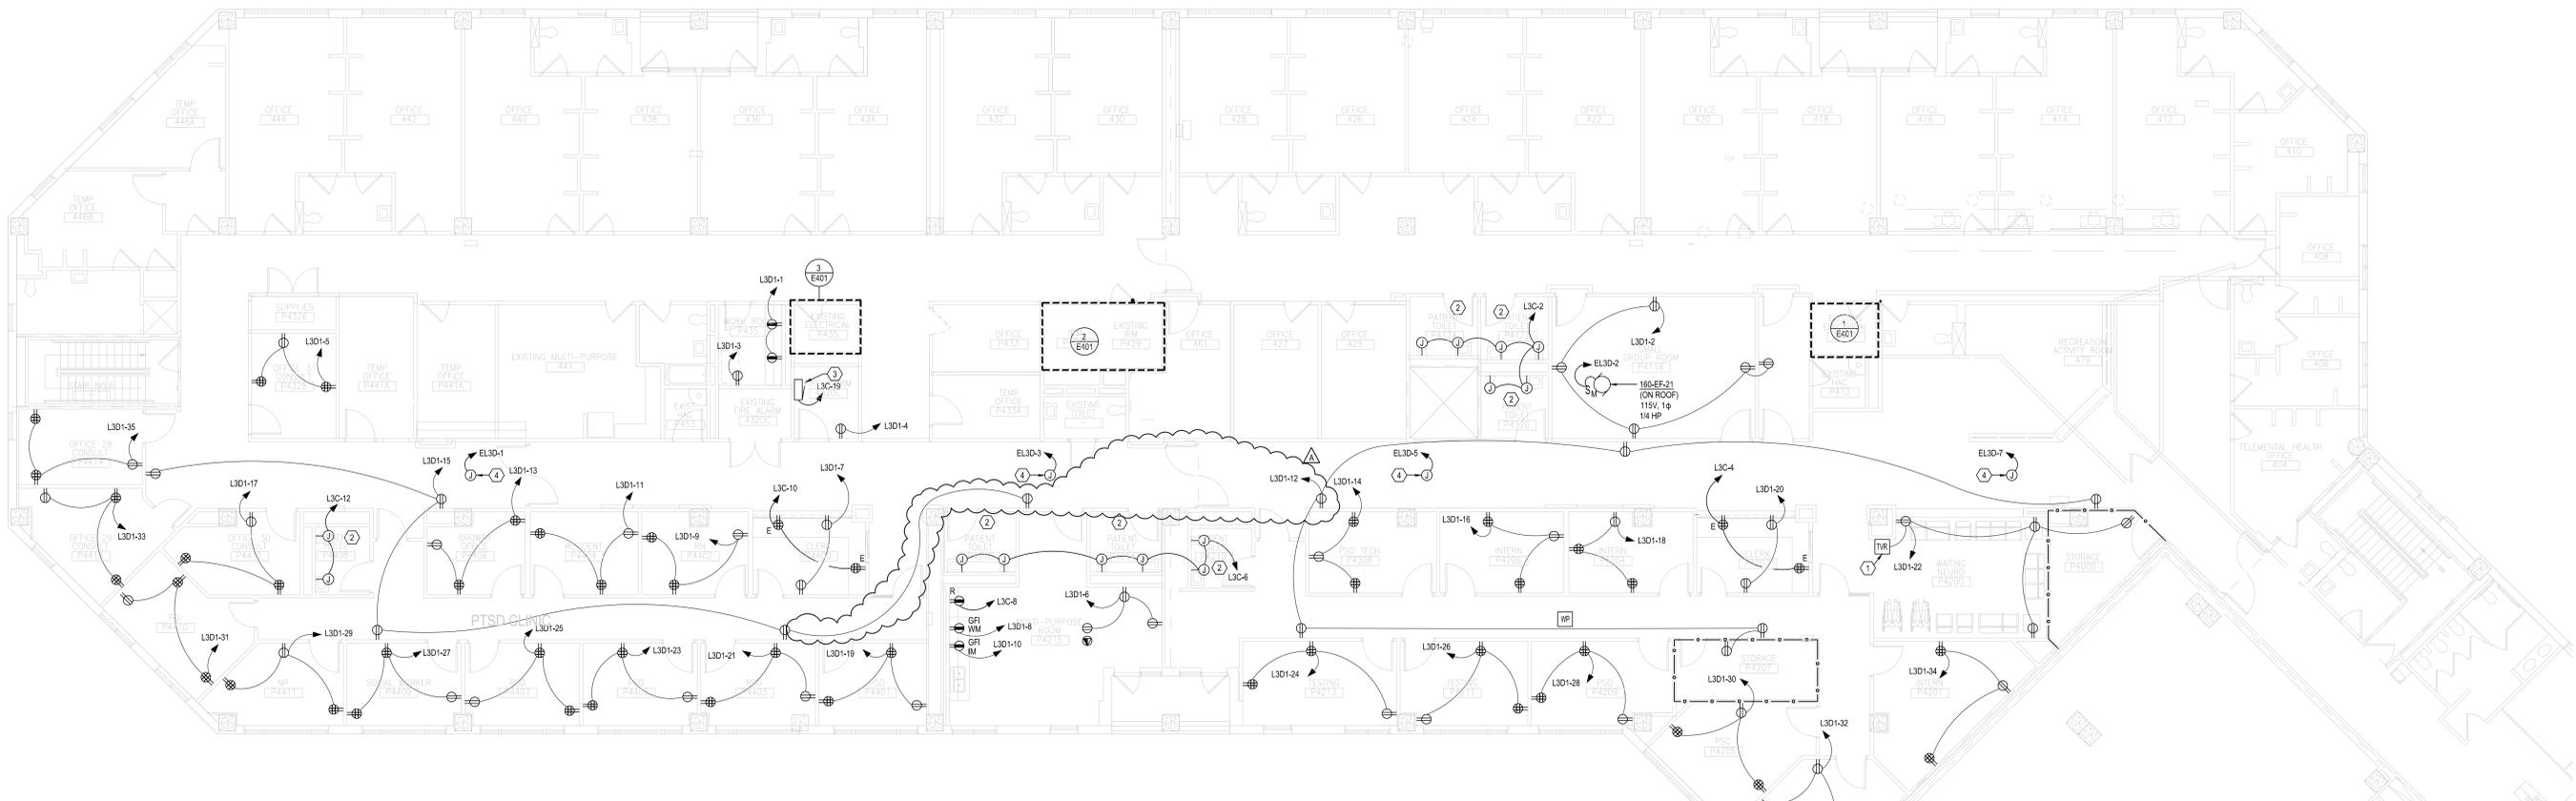

**1 ELECTRICAL THIRD FLOOR PHASE 1 POWER PLAN**  
 SCALE: 1/8" = 1'-0"  
 0 4' 6'

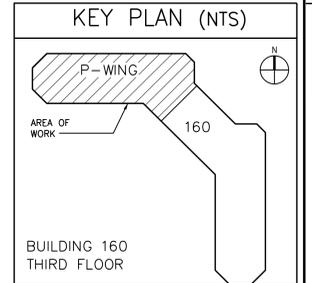

100% FINAL CONSTRUCTION DOCUMENTS - FULLY SPRINKLERED

ADDENDUM A Revisions Date	CONSULTANTS:  FreemanWhite 8845 Red Oak Blvd. Charlotte, NC 28217-5593 Phone: 704.523.2230 Fax: 704.523.2235	 LeGrand Engineering, Inc. 215 Park Ave SE Aiken, SC 29801 Phone: 803.502.0657 Fax: 803.643.4648	ARCHITECT/ENGINEERS:  Atriax, pllc 102 3rd Avenue, NE PO Box 1629, Hickory, NC 28603 Phone: 828.315.9962 Fax: 828.315.9964 www.atriaxgroup.com NC Engineering License No.: P-0214 NC Architectural License No.: 51254	Drawing Title <b>ELECTRICAL THIRD FLOOR PHASE 1 POWER PLAN</b>	Project Title <b>RENOVATE P-SIDE FOR SUPER POD PHASE 2</b>	Project Number 621-15-120	Office of Construction and Facilities Management Department of Veterans Affairs
	Approved Project Director	Location J.H. QUILLLEN VAMC MTN. HOME TN	Building Number 160	Drawing Number <b>EP101</b> Dwg 101 of 118	Date DECEMBER 21, 2015	Checked RJM	Drawn SUB