


GENERAL NOTES

- A. PROVIDE OUTLET BOXES, CONDUIT, RACEWAYS, AND PATHWAYS FOR ALL SYSTEMS DEVICES AND CABLING. PROVIDE INSULATED BUSHING ON ANY CONDUIT END THAT DOES NOT TERMINATE IN AN OUTLET BOX.
- B. PROVIDE J-HOOKS ABOVE ACCESSIBLE CEILING AS A PATHWAY FOR TELECOMMUNICATION CABLING FROM CONDUITS TO CABLE TRAY. SUPPORT CABLING SO THAT NO MORE THAN 2 FEET OF CABLING IS INSTALLED WITHOUT PATHWAY SUPPORT FROM J-HOOKS, CONDUIT, CABLE TRAY, OR SLEEVES. PROVIDE CONDUIT AS CABLING PATHWAY ABOVE INACCESSIBLE CEILINGS.
- C. PROVIDE 1" CONDUIT FROM EACH TELECOMMUNICATION OUTLET BOX AND STUB OUT TO ABOVE ACCESSIBLE CEILING. EACH TELECOMMUNICATION OUTLET BOX SHALL BE 4" SQUARE AND 2.5" DEEP. PROVIDE REDUCER COVER FOR DEVICES THAT ONLY REQUIRE A SINGLE GANG FACEPLATE.
- D. COORDINATE DEVICE LOCATIONS WITH CASEWORK INSTALLER AND FINAL EQUIPMENT LOCATIONS. ENSURE DEVICE LOCATIONS ARE NOT OBSTRUCTED BY FURNITURE OR IMPEDE EQUIPMENT OPERATION.
- E. PROVIDE SHALLOW OUTLET BOX FOR ANY DEVICE LOCATED IN FURRINGS AT EXISTING SHEER WALL. COORDINATE DEPTH WITH GENERAL CONTRACTOR.
- F. COORDINATE CABLING PORT LOCATIONS ON SWITCH ACCORDING TO CAMPUS STANDARD:
- FIRST THREE ROWS FOR PC, PHONE, AND PRINTER
 - FOURTH ROW FOR SPECIALTY DEVICES
 - LEFT HALF OF FIFTH ROW FOR CONTINGENCY
 - RIGHT HALF OF FIFTH ROW FOR WIRELESS POE
- G. REFER TO DETAILS ON DRAWING EY701 FOR ADDITIONAL TELECOMMUNICATIONS ROOM EQUIPMENT INFORMATION AND LAYOUT.

1 ELECTRICAL THIRD FLOOR PHASE 1 AUXILIARY SYSTEM PLAN
SCALE: 1/8" = 1'-0"

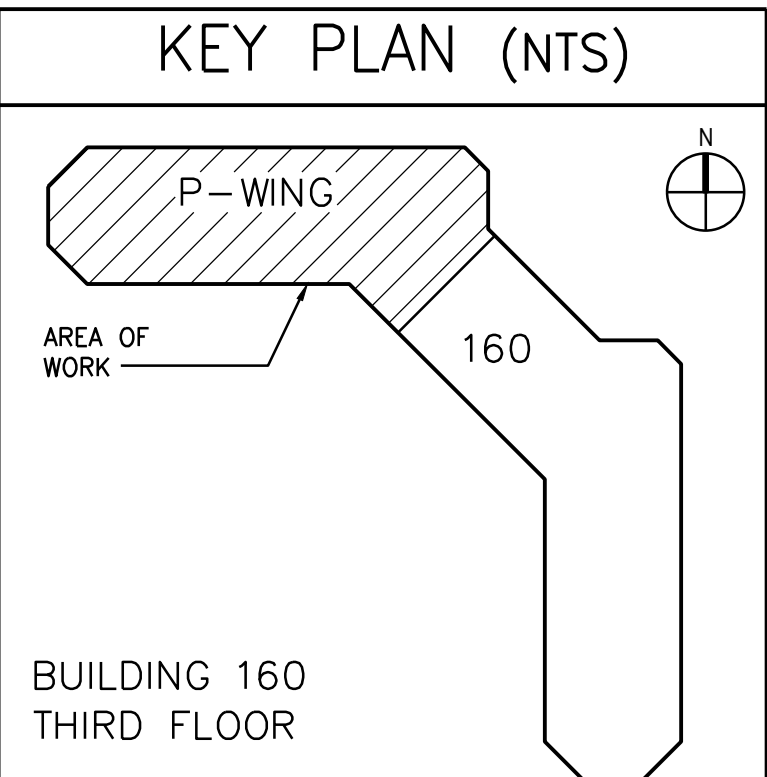

100% FINAL CONSTRUCTION DOCUMENTS - FULLY SPRINKLERED

		CONSULTANTS:				ARCHITECT/ENGINEERS:		Drawing Title ELECTRICAL THIRD FLOOR PHASE 1 AUXILIARY SYSTEM PLAN		Project Title RENOVATE P-SIDE FOR SUPER POD PHASE 2		Project Number 621-15-120		Office of Construction and Facilities Management			
		 FreemanWhite 8845 Red Oak Blvd. Charlotte, NC 28217-5593 Phone: 704.523.2230 Fax: 704.523.2235		 LeGrand Engineering, Inc. 215 Park Ave SE Aiken, SC 29801 Phone: 803.502.0657 Fax: 803.643.4648				 Atriax, pllc 102 3rd Avenue, NE PO Box 1629, Hickory, NC 28603 Phone: 828.315.9962 Fax: 828.315.9964 www.atriaxgroup.com NC Engineering License No.: P-0214 NC Architectural License No.: 51254		Approved Project Director		Location J.H. QUILLLEN VAMC MTN. HOME TN				Drawing Number EY101 Dwg. 105 of 118	
ADDENDUM A Revisions		3/25/16 Date								Date DECEMBER 21, 2015		Checked RJM		Drawn SUB		 Department of Veterans Affairs	