

A

B

C

D

E

F

A


B

C

D

E

F

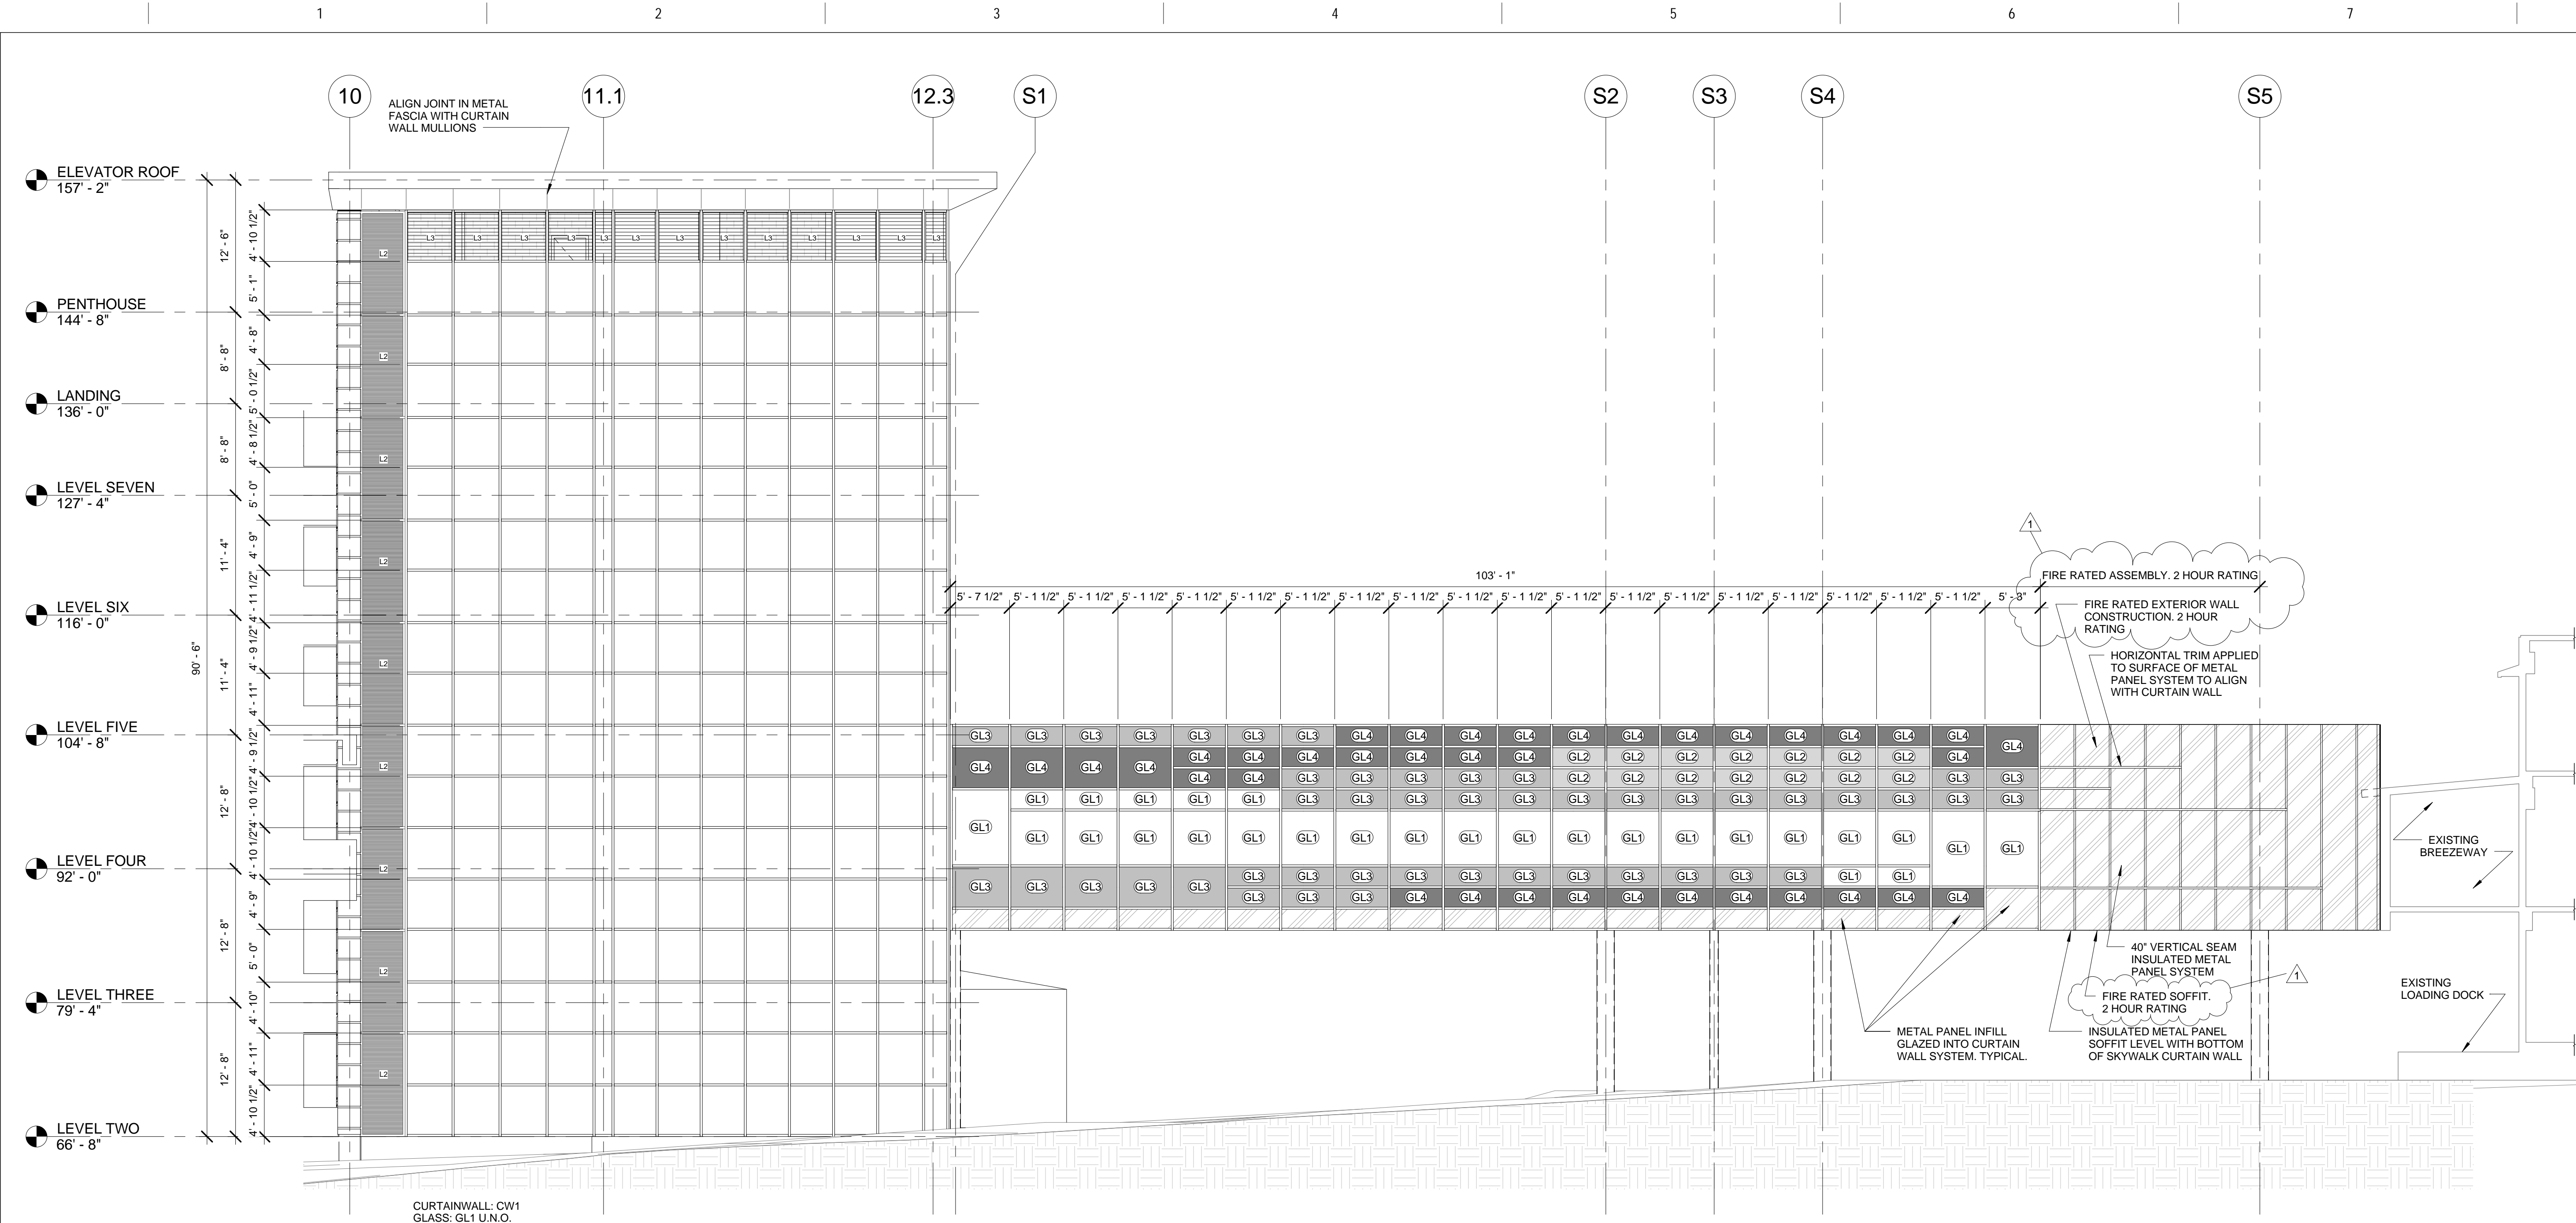

GLAZING TYPES SCHEDULE			
MARK	DESCRIPTION	MATERIAL	REMARKS
GL1	VISION GLASS INSULATED	1 5/16" VRE8-38 INSULATED LAMINATED HS/HS/HS 1/4" EVERGREEN HS W/ VRE-38 #2 1/2" AIR SPACE, ARGON FILLED 1/4" CLEAR HS, .045 CLEAR PVB, .045 CLEAR PVB, 1/3" CLEAR HS W/ V175 HIGH OPACITY WHITE VIRASSPAN	
GL2	SPANDREL GLASS (INSULATED (LIGHT GRAY))	1 5/16" VRE8-38 INSULATED LAMINATED HS/HS/HS 1/4" EVERGREEN HS W/ VRE-38 #2 1/2" AIR SPACE, ARGON FILLED 1/4" CLEAR HS, .045 CLEAR PVB, .045 CLEAR PVB, 1/4" LIGHT GRAY HS SPANDREL	
GL3	SPANDREL GLASS (INSULATED (MEDIUM GRAY))	1 5/16" VRE8-38 INSULATED LAMINATED HS/HS/HS 1/4" EVERGREEN HS W/ VRE-38 #2 1/2" AIR SPACE, ARGON FILLED 1/4" CLEAR HS, .045 CLEAR PVB, .045 CLEAR PVB, 1/4" MEDIUM GRAY HS SPANDREL	
GL4	SPANDREL GLASS (INSULATED (BLACK))	1 5/16" VRE8-38 INSULATED LAMINATED HS/HS/HS 1/4" EVERGREEN HS W/ VRE-38 #2 1/2" AIR SPACE, ARGON FILLED 1/4" CLEAR HS, .045 CLEAR PVB, .045 CLEAR PVB, 1/4" BLACK HS SPANDREL	
GL5	TEMPERED GLASS	1/4" CLEAR TEMPERED	
GL6	WIRE GLASS	1/4" CLEAR WIRE GLASS, POLISHED, DIAMOND	

LOUVERS SCHEDULE	
MARK	DESCRIPTION
L1	NATURAL VENTILATION LOUVER, SIGHT PROOF
L2	NATURAL VENTILATION LOUVER, SIGHT PROOF
L3	NATURAL VENTILATION LOUVER, SIGHT PROOF

1 CURTAIN WALL ELEVATION - STAIR 2 AND SKYWALK - SOUTH ELEVATION
1/8" = 1'-0"
0 4' 8' 16'

100% LEVEL 2 RFP SUBMISSION – NOT FOR CONSTRUCTION

--	--	