GLAZING TYPES SCHEDULE			
MARK	**DESCRIPTION**	**MATERIAL**	**REMARKS**
GL1	VISION GLASS INSULATED	1 5/16" VRE8-38 INSULATED LAMINATED HS/HS/HS ½" EVERGREEN HS W/ VRE-38 #2 ½" AIR SPACE, ARGON FILLED ½" CLEAR HS, .045 CLEAR PVB, .045 CLEAR PVB, 1/3" CLEAR HS W/ V175 HIGH OPACITY WHITE VIRASPAN	
GL2	SPANDREL GLASS INSULATED (LIGHT GRAY)	1 5/16" VRE8-38 INSULATED LAMINATED HS/HS/HS ½" EVERGREEN HS W/ VRE-38 #2 ½" AIR SPACE, ARGON FILLED ½" CLEAR HS, .045 CLEAR PVB, .045 CLEAR PVB, ½" LIGHT GRAY HS SPANDREL	
GL3	SPANDREL GLASS INSULATED (MEDIUM GRAY)	1 5/16" VRE8-38 INSULATED LAMINATED HS/HS/HS ½" EVERGREEN HS W/ VRE-38 #2 ½" AIR SPACE, ARGON FILLED ½" CLEAR HS, .045 CLEAR PVB, .045 CLEAR PVB, ½" MEDIUM GRAY HS SPANDREL	
GL4	SPANDREL GLASS INSULATED (BLACK)	1 5/16" VRE8-38 INSULATED LAMINATED HS/HS/HS ½" EVERGREEN HS W/ VRE-38 #2 ½" AIR SPACE, ARGON FILLED ½" CLEAR HS, .045 CLEAR PVB, .045 CLEAR PVB, ½" BLACK HS SPANDREL	
GL5	TEMPERED GLASS	1/4" CLEAR TEMPERED	
GL6	WIRE GLASS	1/4" CLEAR WIRE GLASS, POLISHED, DIAMOND	

LOUVERS SCHEDULE	
MARK	**DESCRIPTION**
L1	NATURAL VENTILATION LOUVER, SIGHT PROOF
L2	NATURAL VENTILATION LOUVER, SIGHT PROOF
L3	NATURAL VENTILATION LOUVER, SIGHT PROOF

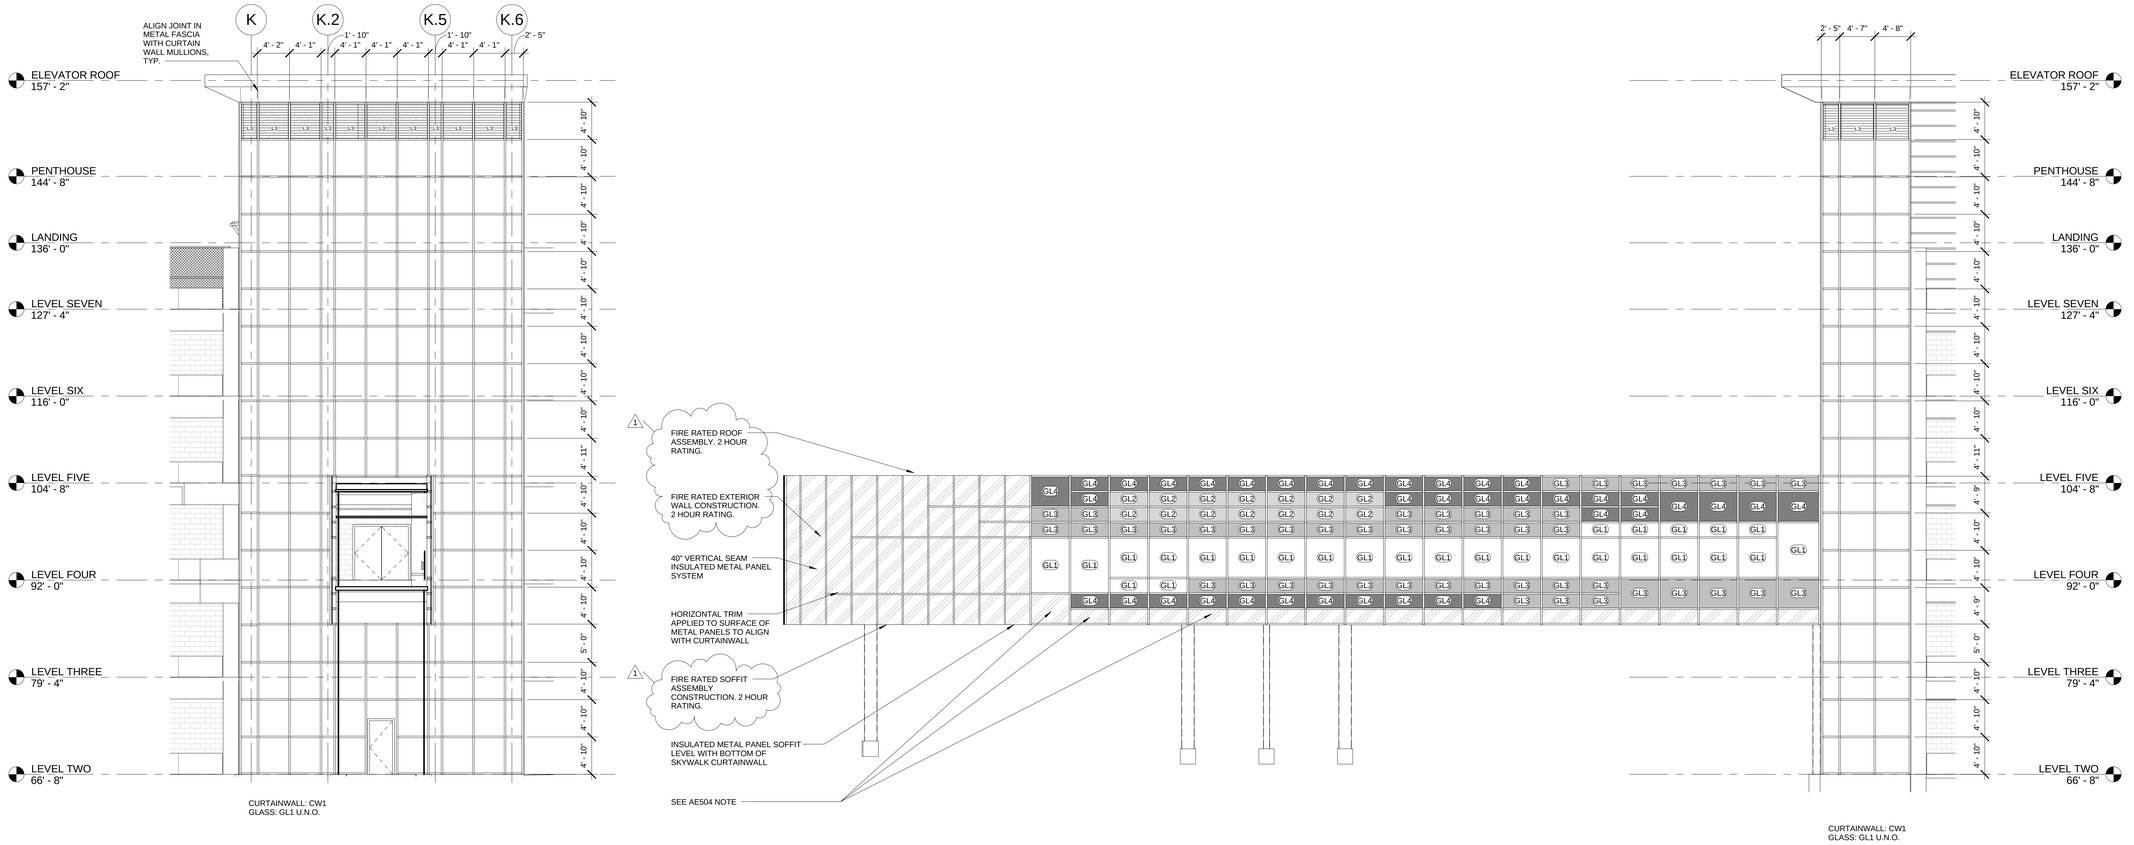

1 AE201 AE505 CURTAIN WALL ELEVATION - STAIR 2 - EAST ELEVATION
1/8" = 1'-0"
0 4' 8' 16'

2 AE201 AE505 CURTAIN WALL ELEVATION - STAIR 2 - NORTH ELEVATION
1/8" = 1'-0"
0 4' 8' 16'

100% LEVEL 2 RFP SUBMISSION – NOT FOR CONSTRUCTION

1 AMENDMENT #3 – 11/3/2011	11-03-2011
Revisions:	Date:

CONSULTANTS:

ARCHITECT/ENGINEERS:

NKB

N.K. BHANDARI, Architecture & Engineering, P.C.
Architecture, Engineering, Construction Management
Syracuse, NY 13204, West Fayette Street
315-428-1177

Drawing Title: CURTAIN WALL DETAILS - STAIR 2

Approved: Project Director

Project Title: NEW PARKING STRUCTURE PHASE 4

Location: SAN JUAN, PUERTO RICO

Date: 06-03-2011 | Checked: CRR | Drawn: JLH

Project Number: 672-085

Building Number: -

Drawing Number: AE505

Dwg. 96 of 169

Office of Construction and Facilites Management

Department of Veterans Affairs