
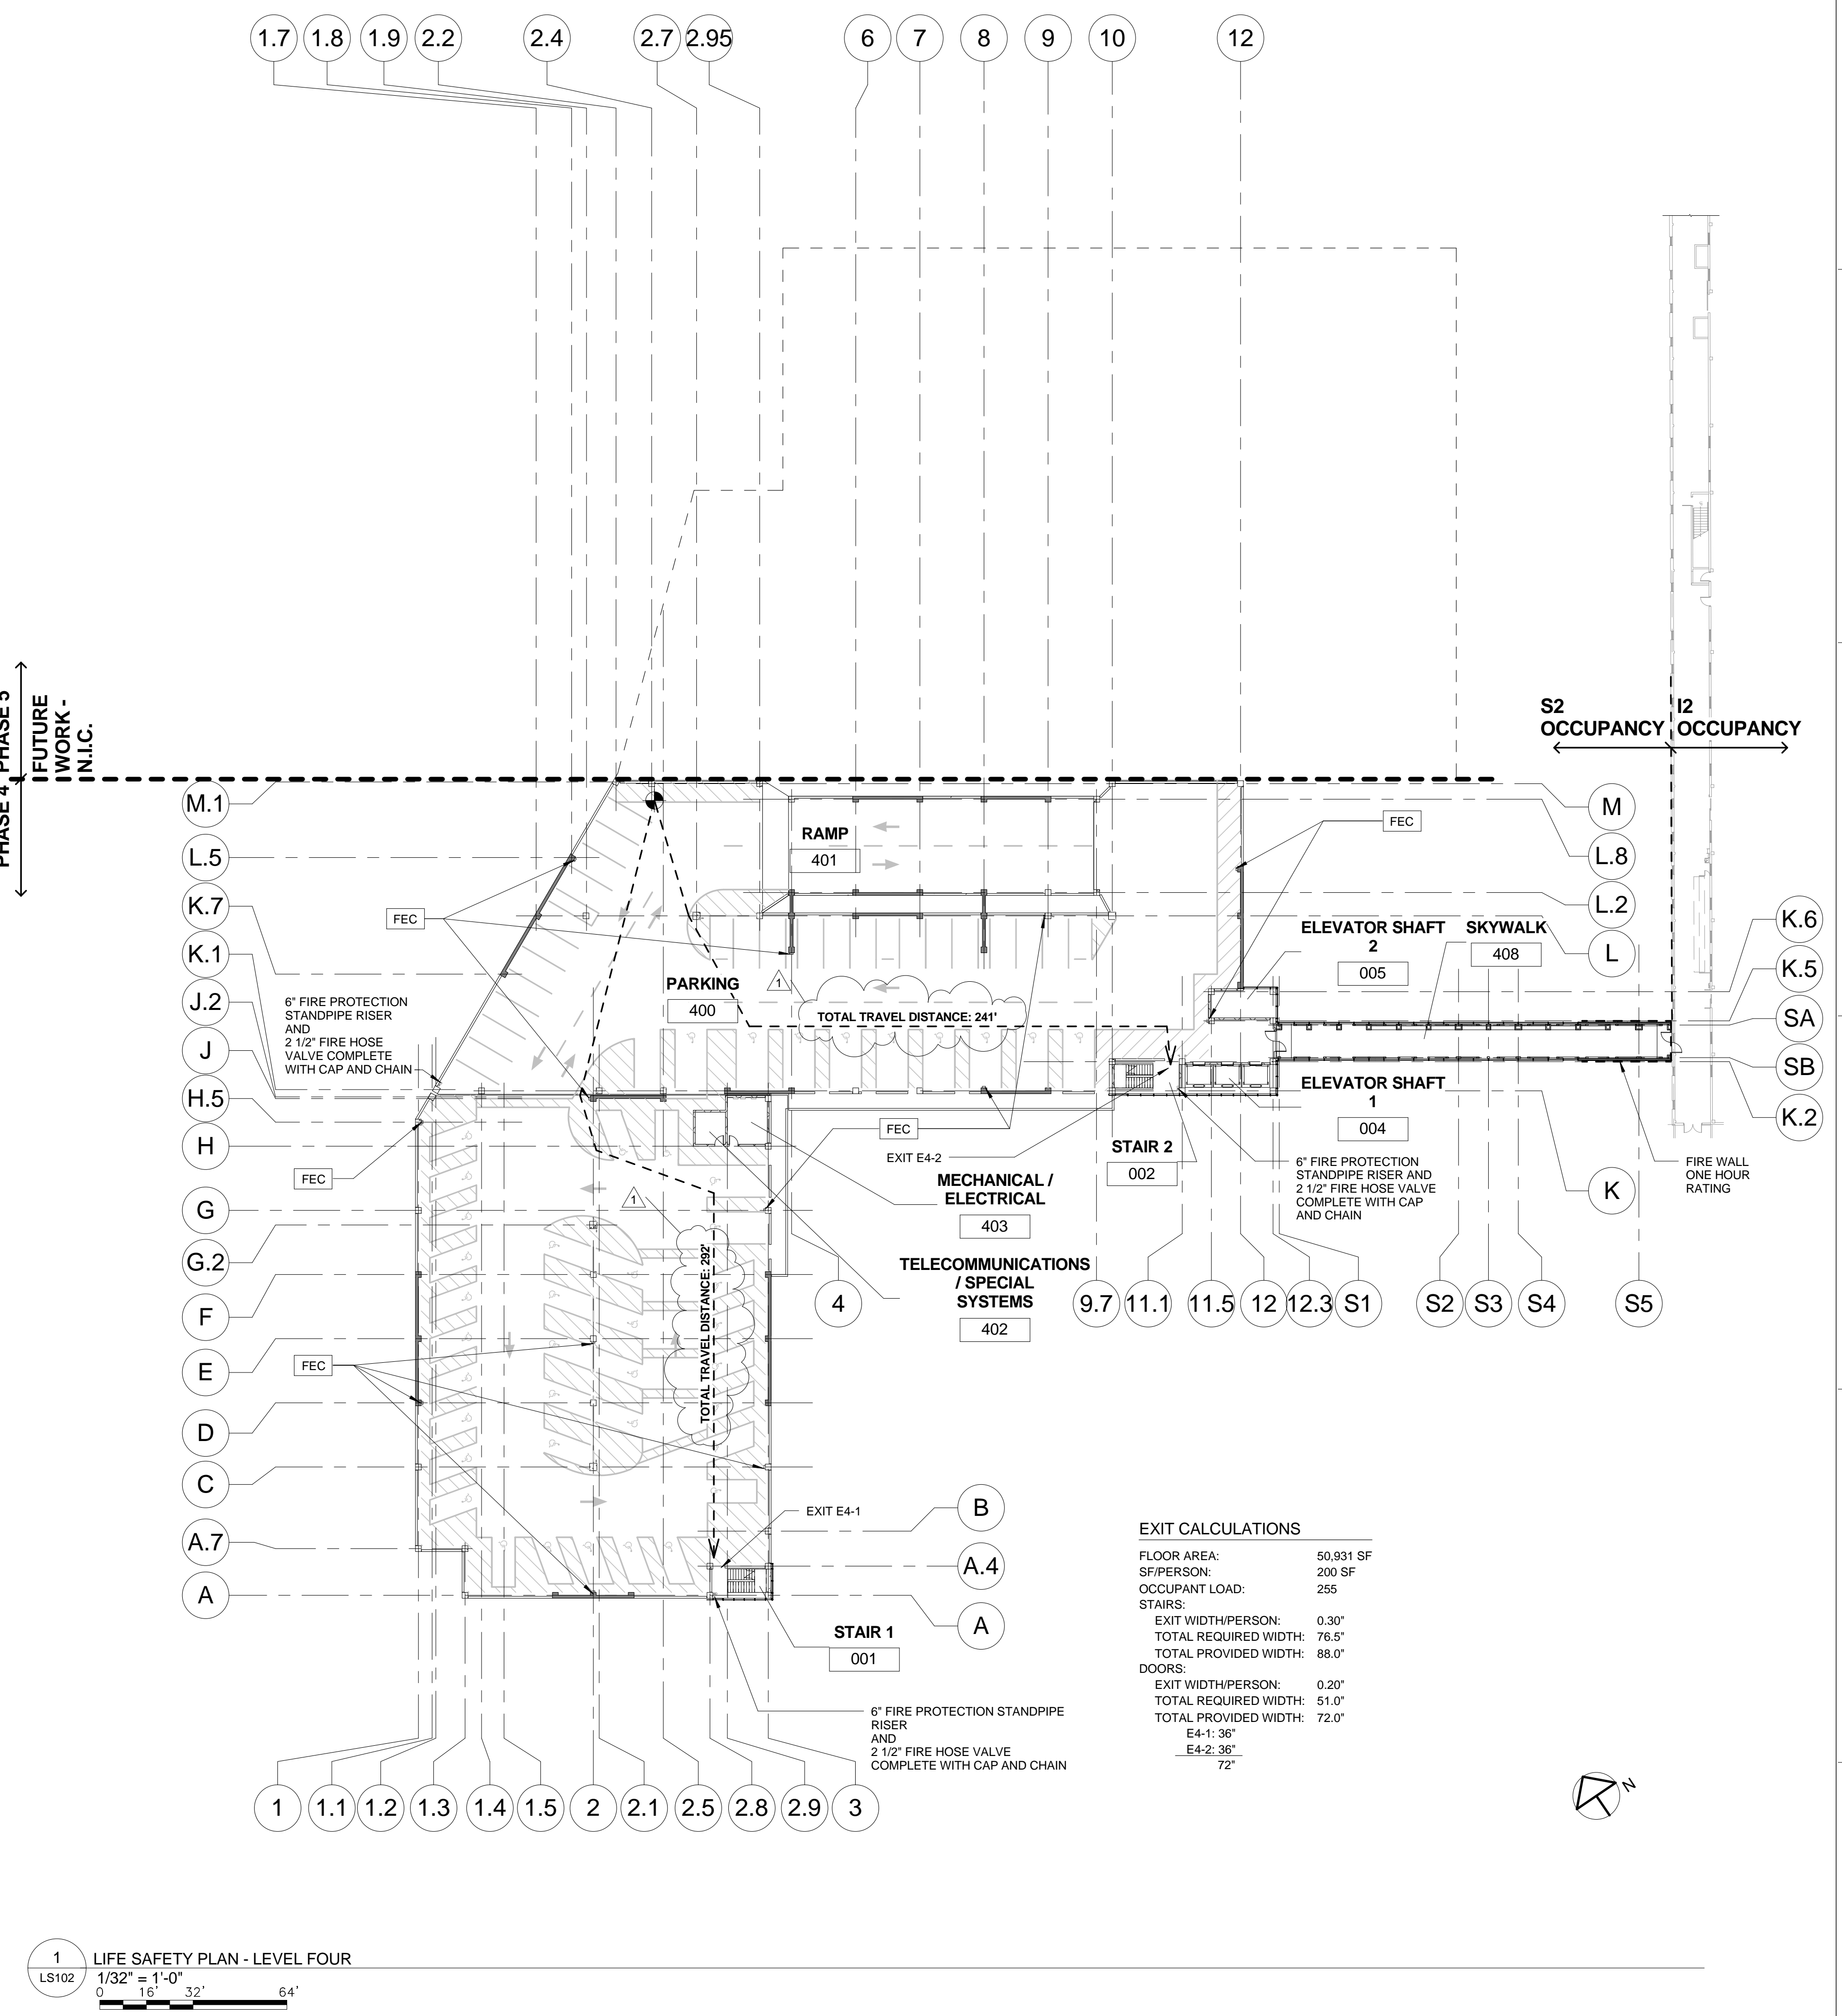


three inches = one foot
one and one half inches = one foot
one inch = one foot
three quarters inch = one foot
one half inch = one foot
three eighths inch = one foot
one quarter inch = one foot
one eighth inch = one foot
one sixteenth inch = one foot

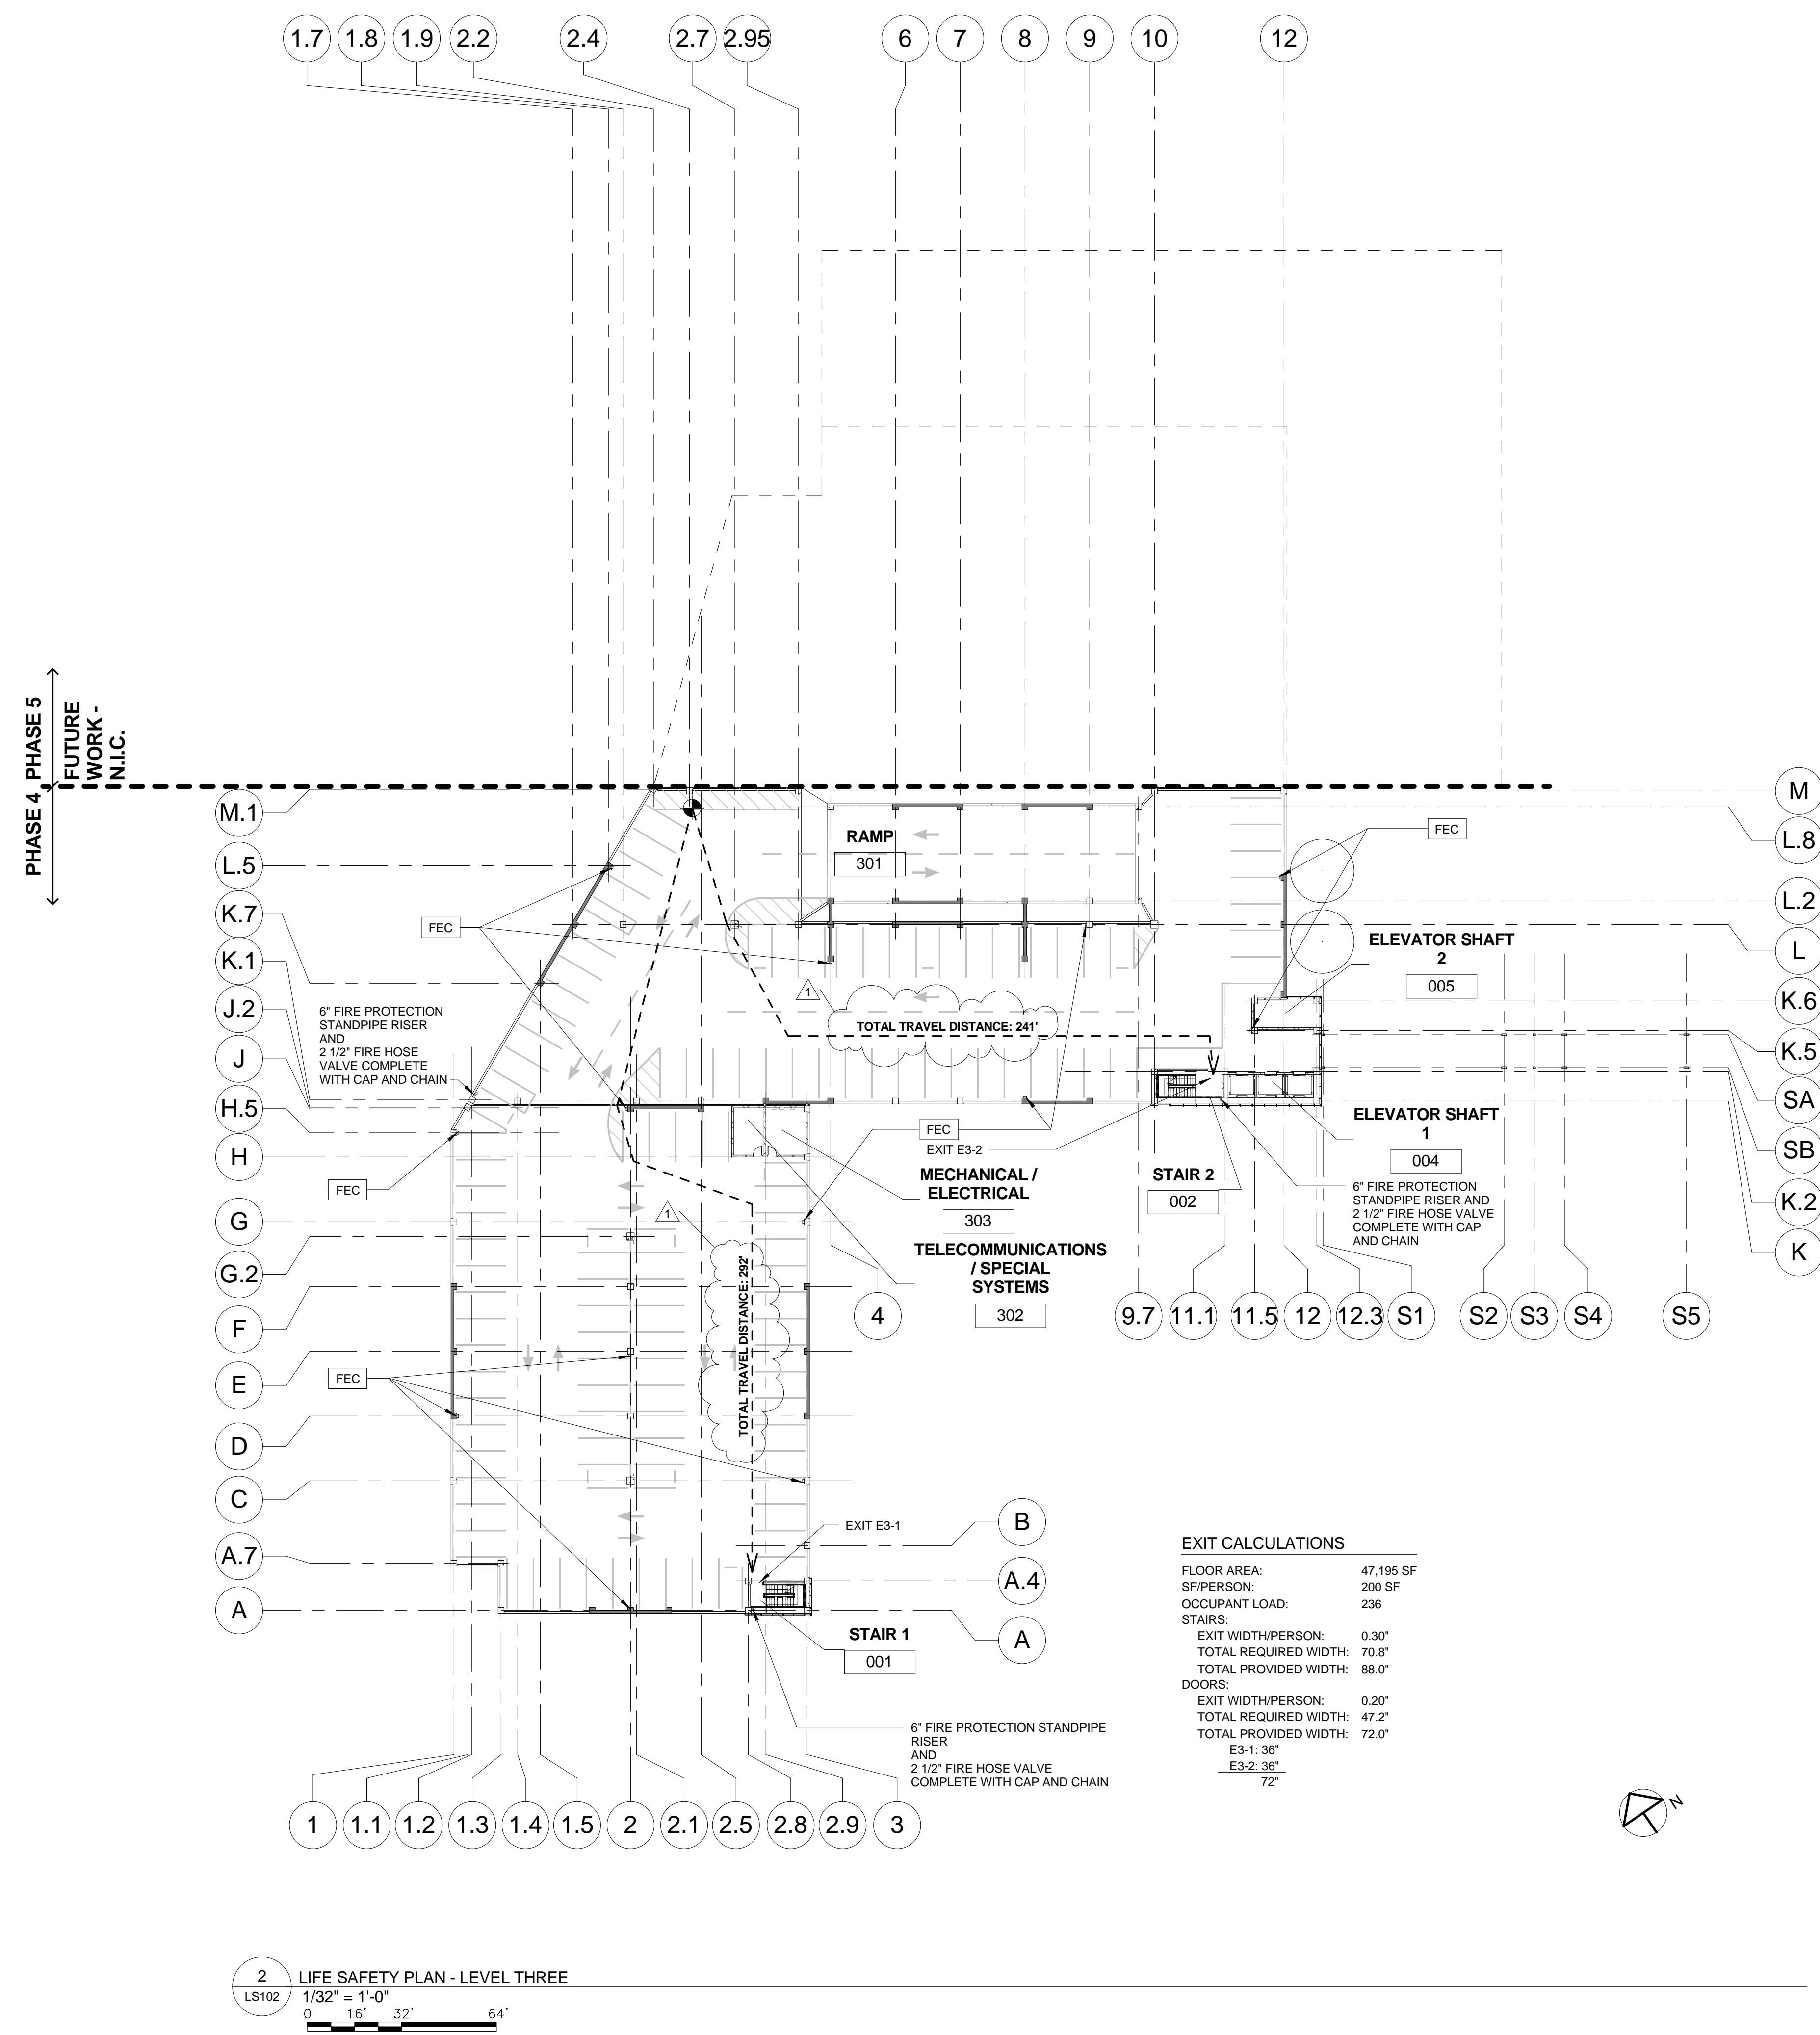

100% LEVEL 2 RFP SUBMISSION – NOT FOR CONSTRUCTION

		CONSULTANTS:				ARCHITECT/ENGINEERS:		<div>Drawing Title</div> <div>LIFE SAFETY PLAN - LEVELS THREE & FOUR</div> <div>Approved: Project Director</div>		<div>Project Title</div> <div>NEW PARKING STRUCTURE PHASE 4</div> <div>Location</div> <div>SAN JUAN, PUERTO RICO</div> <div>Date</div> <div>06-03-2011</div> <div>Checked</div> <div>CRR</div> <div>Drawn</div> <div>JLH</div>			<div>Project Number</div> <div>672-085</div> <div>Building Number</div> <div>-</div> <div>Drawing Number</div> <div>LS102</div> <div>Dwg. 8 of 169</div>		<div>Office of Construction and Facilities Management</div> <div> Department of Veterans Affairs</div>	
<div> AMENDMENT #3 – 11/3/11</div> <div>Revisions:</div>		<div>11-03-2011</div> <div>Date:</div>														