


Existing Stairs to be removed - New OSHA compliant stair installed.

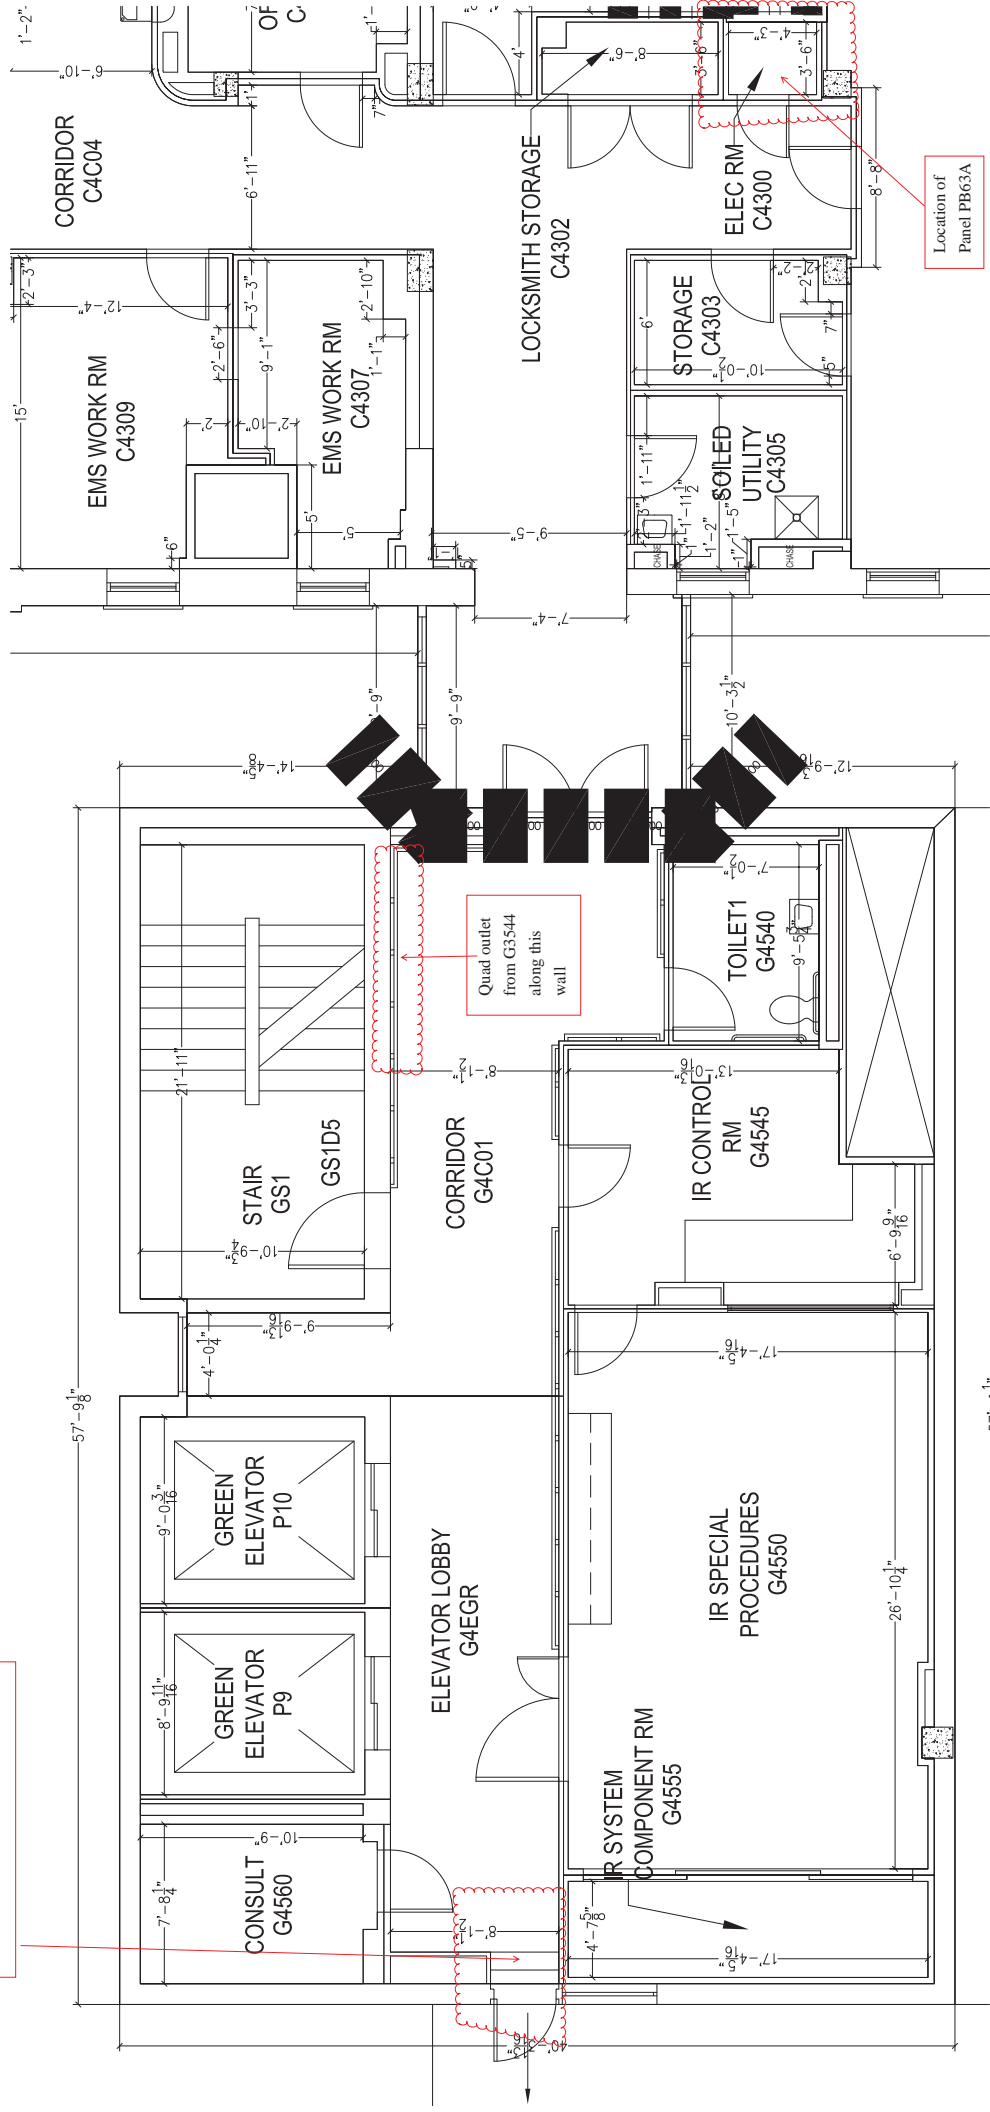

Location of
Panel PB63A

Quad outlet
from G3544
along this
wall

4th Floor Building 1D