




1 MENS SOUTH
SCALE: 1/2" = 1'-0"

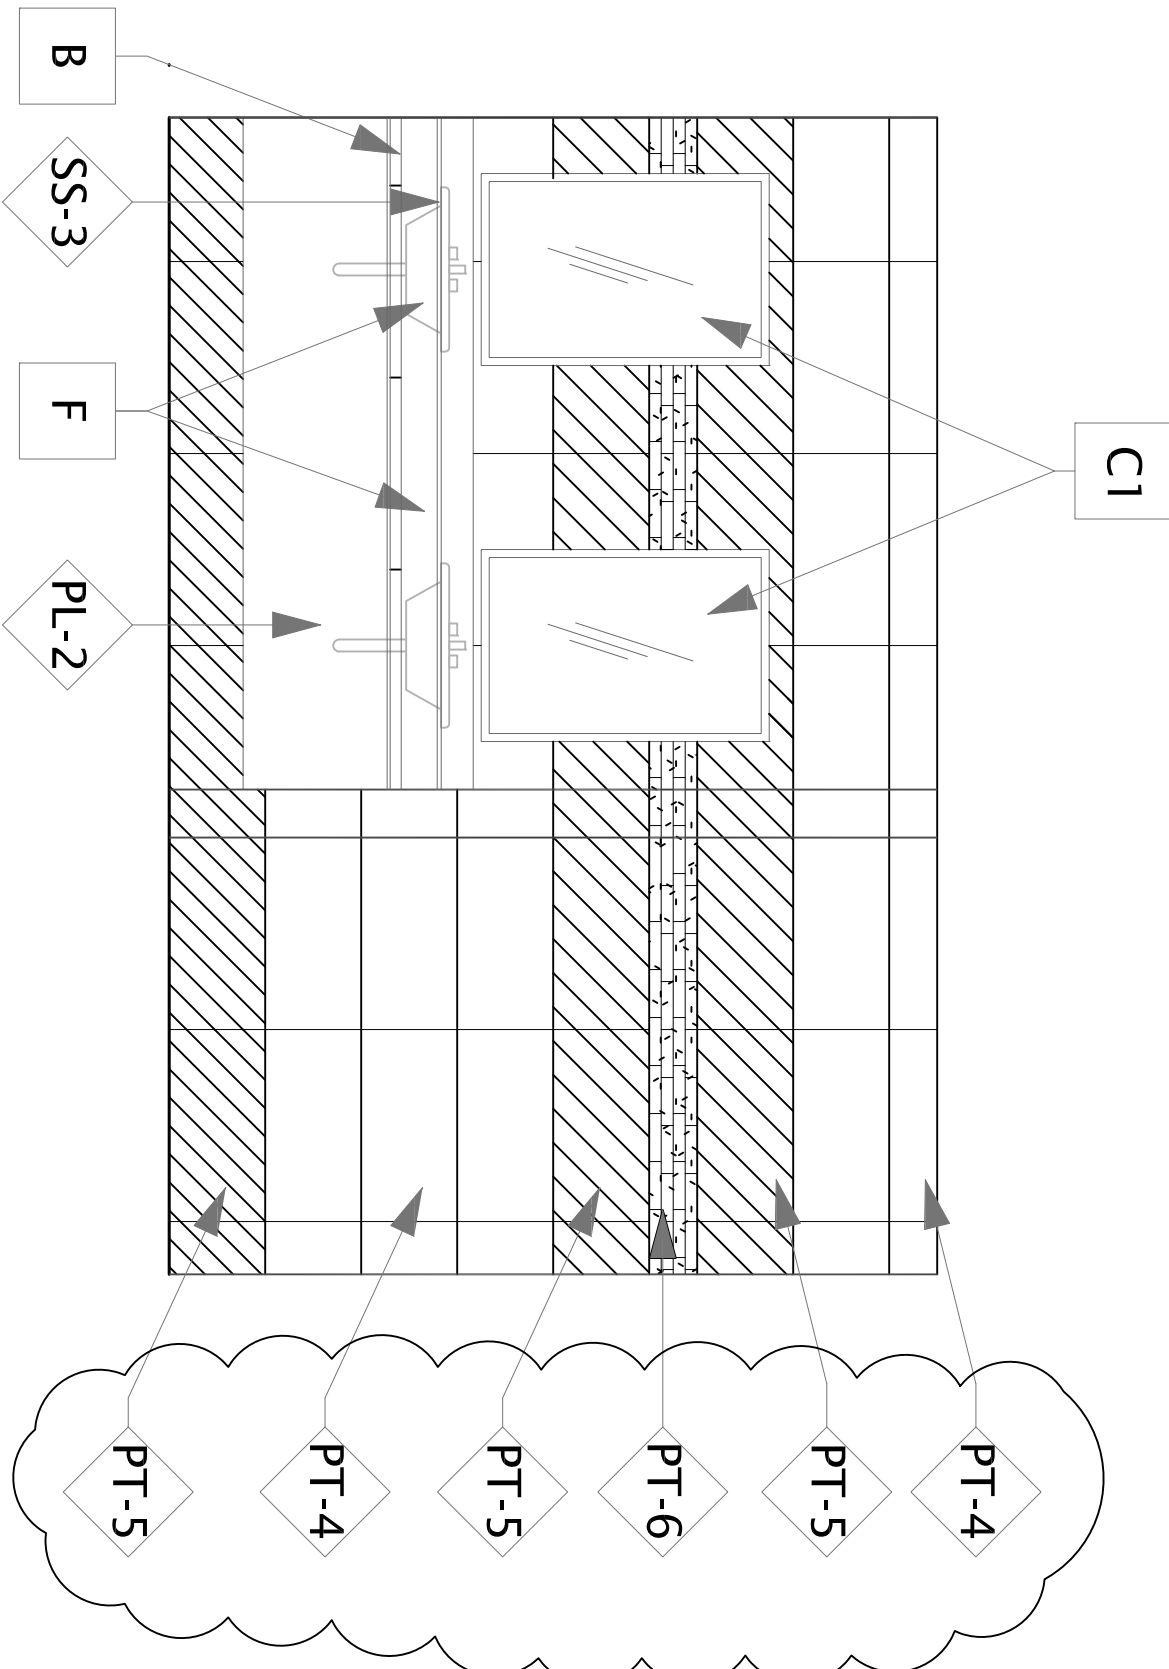

2 MENS EAST
SCALE: 1/2" = 1'-0"

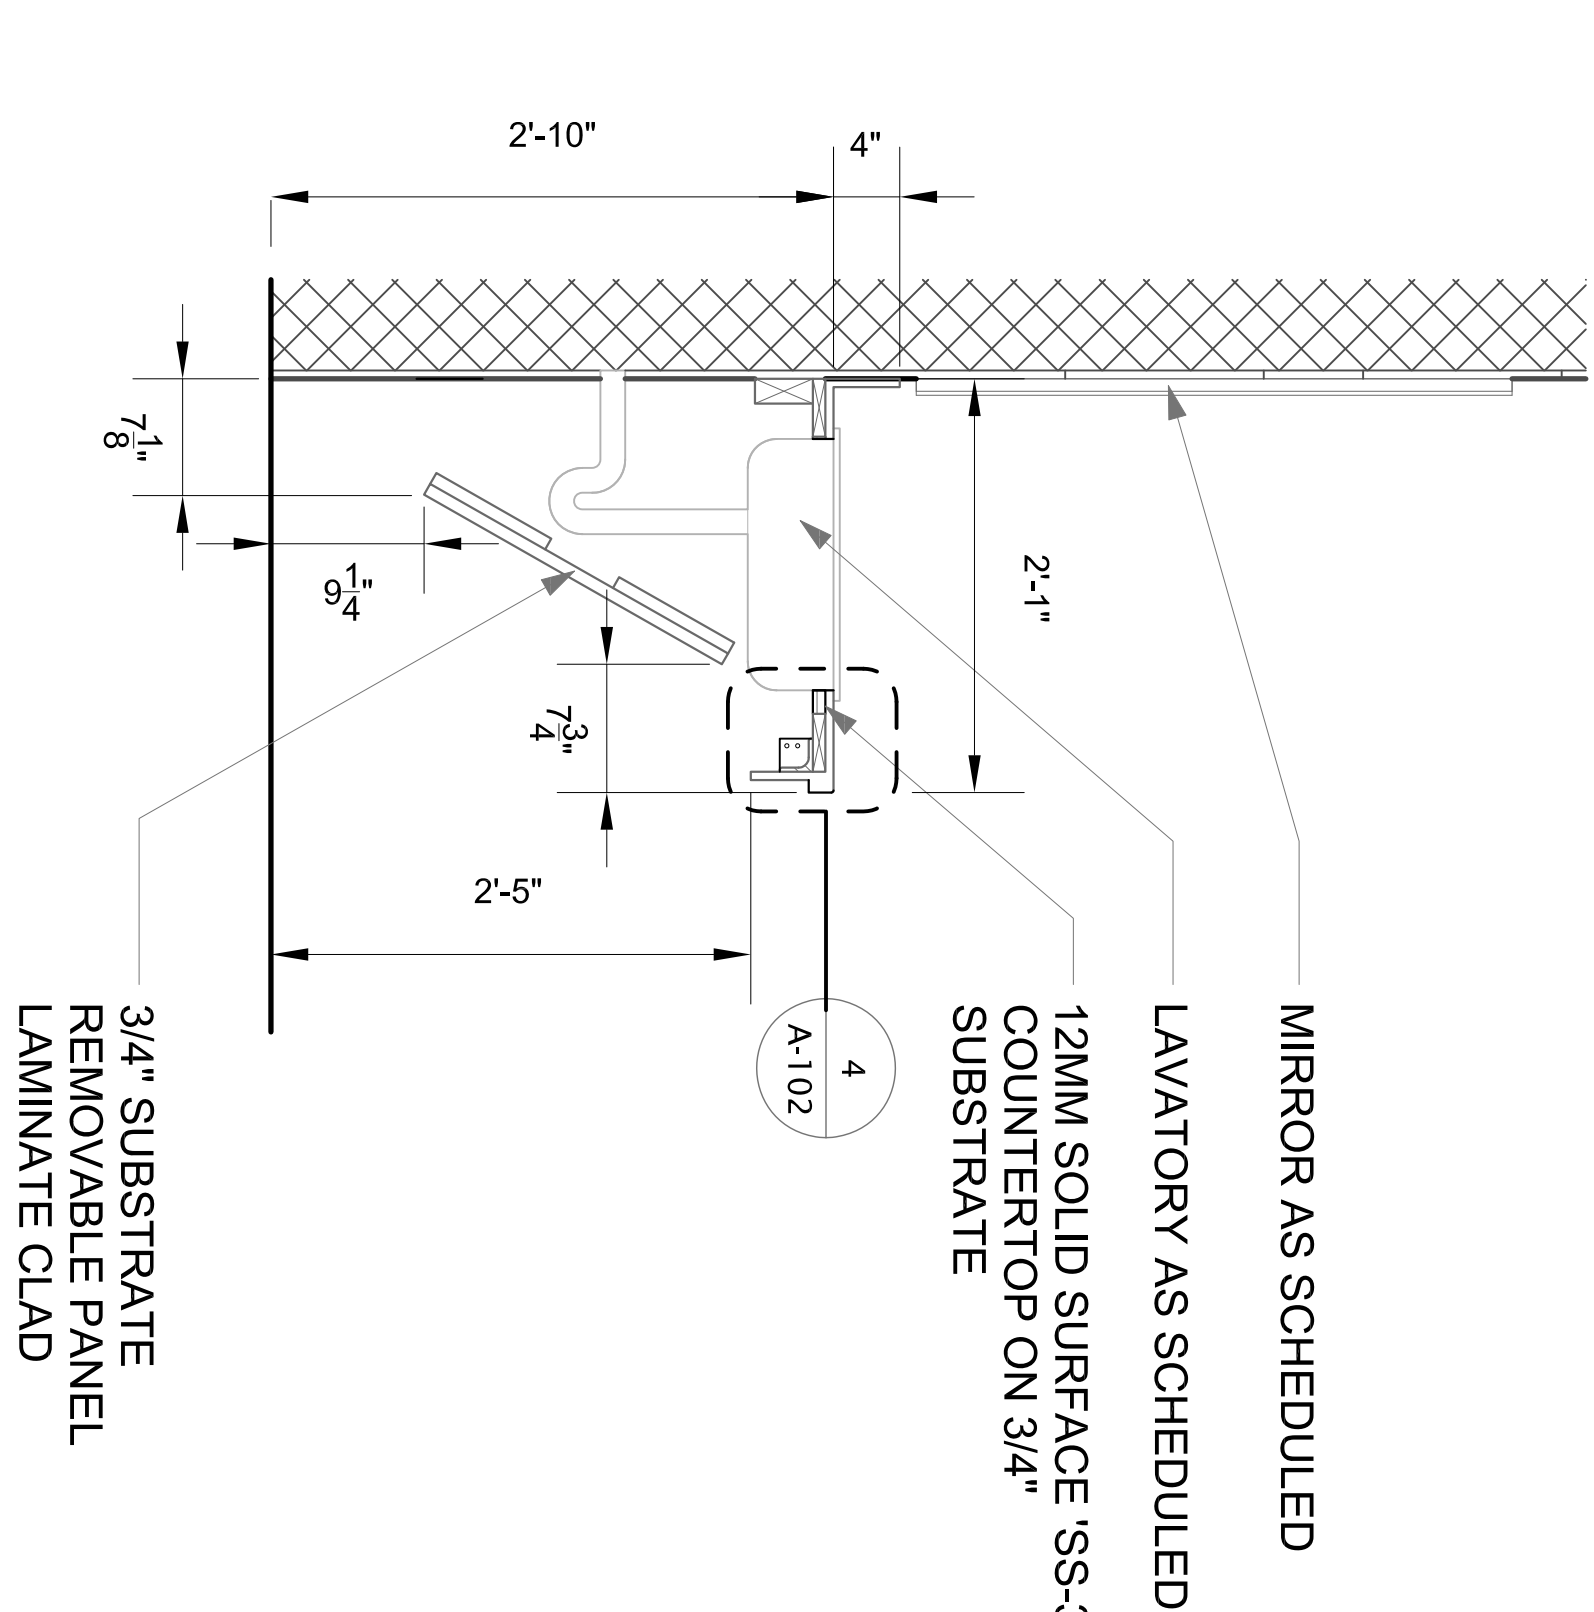


3 VANITY SECTION
SCALE: N.T.S.

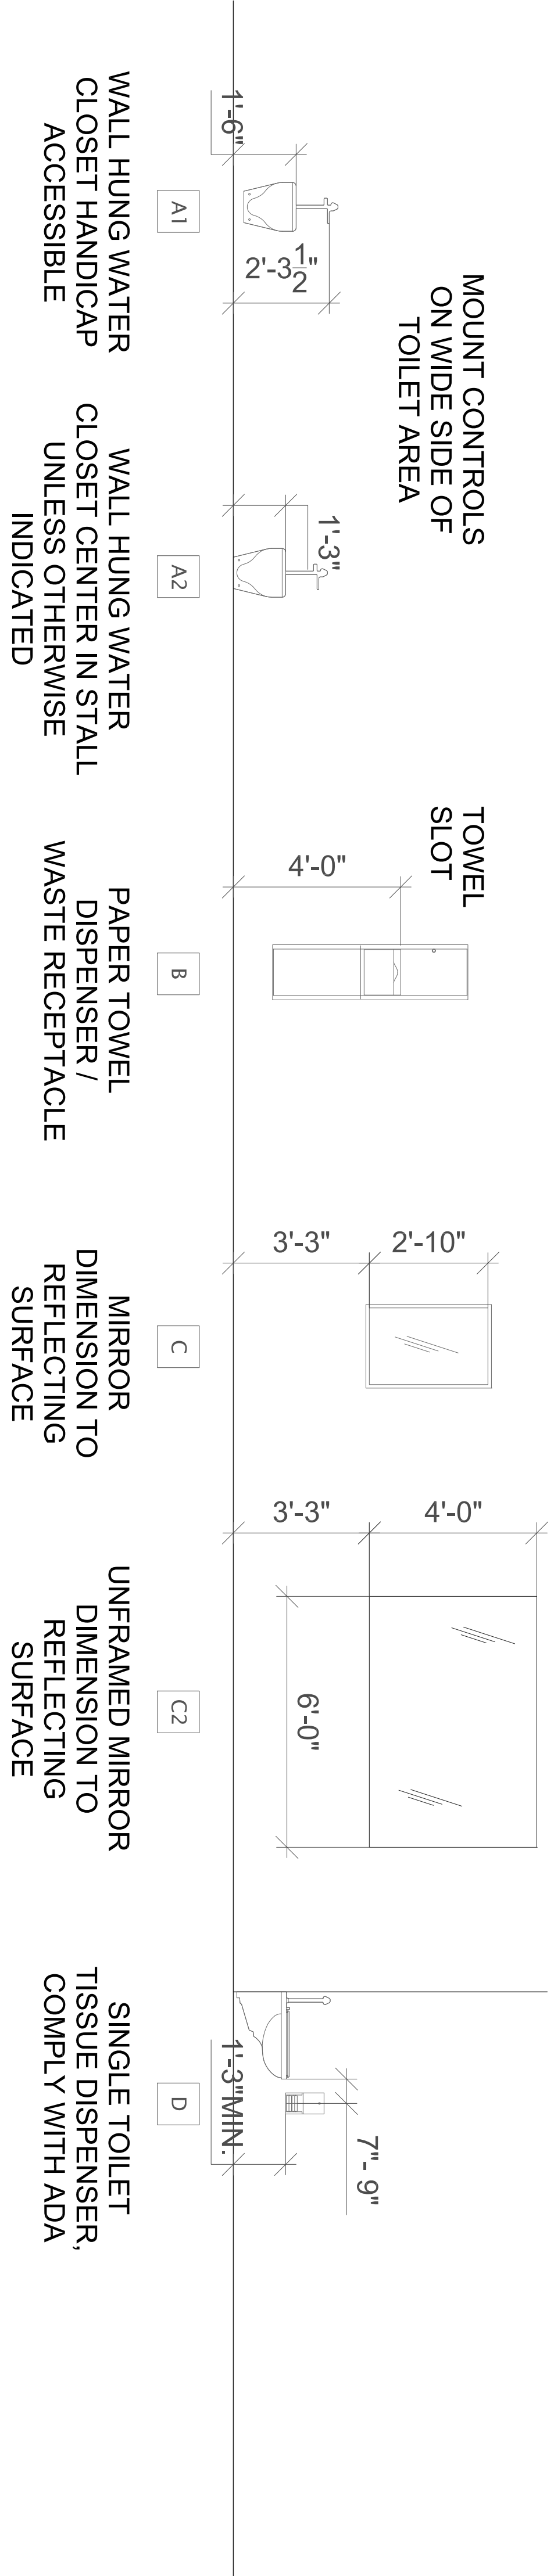


TOILET ACCESSORY AND FIXTURE LEGEND

4 BRACE DETAIL
SCALE: N.T.S.

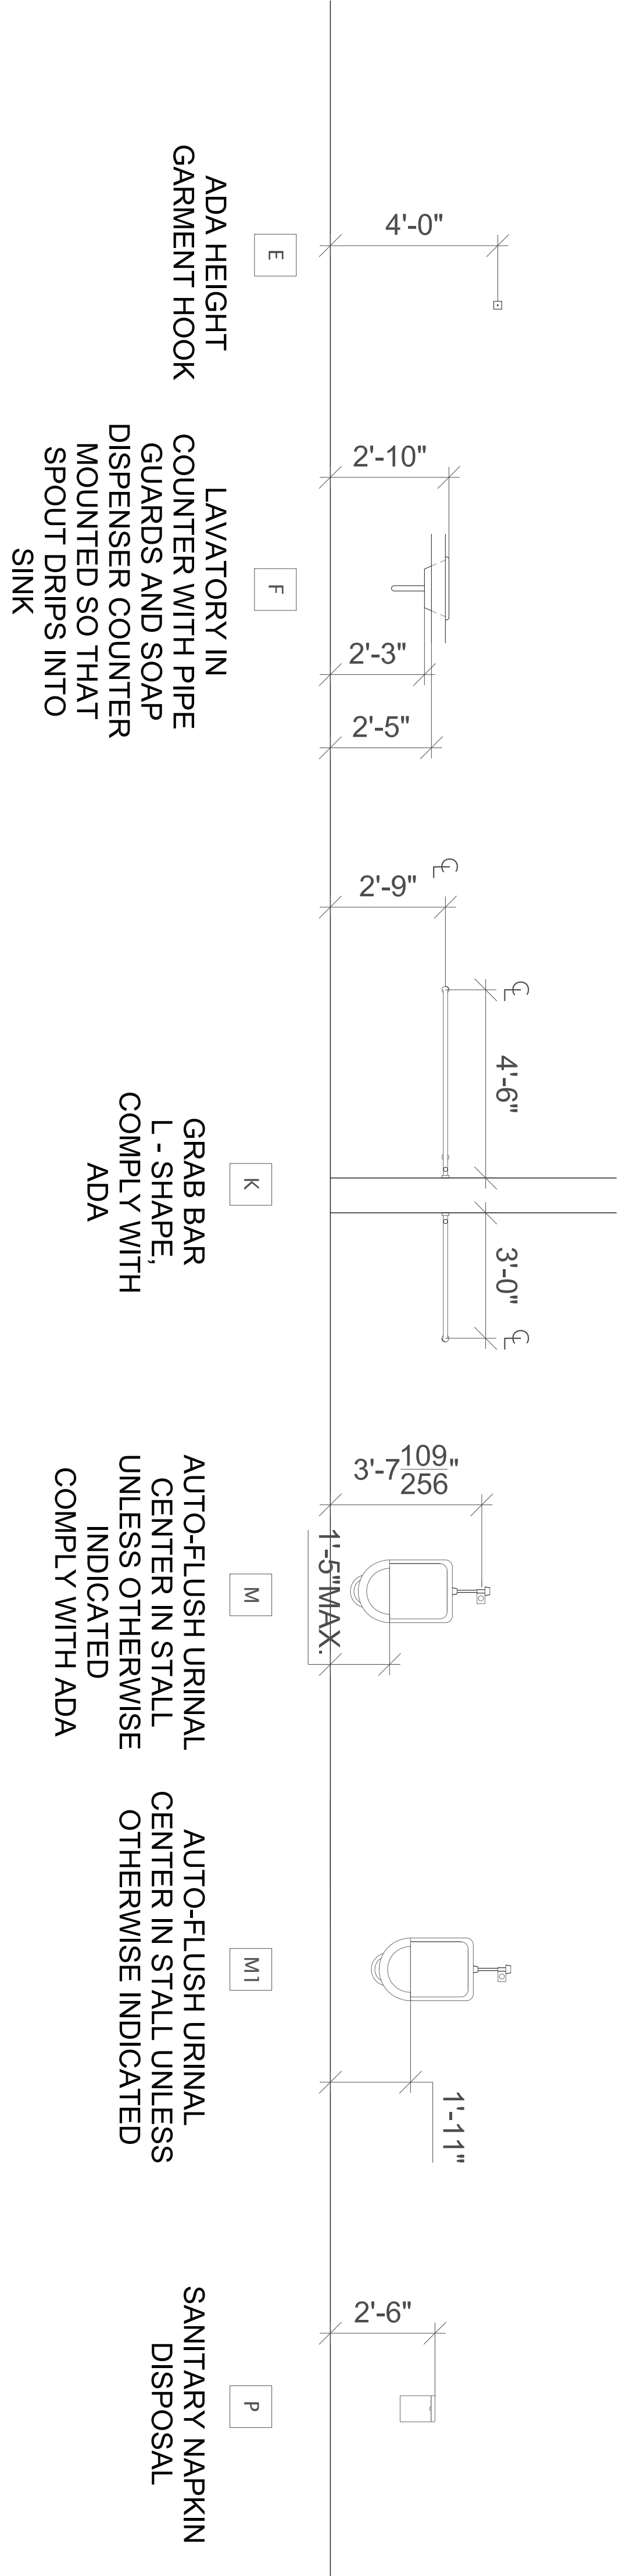

1. UPDATED WALL TILE FINISHES. DARKENED TOILET ACCESSORY LEGEND.		06MAY16
Revisions	Date	



NATIONAL CEMETERY ADMINISTRATION

Drawing Title

INTERIOR ELEVATIONS

Project Title

RENOV. HEMICYCLE RESTROOMS

Approved: Division Chief

Building Number

Checked

Drawn

Approved: Service Director

Location

Date

03/14/2016

Project No.

851-16-201

Drawing No.

A-103

Dwg. 4 Of 4