

# GENERAL NOTES

1 FOR CONTINUATION, SEE H-MH-1.1ND1.

# DRAWING NOTES

1 REMOTE DAMPER OPERATOR TO LINEAR SPRINKLER RISER (NOT SHOWN)






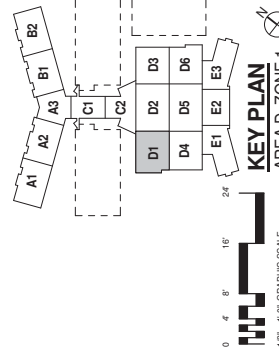



BUILDING IS FULLY SPRINKLERED

<b>CONSULTANTS:</b>		<b>ARCHITECT/ENGINEERS:</b>		<b>Professional Seals:</b>		<b>ELERBE BECKETT</b> <b>R/L F</b> A JOINT VENTURE 178 Union Avenue Winter Park, Florida 32789 407 847 1008		<b>HOSPITAL CLINIC LEVEL 1 AREA D DUCTWORK PLAN</b> Approved Project Director: <i>Melan Arabe</i>		<b>PROJECT FILE:</b> A NEW HOSPITAL FOR VAMC ORLANDO, FLORIDA Location: Orlando, Florida Date: 04 JUNE 2010 Checked: POU Drawn: EB Scale: R/L		<b>OFFICE OF FACILITIES MANAGEMENT</b> Project Number: 03250 Station: 01 AND 02 Drawing Number: H-MH-1.1FD1 Date: 04 JUNE 2010		<b>Department of Veterans Affairs</b>	
---------------------	--	-----------------------------	--	----------------------------	--	--	--	--	--	---	--	--	--	---------------------------------------	--

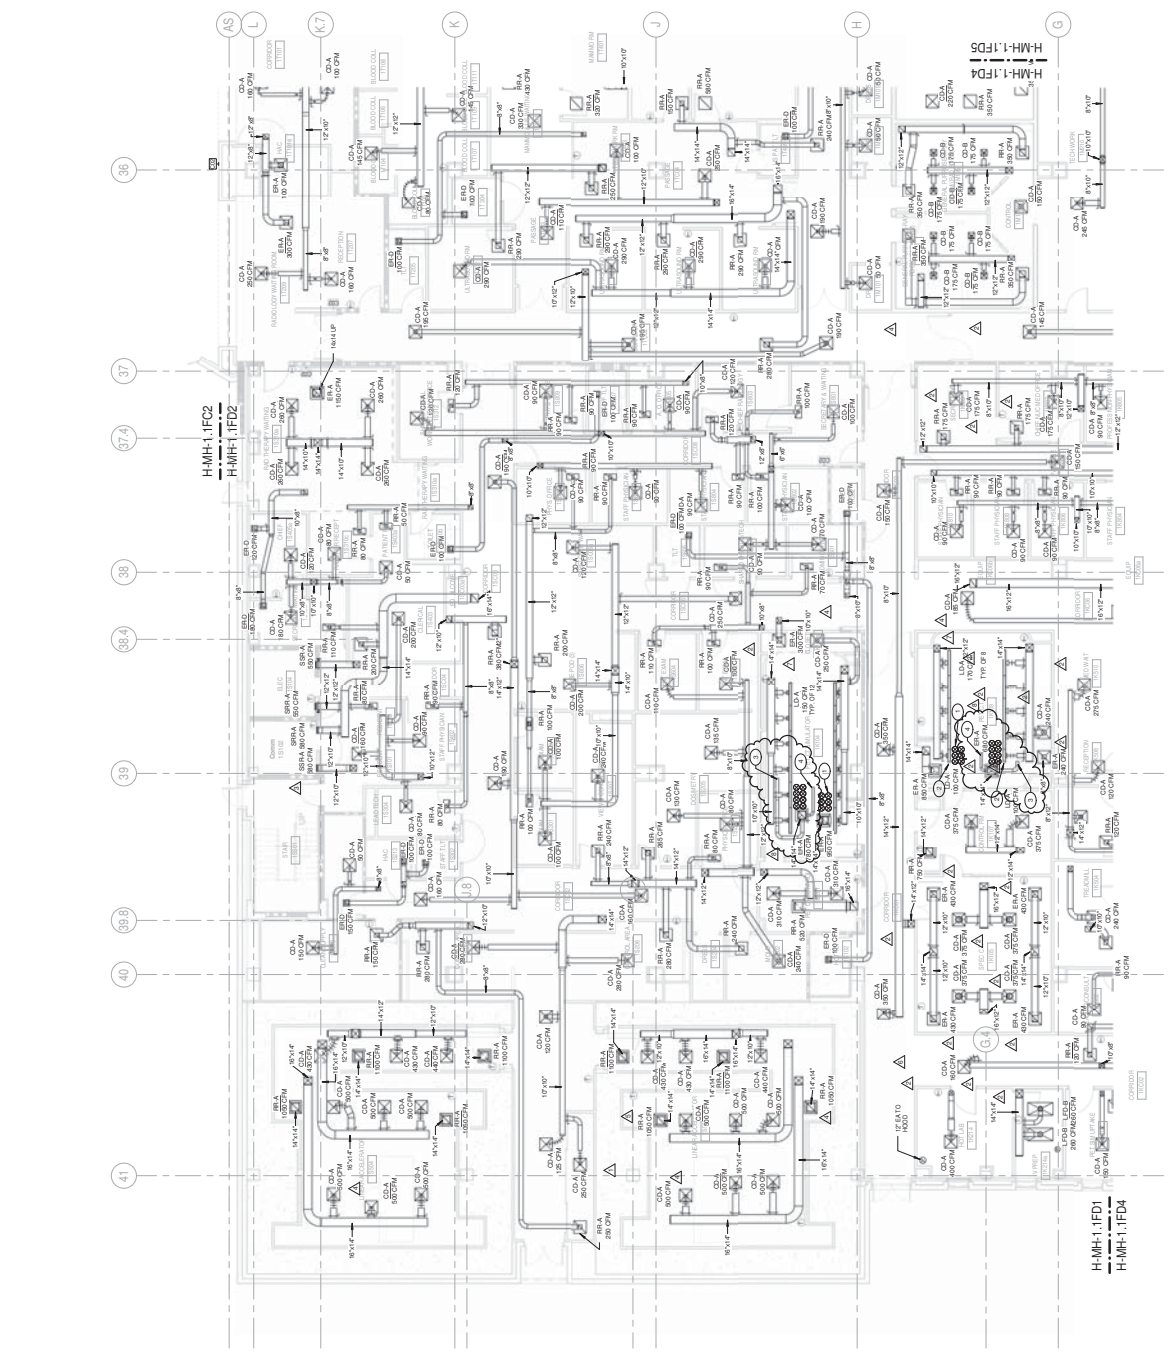

# GENERAL NOTES

1 FOR CONTINUATION UP, SEE H-MH-1.1ND2A.

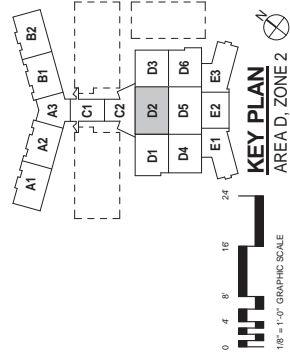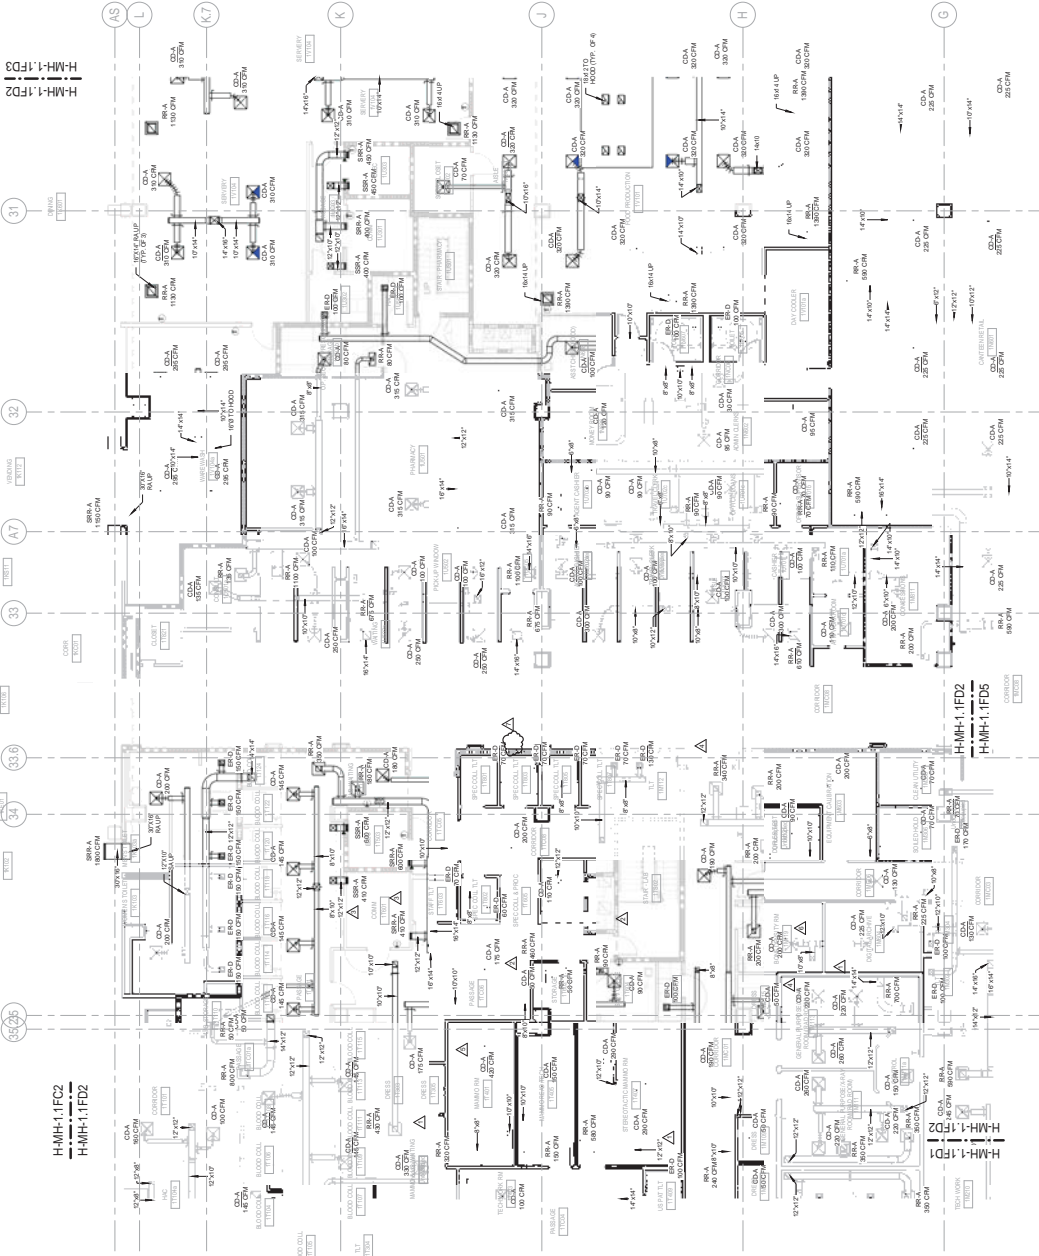


0 4 8' 16' 24'  
1/8" = 1'-0" GRAPHIC SCALE

**BUILDING IS FULLY SPRINKLERED**

						CONSULTANTS:		Professional Seals:		ARCHITECT/ENGINEERS:		PROJECT INFO		Project Number		OFFICE OF FACILITIES MANAGEMENT	
												HOSPITAL CLINIC LEVEL 1, AREA D, ZONE 2 DUCTWORK PLAN BID ALTERNATE NO. 3		67-3580		Department of Veterans Affairs	
												Approved Project Designer		Drawing Number		01 AND 02	
												Ellerbe Becket		Location		VAMC ORLANDO, FLORIDA	
												A JOINT VENTURE		City/State		H-MH1-1FD2-A	
												146 Linder Avenue, Suite 1000 West Palm Beach, Florida 33411 407.647.1000		Date		04 JUNE 2010	

[illegible]

---

CONSULTANTS:	Professional Seals:
	

**ARCHITECT/ENGINEERS:**

**RLF**

**A JOINT**

146 Lincoln Avenue  
Winter Park, Florida 32789  
407 647 1039

**ELLERBE BECKET**  
**7**  
**ENTURE**  
1001 G Street NW, Suite 1000  
Washington, D.C. 20001  
202 654 9300

Drawing Title  
HOSPITAL/CLINIC  
LEVEL 1, AREA D, ZONE 3  
DUCTWORK PLAN  
Approved: Project Director

Project 1: ESE	Location Orlando, Florida		Checked PGUJ	Drawn EB / RLF
Date 04 JUNE, 2010				

Product Number 673-950  
 Shipping Number 01 AND 02  
 Drawing Number H-MH1.1FD3  
 Drawing 2246 of 4322




Department of  
Veterans Affairs

**GENERAL NOTES**


## DRAWING NOTES

1. COPPER PIPING BELOW SLAB FOR FREEZE PROTECTION. SEE SPEC. SECTION 2321.13 FOR SPEC. ON COPPER PIPING.
2. 12-0" W x 2-6" H x 3-4" D PLENUM BLANKOFF UNUSED PORTION OF LOUVER. REFER TO DETAIL FOR LOUVER BLANKOFF PANEL DETAIL.
3. 7-6" H x 3-2" W x 2-6" D PLENUM BLANKOFF UNUSED PORTION OF LOUVER. REFER TO MH-5506S FOR LOUVER BLANKOFF PANEL DETAIL.

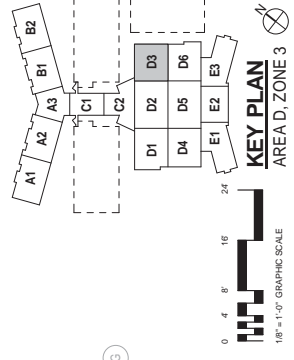

BUILDING IS FULLY SPRINKLERED

**KEY PLAN**  
AREA D, ZONE 3

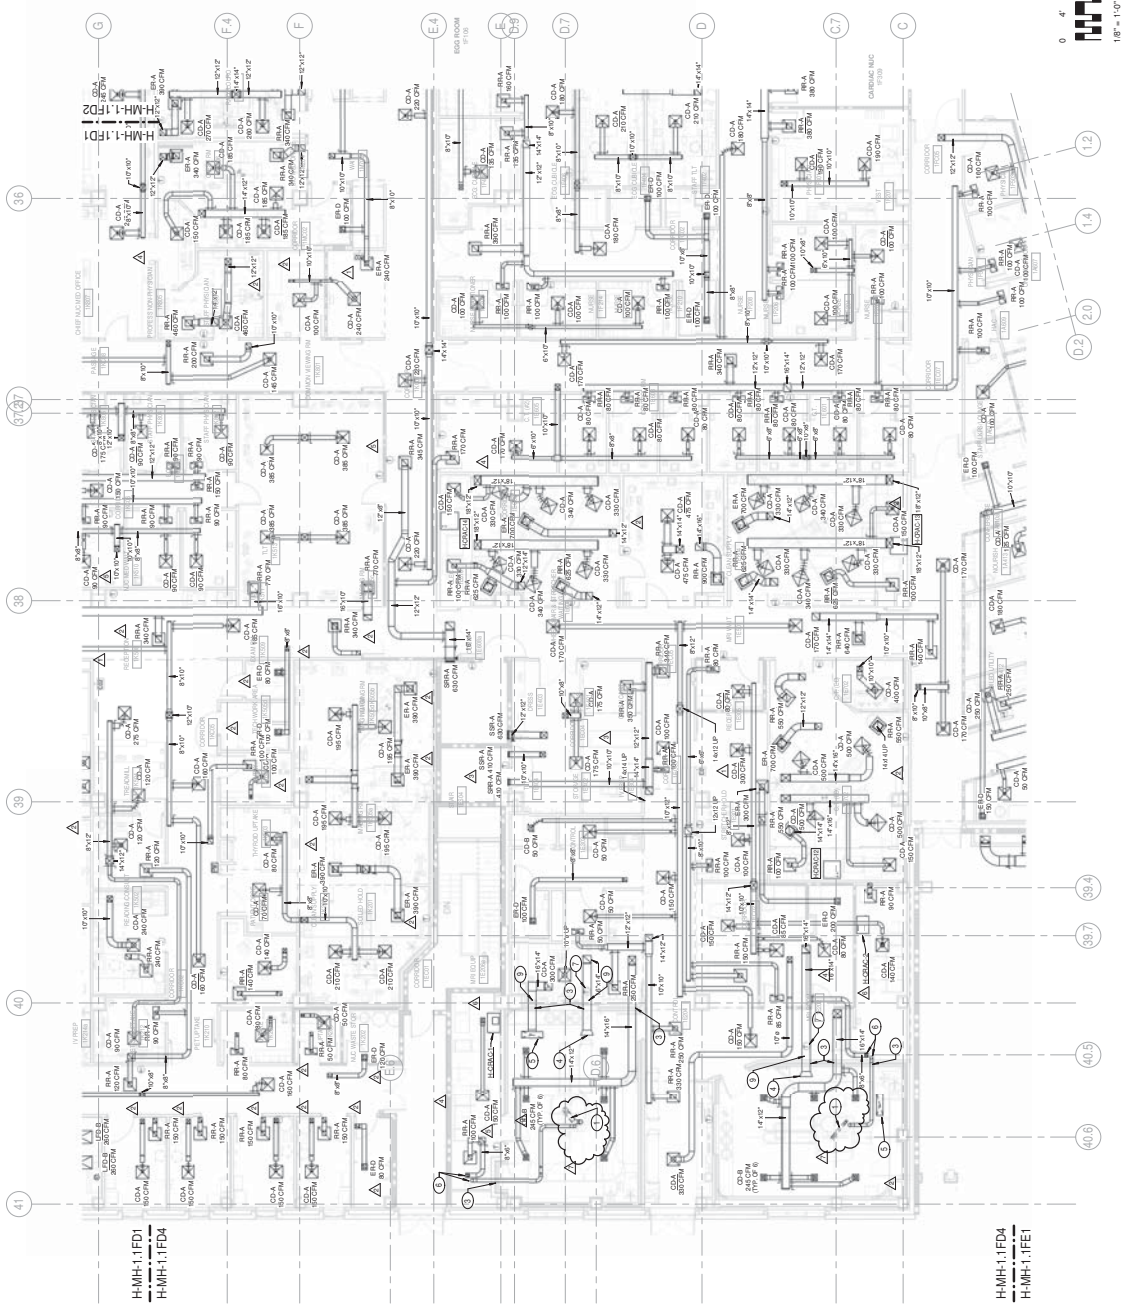


1 FOR CONTINUATION UP, SEE H-MH-1.1ND4A.

**DRAWING NOTES**

- 1 QUENCH VENT FROM MFR SYSTEM TO BE PROVIDED BY MFR VENDOR. CONTRACTOR TO PROVIDE INSULATION FOR QUENCH VENT INSIDE RF SHIELD. SEE SPECIFICATION SECTION 230711 FOR INSULATION REQUIREMENTS.
- 2 NOT USED
- 3 PROVIDE RF WAVE FILTER AT DUCT

- 2 OPEN END DUCT TO AIR TO X-MAX WITH NORMAL MESH SCREEN (130 CFM).
- 3 4" X 2" EXHAUST GRILLE (130 CFM).
- 4 CONNECT TO EXHAUST COIL DRAINAGE SYSTEM COORDINATE WITH MECHANICAL MANUFACTURER FOR DUCT LOCATION.
- 5 DUCT REQUIRED TEMPERATURE SENSOR.
- 6 NOT USED.

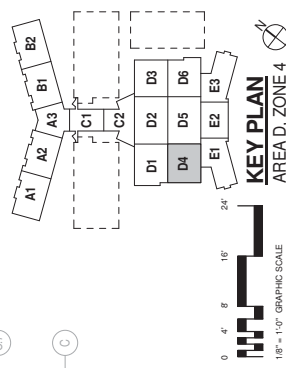



BUILDING IS FULLY SPRINKLERED

[illegible]




# GENERAL NOTES

1. FOR CONTINUATION UP, SEE H-MH-1.IND5A

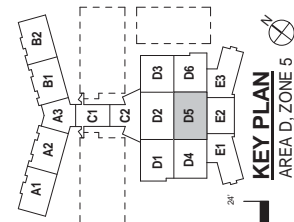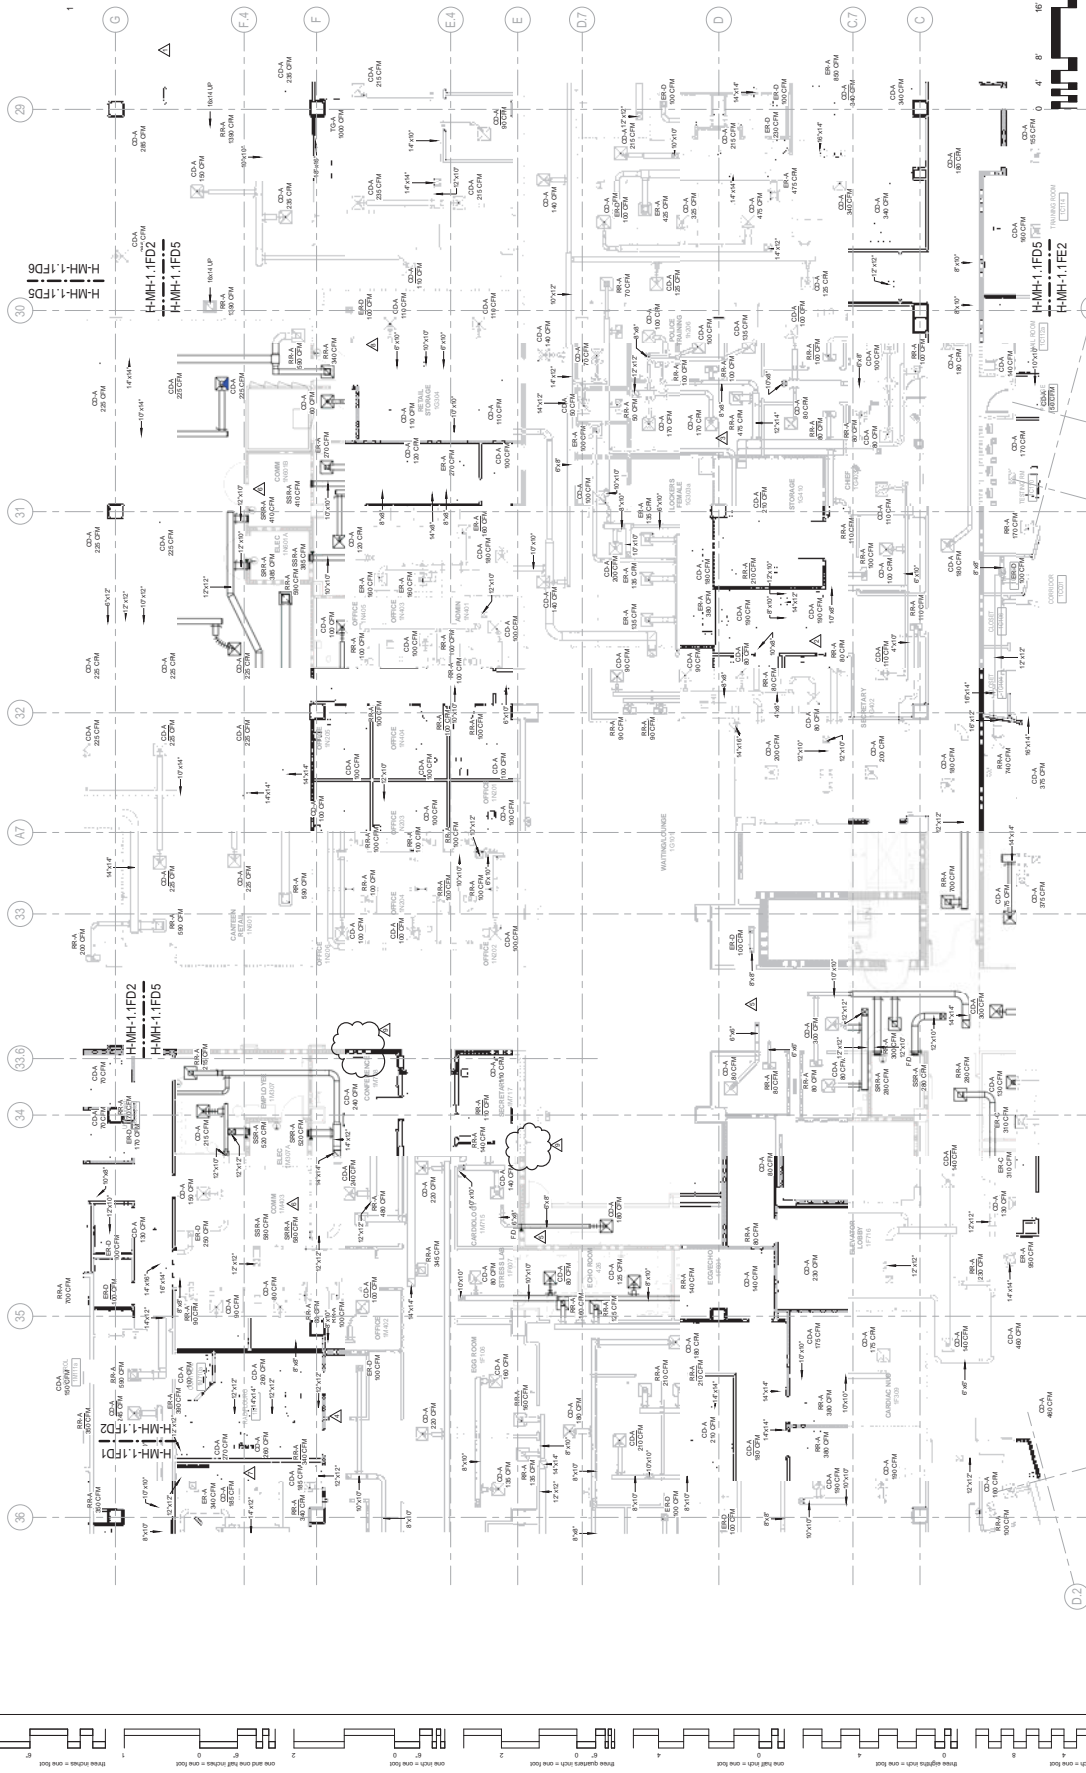

**BUILDING IS FULLY SPRINKLERED**

<b>PROJECT TITLE</b> A NEW HOSPITAL FOR VAMC ORLANDO, FLORIDA		<b>PROJECT NUMBER</b> 03-050		<b>OFFICE OF FACILITIES MANAGEMENT</b> Department of Veterans Affairs	
<b>DESIGN</b> H-MH-1.1FD5		<b>DATE</b> 01 AND 02		<b>REVISIONS</b> H-MH-1.1FD5-A	
<b>APPROVED PROJECT DESIGNER</b> [Signature]		<b>DATE</b> 04 JUNE 2010		<b>BY</b> [Signature]	
<b>ARCHITECT/ENGINEERS:</b> <b>RLE</b> ELLEN BECKETT 1765 United Avenue Winter Park, Florida 32789 407.847.1008		<b>PROFESSIONAL SEALS:</b> 		<b>CONSULTANTS:</b>	
<b>DATE</b> 06/17/2011		<b>DESCRIPTION</b> CR 098		<b>DATE</b> 06/17/2011	
<b>DATE</b> 06/16/2011		<b>DESCRIPTION</b> CR 122		<b>DATE</b> 06/16/2011	
<b>DATE</b> 10/14/2011		<b>DESCRIPTION</b> CR 160		<b>DATE</b> 10/14/2011	
<b>DATE</b> 10/17/2011		<b>DESCRIPTION</b> CR 132		<b>DATE</b> 10/17/2011	
<b>DATE</b> 04/02/2012		<b>DESCRIPTION</b> CR 272		<b>DATE</b> 04/02/2012	
<b>DATE</b> 10/05/2012		<b>DESCRIPTION</b> CR 353		<b>DATE</b> 10/05/2012	

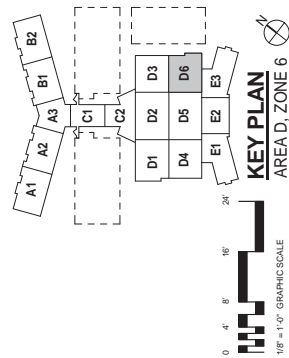

BUILDING IS FULLY SPRINKLERED

[illegible]

VA FORM 08-6231, OCT 1978