



②

[illegible]

BUILDING IS FULLY SPRINKLERED

NOTES:

GENERAL NOTES

1. FITCH STEAM AND CONDENSATE DOWNWARD 1" INCH PER 40 FEET.



REMARKS

1. PPE EXPANSION JOINTS WITH MINIMUM 2 INCHES EXPANSION AND ANCHORED AT EACH END.

2. PPE ANCHOR (TYPICAL)


3. SEE H-MP1.1ND2 FOR CONDENSATE DRAINAGE OF PAN COLUMNS.

4. SEE H-MP1.1ND2 FOR CONDENSATE DRAINAGE OF PAN COLUMNS.

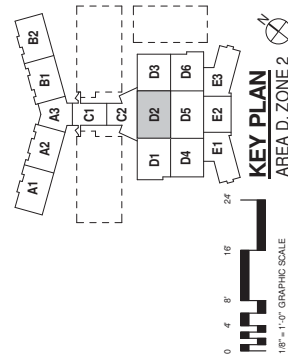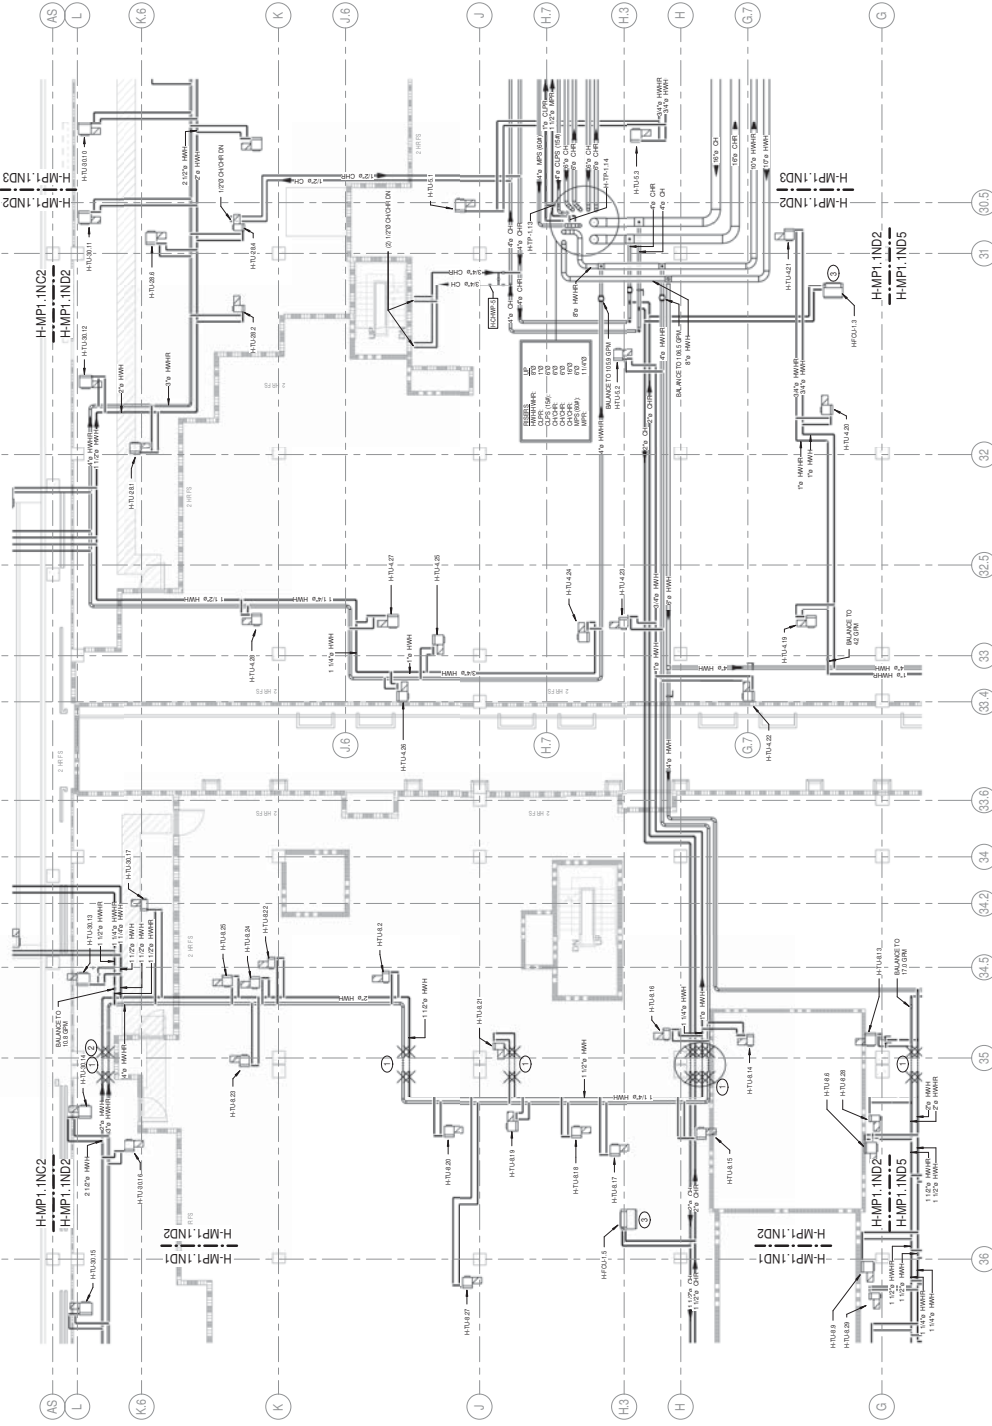

BUILDING IS FULLY SPRINKLERED

																																																																																																																																																																																																																																																																																																																																																																																																																																																																																																																																																																																																																																																																																																																																																																																																																																																																																																																																																																																																																																																																																																																																																																																																																																																																																																																																																																</	
--	--	----	--

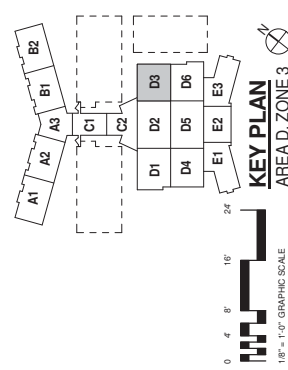[illegible]

GENERAL NOTES

1. PITCH TEAM AND CONDENSATE DOWNWARD 1 INCH PER 40 FEET.
- SPECIFIC NOTES:
- ① SEE H-PL-1, IND-3 FOR CONDENSATE DRAINAGE OF FAN COIL UNITS AND BLOWER COIL UNITS.



NOTES:

GENERAL NOTES

1. FITCH STEAM AND CONDENSATE DOWNWARD 1" INCH PER 40 FEET.



SECTION NOTES


- ① PPE EXPANSION JOINTS WITH MINIMUM 2 INCHES EXPANSION AND ANCHORED AT EACH END.
- ② PPE ANCHOR (TYPICAL)
- ③ SEE H-PL 1.103 FOR CONDENSATE DRAINAGE OF PAN/COL. UNITS.

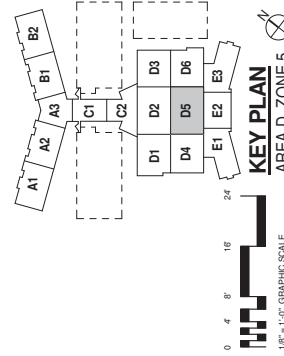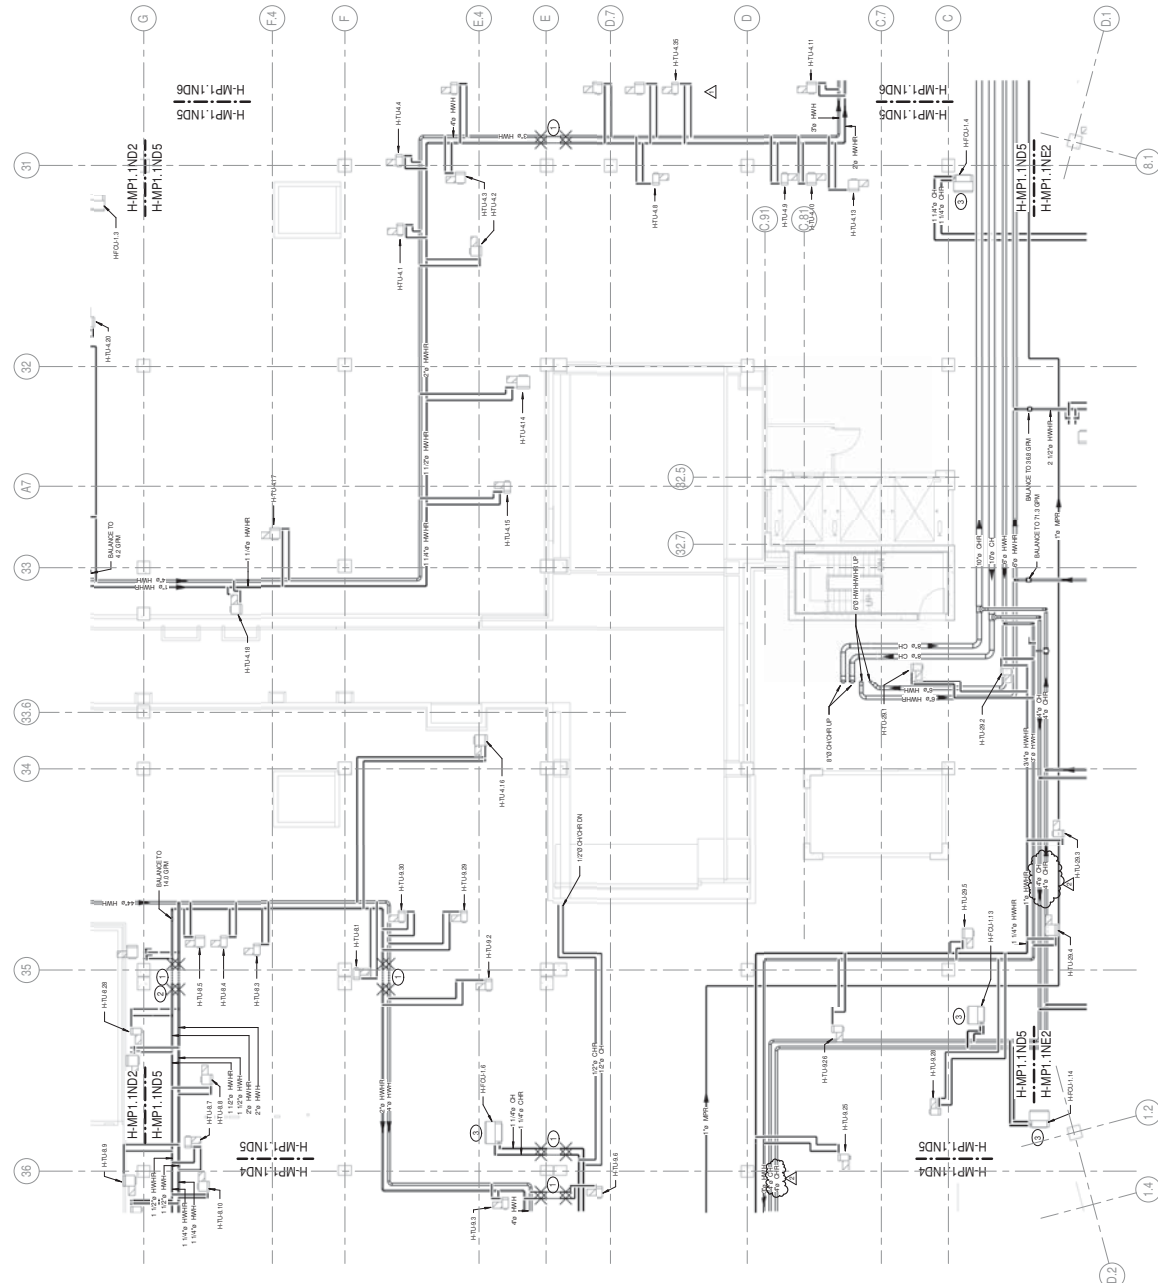

BUILDING IS FULLY SPRINKLERED

No.	Description	Date	CONSULTANTS:		Professional Seals:		ARCHITECT/ENGINEERS:		HOSPITAL / CLINIC		PROJECT No.		OFFICE OF	
1	CPR098	07/09/2011							HOSPITAL / CLINIC	A NEW HOSPITAL FOR	Project Number	03-250	Office of	FACILITIES
2	CPR122	09/16/2011							LEVEL 1, AREA D, ZONE 5	VAMC ORLANDO, FLORIDA	Survey	01 AND 02	Office of	MANAGEMENT
									INTERMITTENT PIPING PLAN	Orlando, Florida	Owner's Name	H-MP1.1ND5		
									Approved Project Owner	Orlando, Florida	Owner's Name	H-MP1.1ND5		
											Drawn	04 JUNE 2010	Checked	Dep. 04/01/12

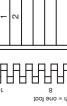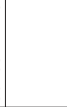

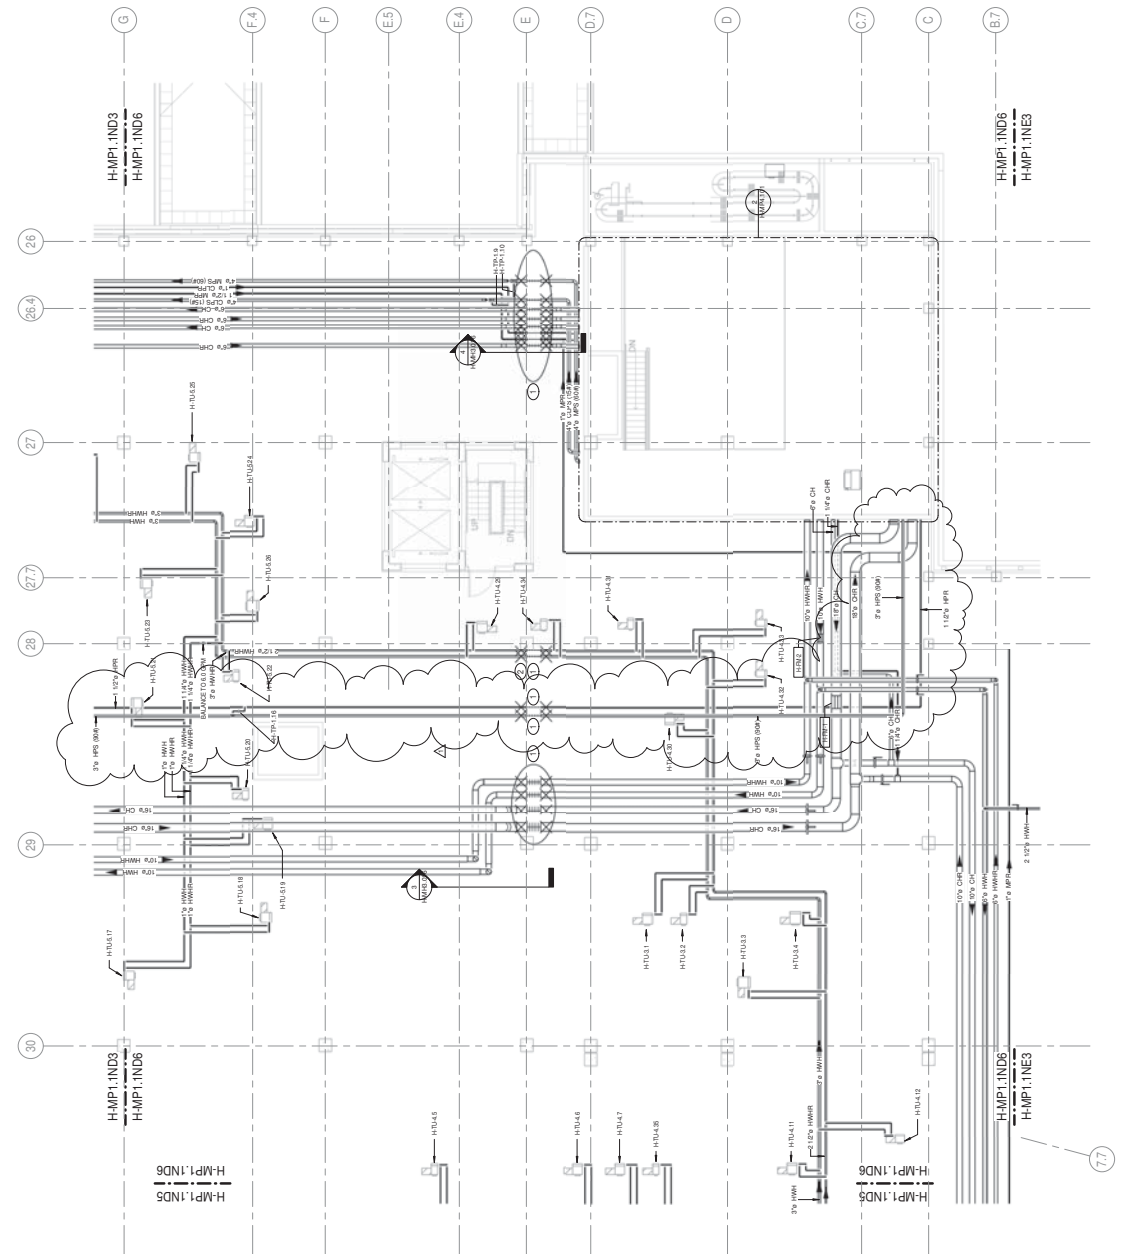

NOTES:


GENERAL NOTES

1. PITCH STEAM AND CONDENSATE PIPES TO DRAINAGE POINTS.

SPECIFIC NOTES

① PIPE EXPANSION JOINTS SHALL BE INSTALLED AT 2 INCHES CONTRACTION FROM EACH END OF THE PIPE ANCHOR AT EACH END OF THE PIPE.

② PIPE ANCHOR (TYPICAL)

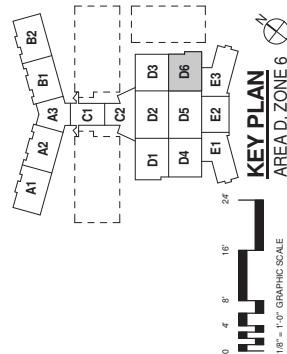

BUILDING IS FULLY SPRINKLERED

[illegible]

FORM 01-0211 OCT 1978