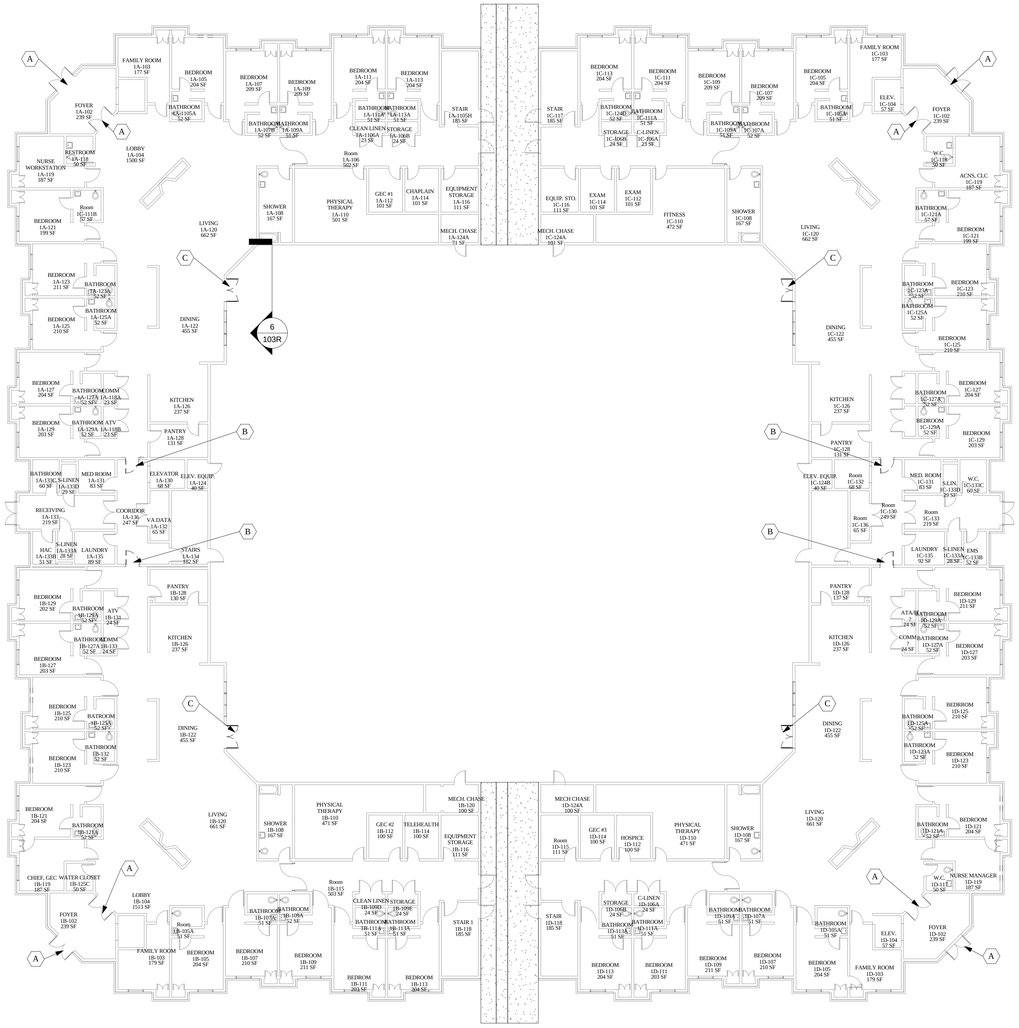

1 Level 1 - EXISTING
1/16" = 1'-0"

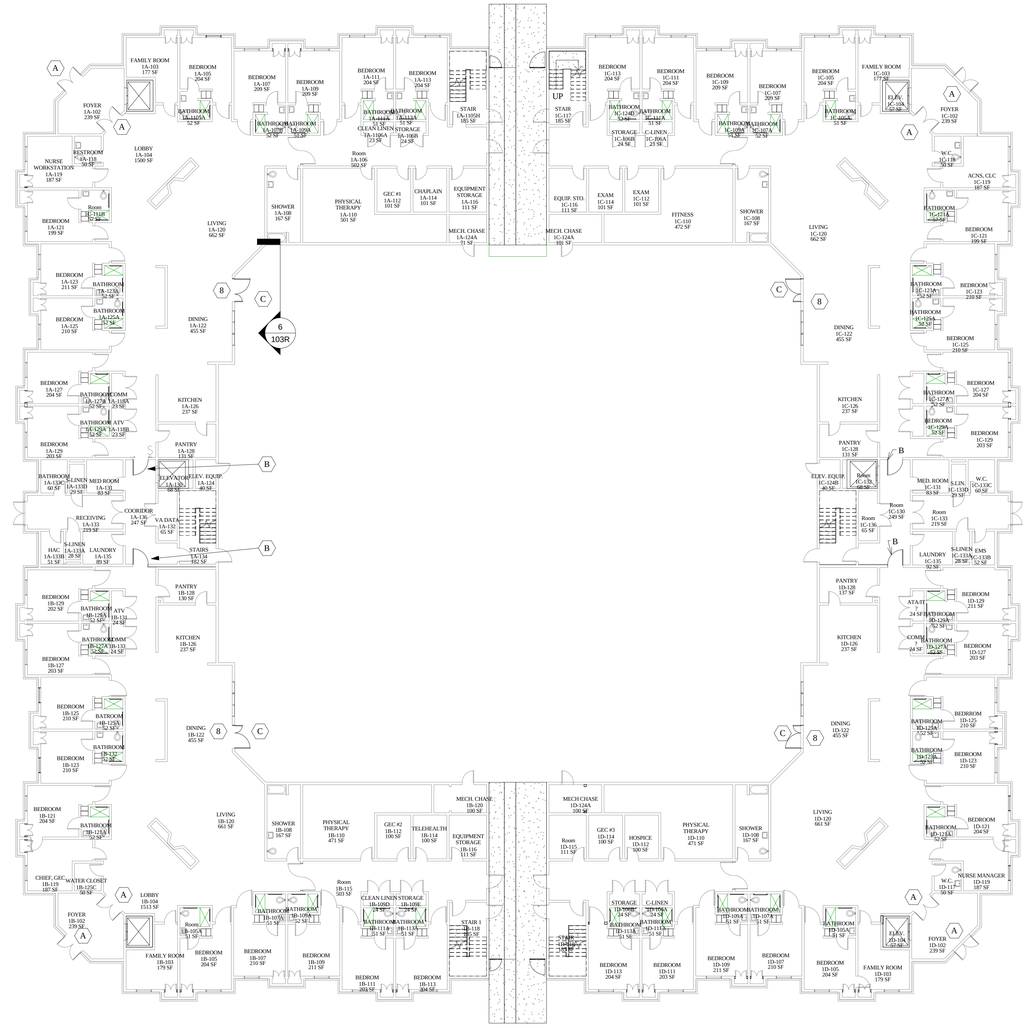

2 Level 1 New
1/16" = 1'-0"

GENERAL NOTES
1/4" = 1'-0"

1. ALL FINISHES TO MATCH EXISTING FINISHES
2. FIELD VERIFY ALL DIMENSIONS, DOOR TYPES, AND DOOR SWINGS.

NOTE BY SYMBOL
1/4" = 1'-0"

1. EXISTING FIRE STROBE TO BE RELOCATED AS NEEDED
2. EXISTING FIRE PULL TO BE RELOCATED AS NEEDED
3. EXISTING KEY PAD TO BE RELOCATED AS NEEDED
4. EXISTING LIGHT SWITCH TO BE RELOCATED AS NEEDED
5. EXISTING PANIC BAR TO BE REMOVED AND RETURNED TO THE VA
6. EXISTING AUTOMATIC OPENER TO BE REMOVED AND INSTALLED ON NEW DOOR
7. EXISTING EXIT SIGN TO REMAIN
8. LOCATION OF VERTICAL AIR CURTAIN TO BE DETERMINED BY VA

A. DOORS ARE TO HAVE SINGLE AUTOMATIC OPENERS REMOVED AND REPLACE WITH DOUBLES.

B. CURRENT 42" WIDE DOORS TO BE REMOVED AND REPLACED WITH 1-HR FIRE RATED DOORS OF THE SAME TYPE. RELOCATED ADJACENT INFASTRUCTURE AS NEEDED

C. CURRENT DOORS TO BE REMOVED AND REPLACED WITH A DOUBLE UNEVEN DOOR SET. ONE LEAF SHALL BE 48" WIDE AND THE OTHER SHALL BE 24". PANIC HARDWARE IS TO BE INSTALLED ON BOTH LEAFS. EXISTING AUTOMATIC DOOR OPENER IS TO BE INSTALLED ON NEW 48" LEAF. NEW SYSTEM SHALL BE NO WIDER THAN THE EXISTING OPENING (6'). NEW DOOR TO BE INSTALLED WITH A VERTICAL AIR CURTAIN THAT COVERS THE ENTIRE HEIGHT OF THE NEW DOOR OPENING. INSTALLATION LOCATION OF VERTICAL AIR CURTAIN TO BE DETERMINED BY THE VA.

2. DOOR TYPE "C" CHANGED FROM SLIDER TO UNEVEN SWING	5-16-16
1. PANIC HARDWARE REMOVED FROM NEW DOOR "B" (TYP.)	5-16-16
Revisions:	Date

CONSULTANTS:

ARCHITECT/ENGINEERS:

Drawing Title: LEVEL 1

Approved: Project Director

Project Title: BUILDING 221 DOOR REPLACEMENTS AND UPGRADES

Location: TEMPLE, TX

Date: 5/17/2016 2:03:38 PM

Checked: CY

Drawn: TB

Project Number: 674-16-003

Building Number: 221

Drawing Number: 101R

Office of Construction and Facilities Management

Department of Veterans Affairs

VA FORM 08-6231