1 ADMINISTRATION BUILDING
PLAN

1" = 40' - 0"

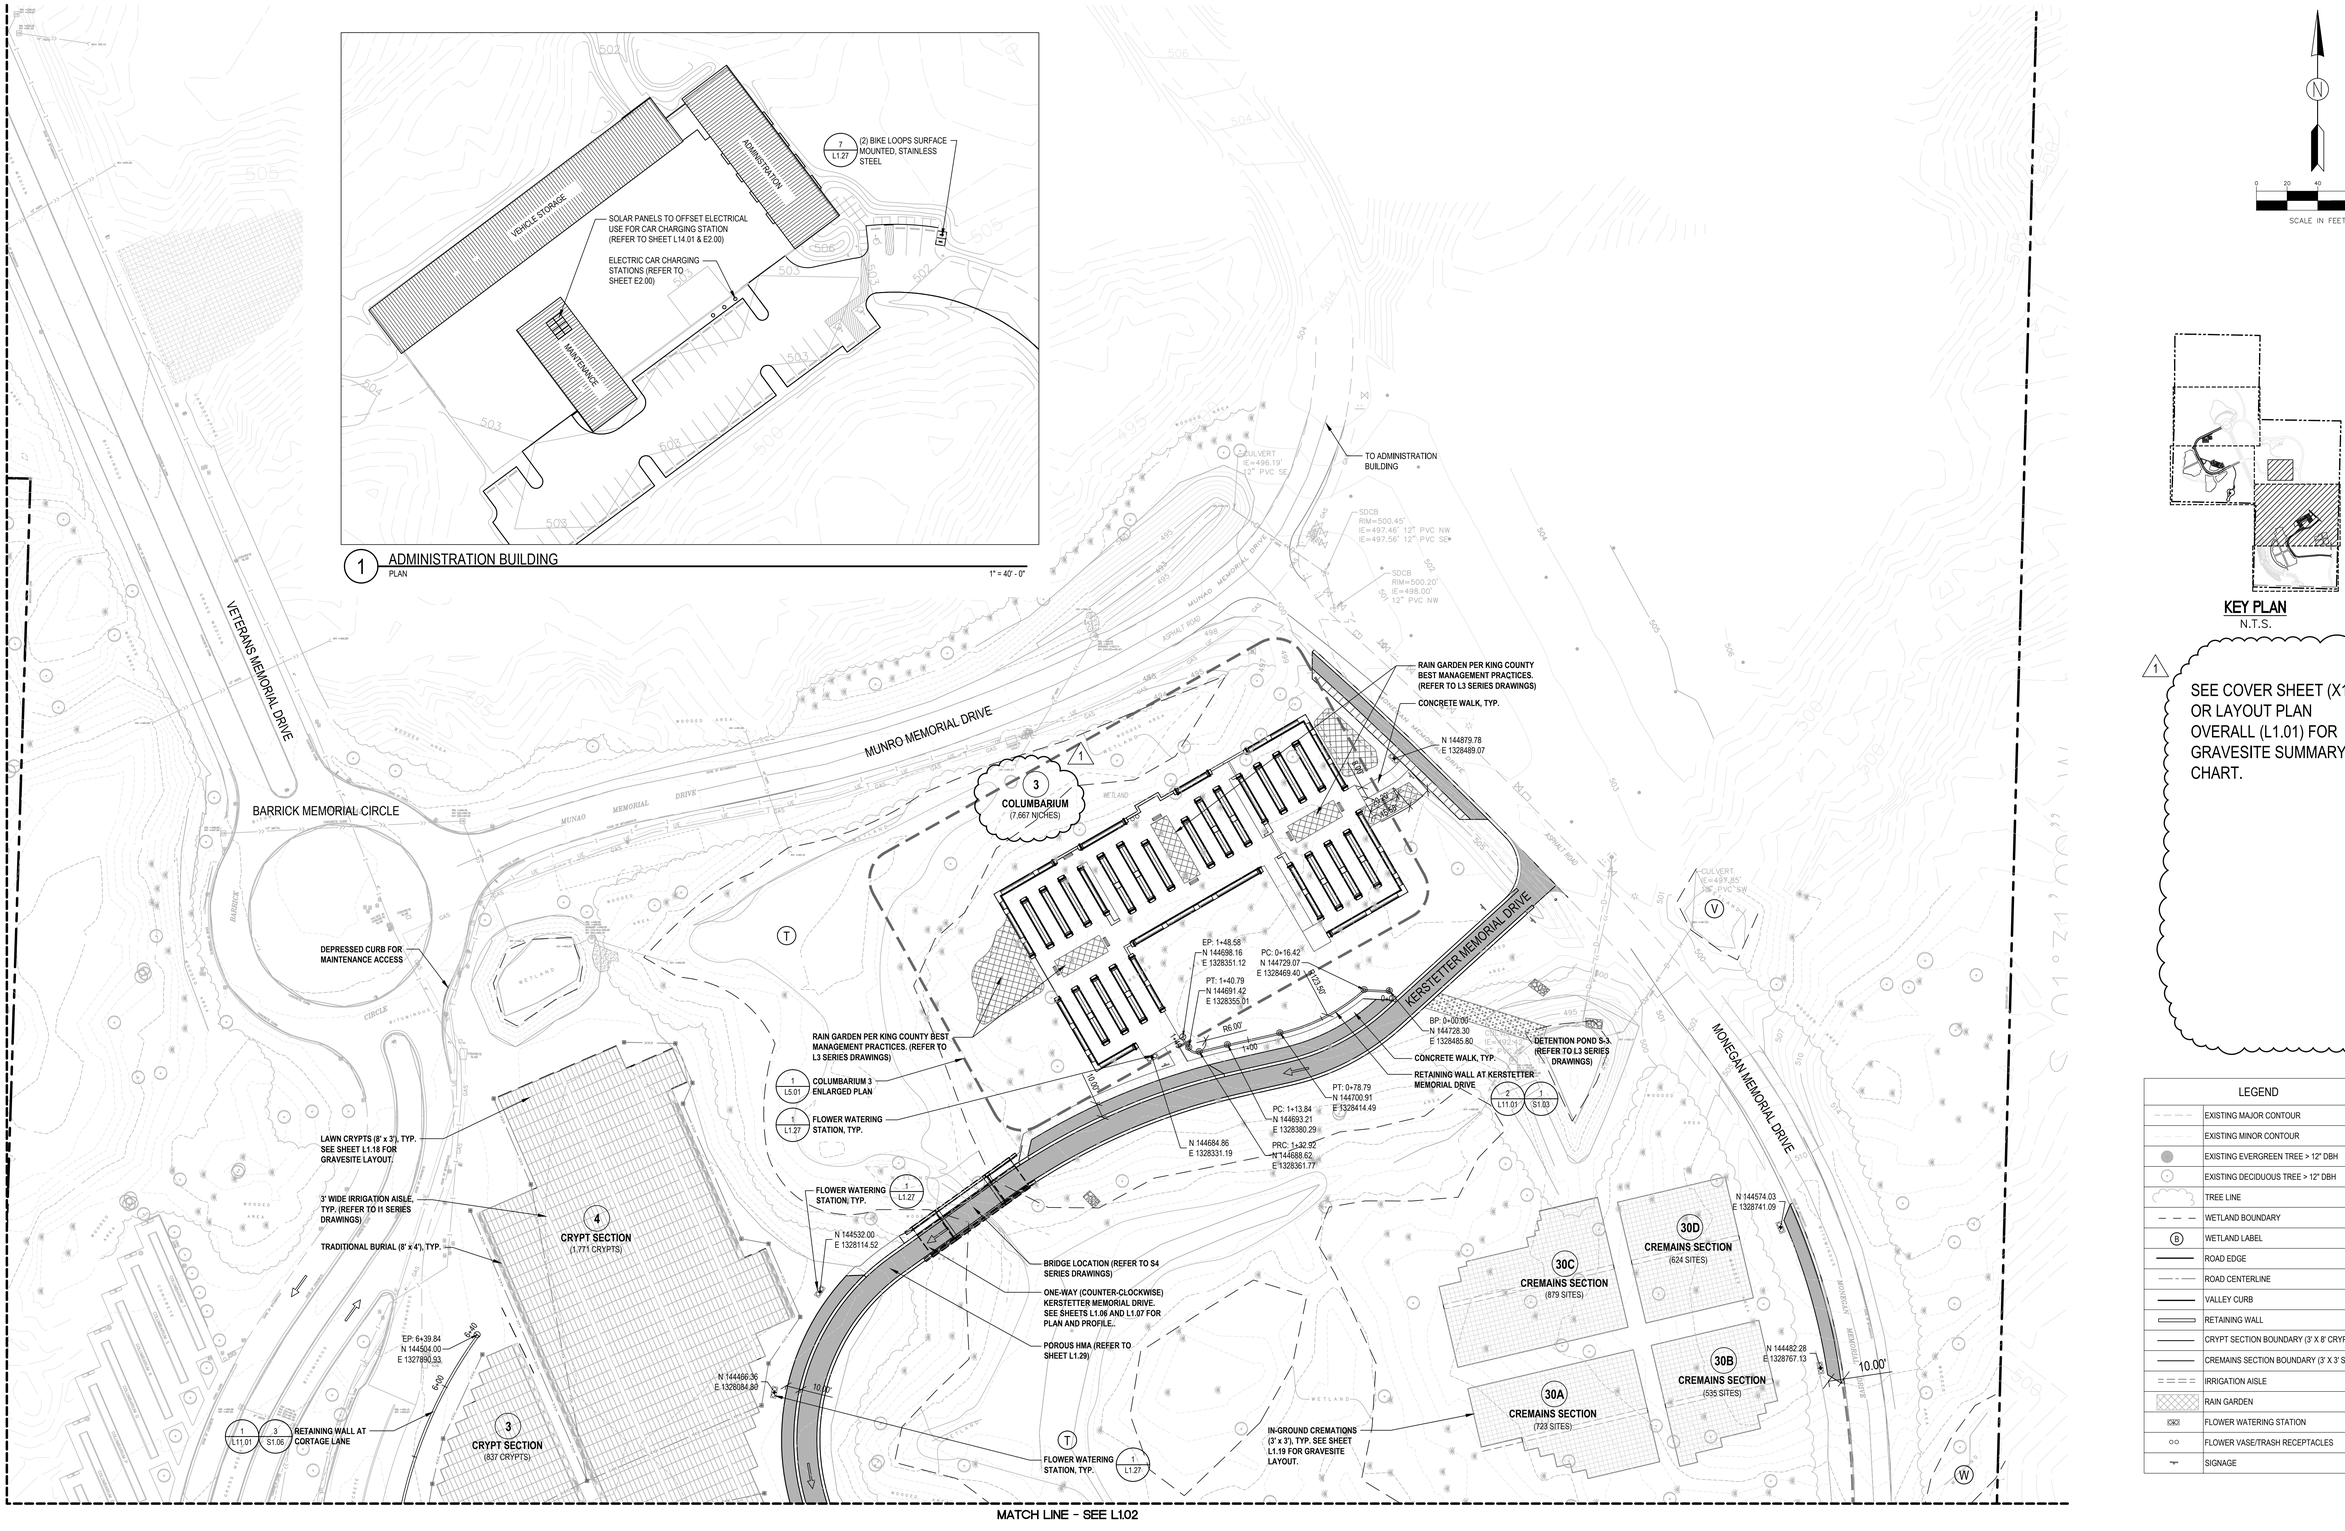

MATCH LINE - SEE L1.02

N

0 20 40 80

SCALE IN FEET

KEY PLAN
N.T.S.

1 SEE COVER SHEET (X1.01) OR LAYOUT PLAN OVERALL (L1.01) FOR GRAVESITE SUMMARY CHART.

LEGEND	
	EXISTING MAJOR CONTOUR
	EXISTING MINOR CONTOUR
	EXISTING EVERGREEN TREE > 12" DBH
	EXISTING DECIDUOUS TREE > 12" DBH
	TREE LINE
	WETLAND BOUNDARY
B	WETLAND LABEL
	ROAD EDGE
	ROAD CENTERLINE
	VALLEY CURB
	RETAINING WALL
	CRYPT SECTION BOUNDARY (3' X 8' CRYPTS)
	CREMAINS SECTION BOUNDARY (3' X 3' SITES)
	IRRIGATION AISLE
	RAIN GARDEN
	FLOWER WATERING STATION
	FLOWER VASE/TRASH RECEPTACLES
	SIGNAGE

Amendment 4	1	11.11.2011
Revisions:		Date

CONSULTANTS:

Anderson Engineering of Minnesota, LLC
13605 1st AVENUE NORTH, SUITE 100, PLYMOUTH, MN 55441
TEL (763) 412-4000 FAX (763) 412-4090

Aqua Engineering, Inc.
Innovative Water Solutions
4803 Innovation Drive
Fort Collins, Colorado 80525
Phone (970) 229-9668
FAX (970) 226-3855

JJR
landscape architecture planning urban design civil engineering environmental science
JJR, LLC
110 MILLER AVENUE,
ANN ARBOR, MICHIGAN 48104
734.662.4457 T 734.662.0779 F
www.jjr-us.com

RUSHING Engineering – Essentials – Delivery
BLACKBIRD

ALLEGIANCE GROUP, LLC

STATE OF MICHIGAN HENRY L. RYMA LANDSCAPE ARCHITECT No. 1636 REGISTERED LANDSCAPE ARCHITECT

ARCHITECT/ENGINEERS:

kpff Consulting Engineers
1601 Fifth Avenue, Suite 1600
Seattle, Washington 98101-3665
(206) 622-5822 Fax (206) 622-8130

Drawing Title: LAYOUT PLAN - SOUTH 2

Approved Project Director

Project Title: TAHOMA NATIONAL CEMETERY PHASE 2 GRAVESITE DEVELOPMENT
18600 SE 240TH STREET, KENT WASHINGTON

Location: KENT, WASHINGTON

Date: 9-15-2011 | Checked: CG/PE | Drawn: JS/JM

Project Number: 919PC2007

Drawing Reference Number: 031

Drawing Number: L1.03

Office of Construction and Facilities Management
Department of Veterans Affairs

VA FORM 08-6231

Nov 10, 2011 - 8:30am jsmoot
N:\Projects\320277.0000\Admin\Const Admin\CAD\Tahoma NC constr record set\Sheet\320277-L4.01-SH.dwg
N:\Projects\320277.0000\Admin\Const Admin\CAD\Tahoma NC constr record set\Xrefs\ (COB-SHEET.dwg \ X-INC2-FD \ BRIDGE.dwg \ X-INC2-FD \ BRIDGE_DTL \ BRIDEY \ X-INC2-SV-H \ X-INC2-SV-PNT \ X-INC2-SV-PNT \ X-INC2-SV-PNT