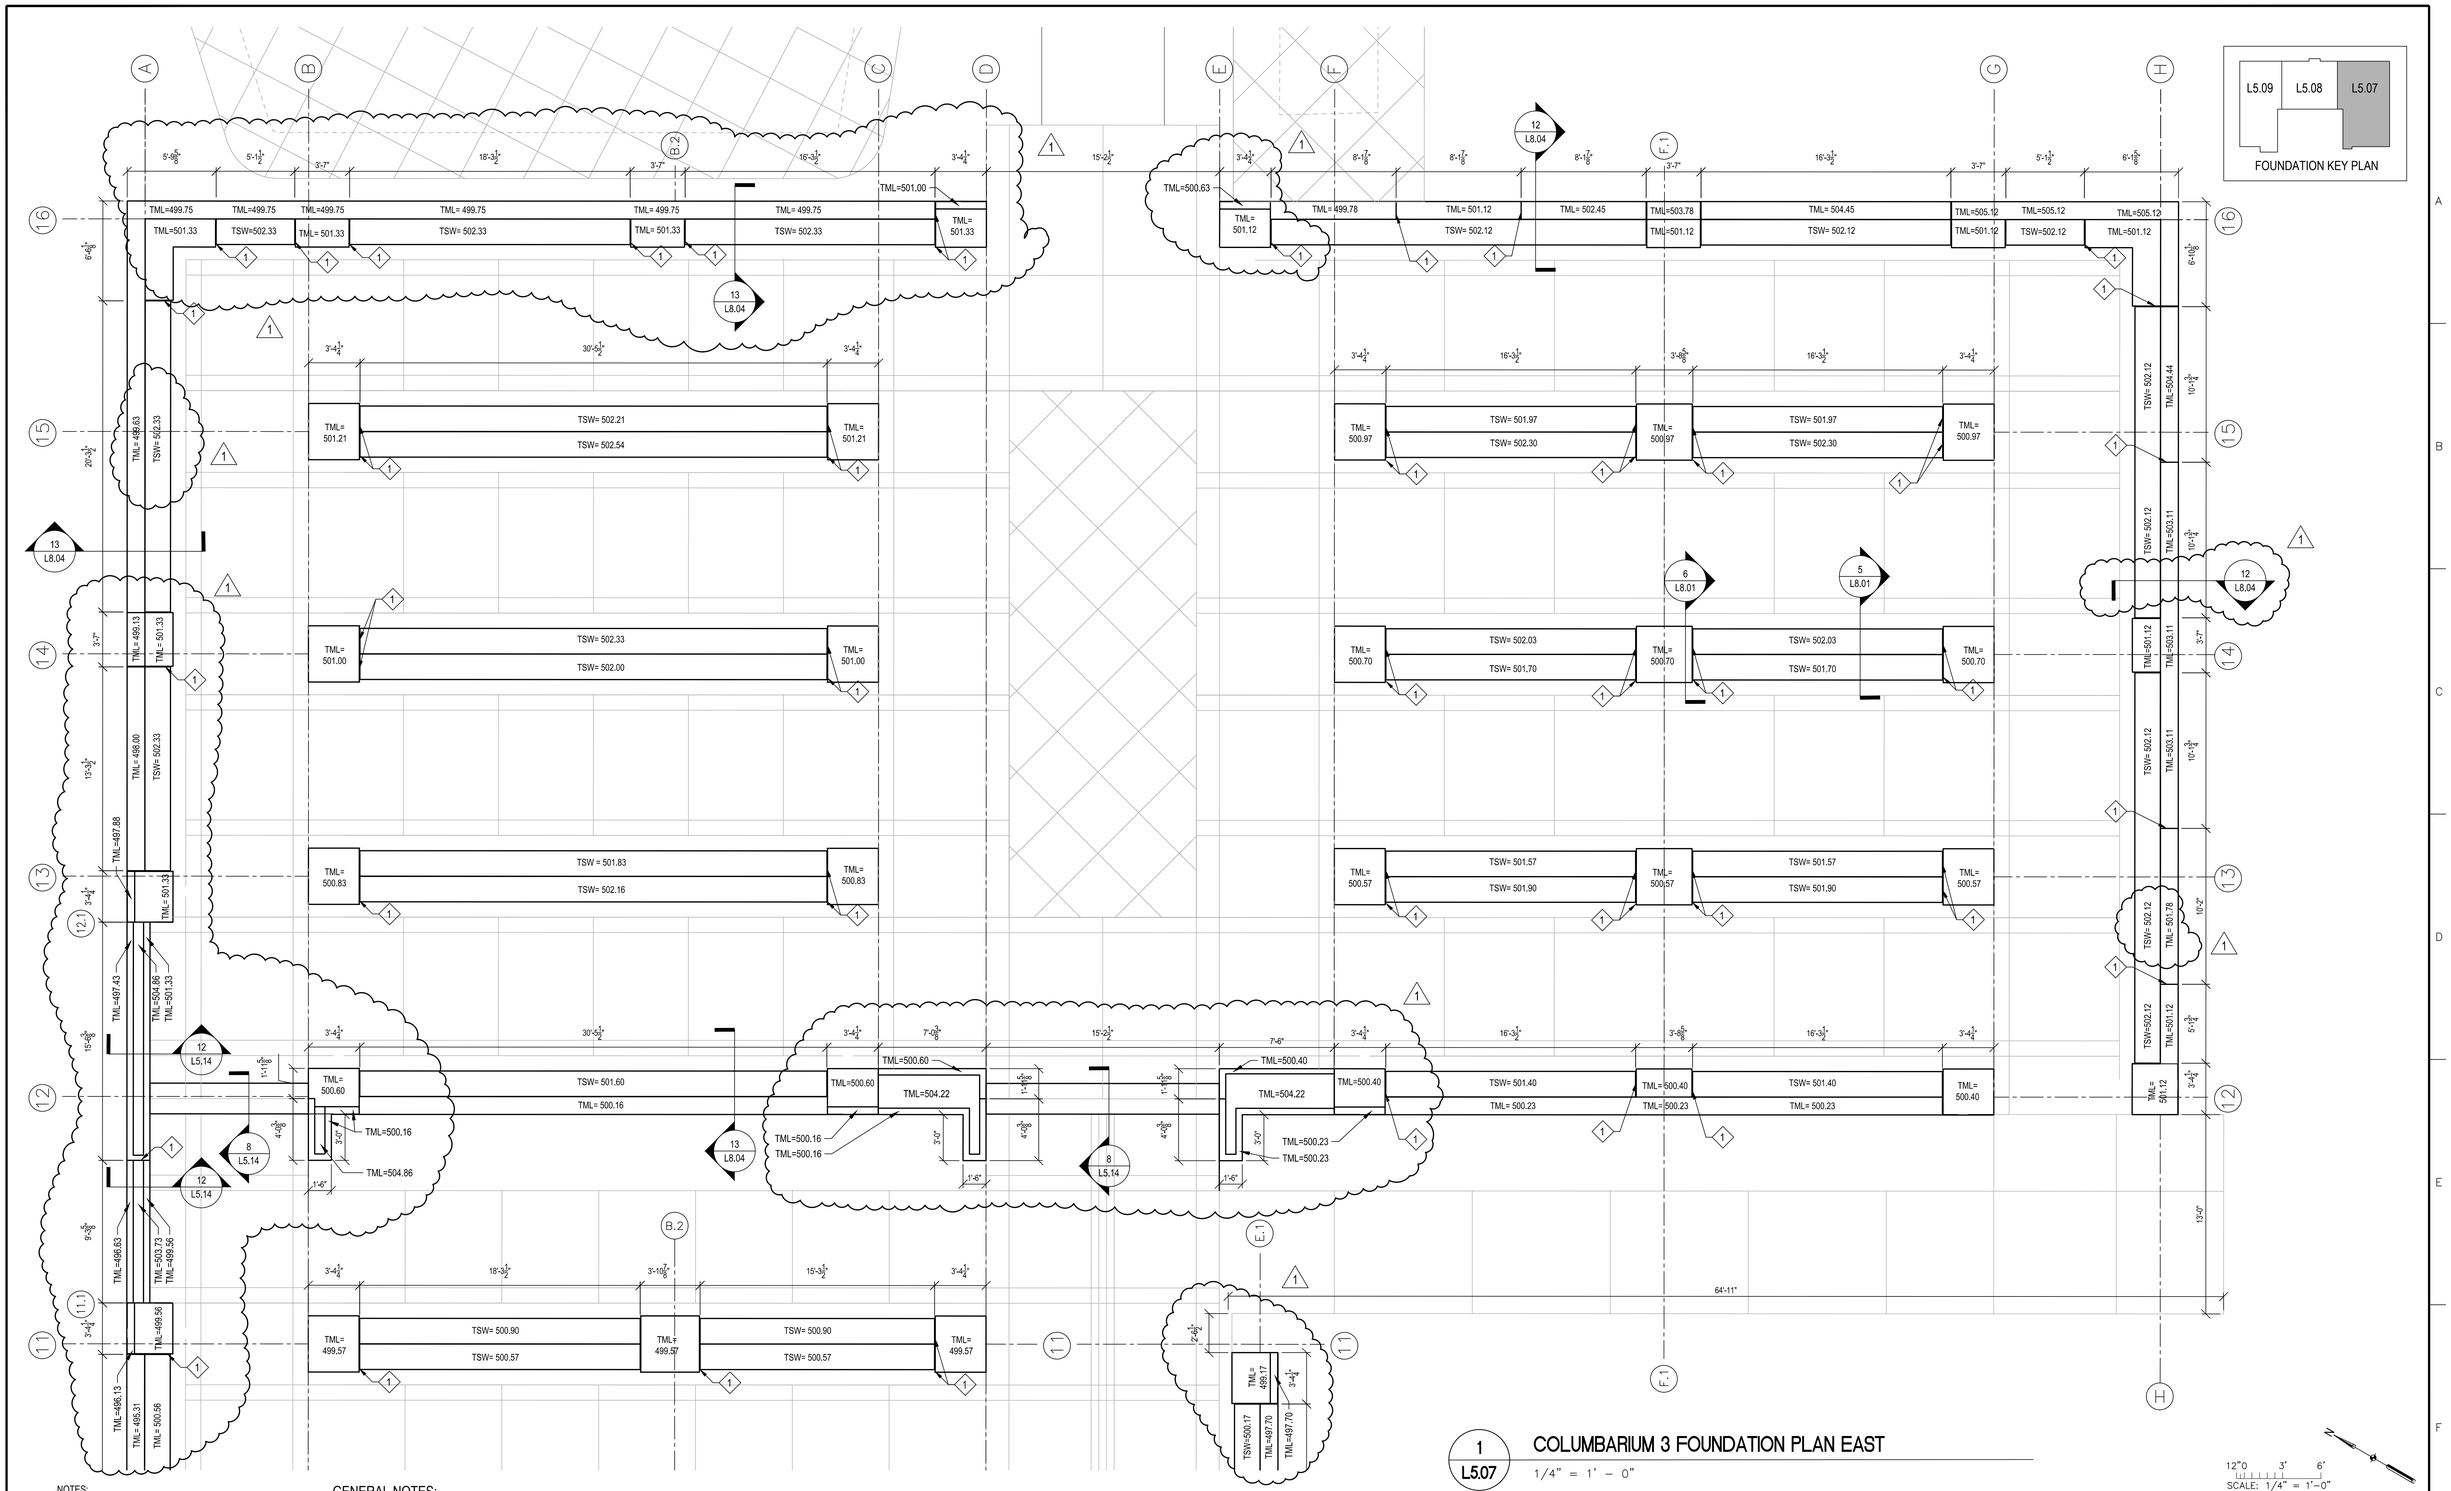

1 L5.07 COLUMBARIUM 3 FOUNDATION PLAN EAST

1/4" = 1' - 0"

SCALE: 1/4" = 1'-0"

NOTES:
1. SEE STRUCTURAL DRAWINGS FOR HORIZONTAL LAYOUT RELATIVE TO REFERENCE GRID.
2. SEE STRUCTURAL DRAWINGS FOR BOTTOM OF FOOTING ELEVATIONS.

GENERAL NOTES:

TSW = TOP OF STEM WALL ELEVATION
TML = TOP OF MASONRY LEDGE ELEVATION

KEYNOTES:

1. CHANGE OF TSW AND/ OR TML
2. 1/2" EXPANSION JOINT

Amendment 4	1	11.11.2011
Revisions:		Date

CONSULTANTS:

Anderson Engineering of Minnesota, LLC
13605 1st AVENUE NORTH, SUITE 100, PLYMOUTH, MN 55441
TEL (763) 412-4000 FAX (763) 412-4090

Aqua Engineering, Inc.
Innovative Water Solutions
4803 Innovation Drive
Fort Collins, Colorado 80525
Phone (970) 229-9668
FAX (970) 226-3855

JJR
landscape architecture
planning
urban design
civil engineering
environmental science
JJR, LLC
110 MILLER AVENUE,
ANN ARBOR, MICHIGAN 48104
734.662.4457 T 734.662.0779 F
www.jjr-us.com

RUSHING
Engineering-Essentials-Delivery
BLACKBIRD

ALLEGIANCE GROUP, LLC

STATE OF MICHIGAN
HENRY L. BYMA
LANDSCAPE ARCHITECT
No. 1538
LICENSED LANDSCAPE ARCHITECT

ARCHITECT/ENGINEERS:

kpff Consulting Engineers
1601 Fifth Avenue, Suite 1600
Seattle, Washington 98101-3665
(206) 622-5822 Fax (206) 622-8130

Drawing Title: COLUMBARIUM 3 FOUNDATION PLAN EAST

Approved: Project Director

Project Title: TAHOMA NATIONAL CEMETERY PHASE 2 GRAVESITE DEVELOPMENT
18600 SE 240TH STREET, KENT WASHINGTON

Location: KENT, WASHINGTON

Date	Checked	Drawn
9-15-2011	CQ/PE	JS/JM

Project Number: 919PC2007
Drawing Reference Number: 102
Drawing Number: L5.07

Office of Construction and Facilities Management
Department of Veterans Affairs

VA FORM 08-6231