

GENERAL NOTES:



TSW = TOP OF STEM WALL ELEVATION
TML = TOP OF MASONRY LEDGE ELEVATION

KEYNOTES:

- 1 CHANGE OF TSW AND/ OR TML
- 2 1/2" EXPANSION JOINT

NOTES:


- NOTES:
1. SEE STRUCTURAL DRAWINGS FOR HORIZONTAL LAYOUT
RELATIVE TO REFERENCE GRID.
 2. SEE STRUCTURAL DRAWINGS FOR BOTTOM OF FOOTING
ELEVATIONS.

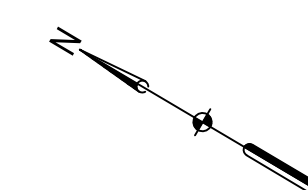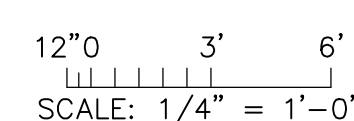

COLUMBARIUM 3 FOUNDATION PLAN MID

$$1/4'' = 1' - 0''$$

1
L5.08

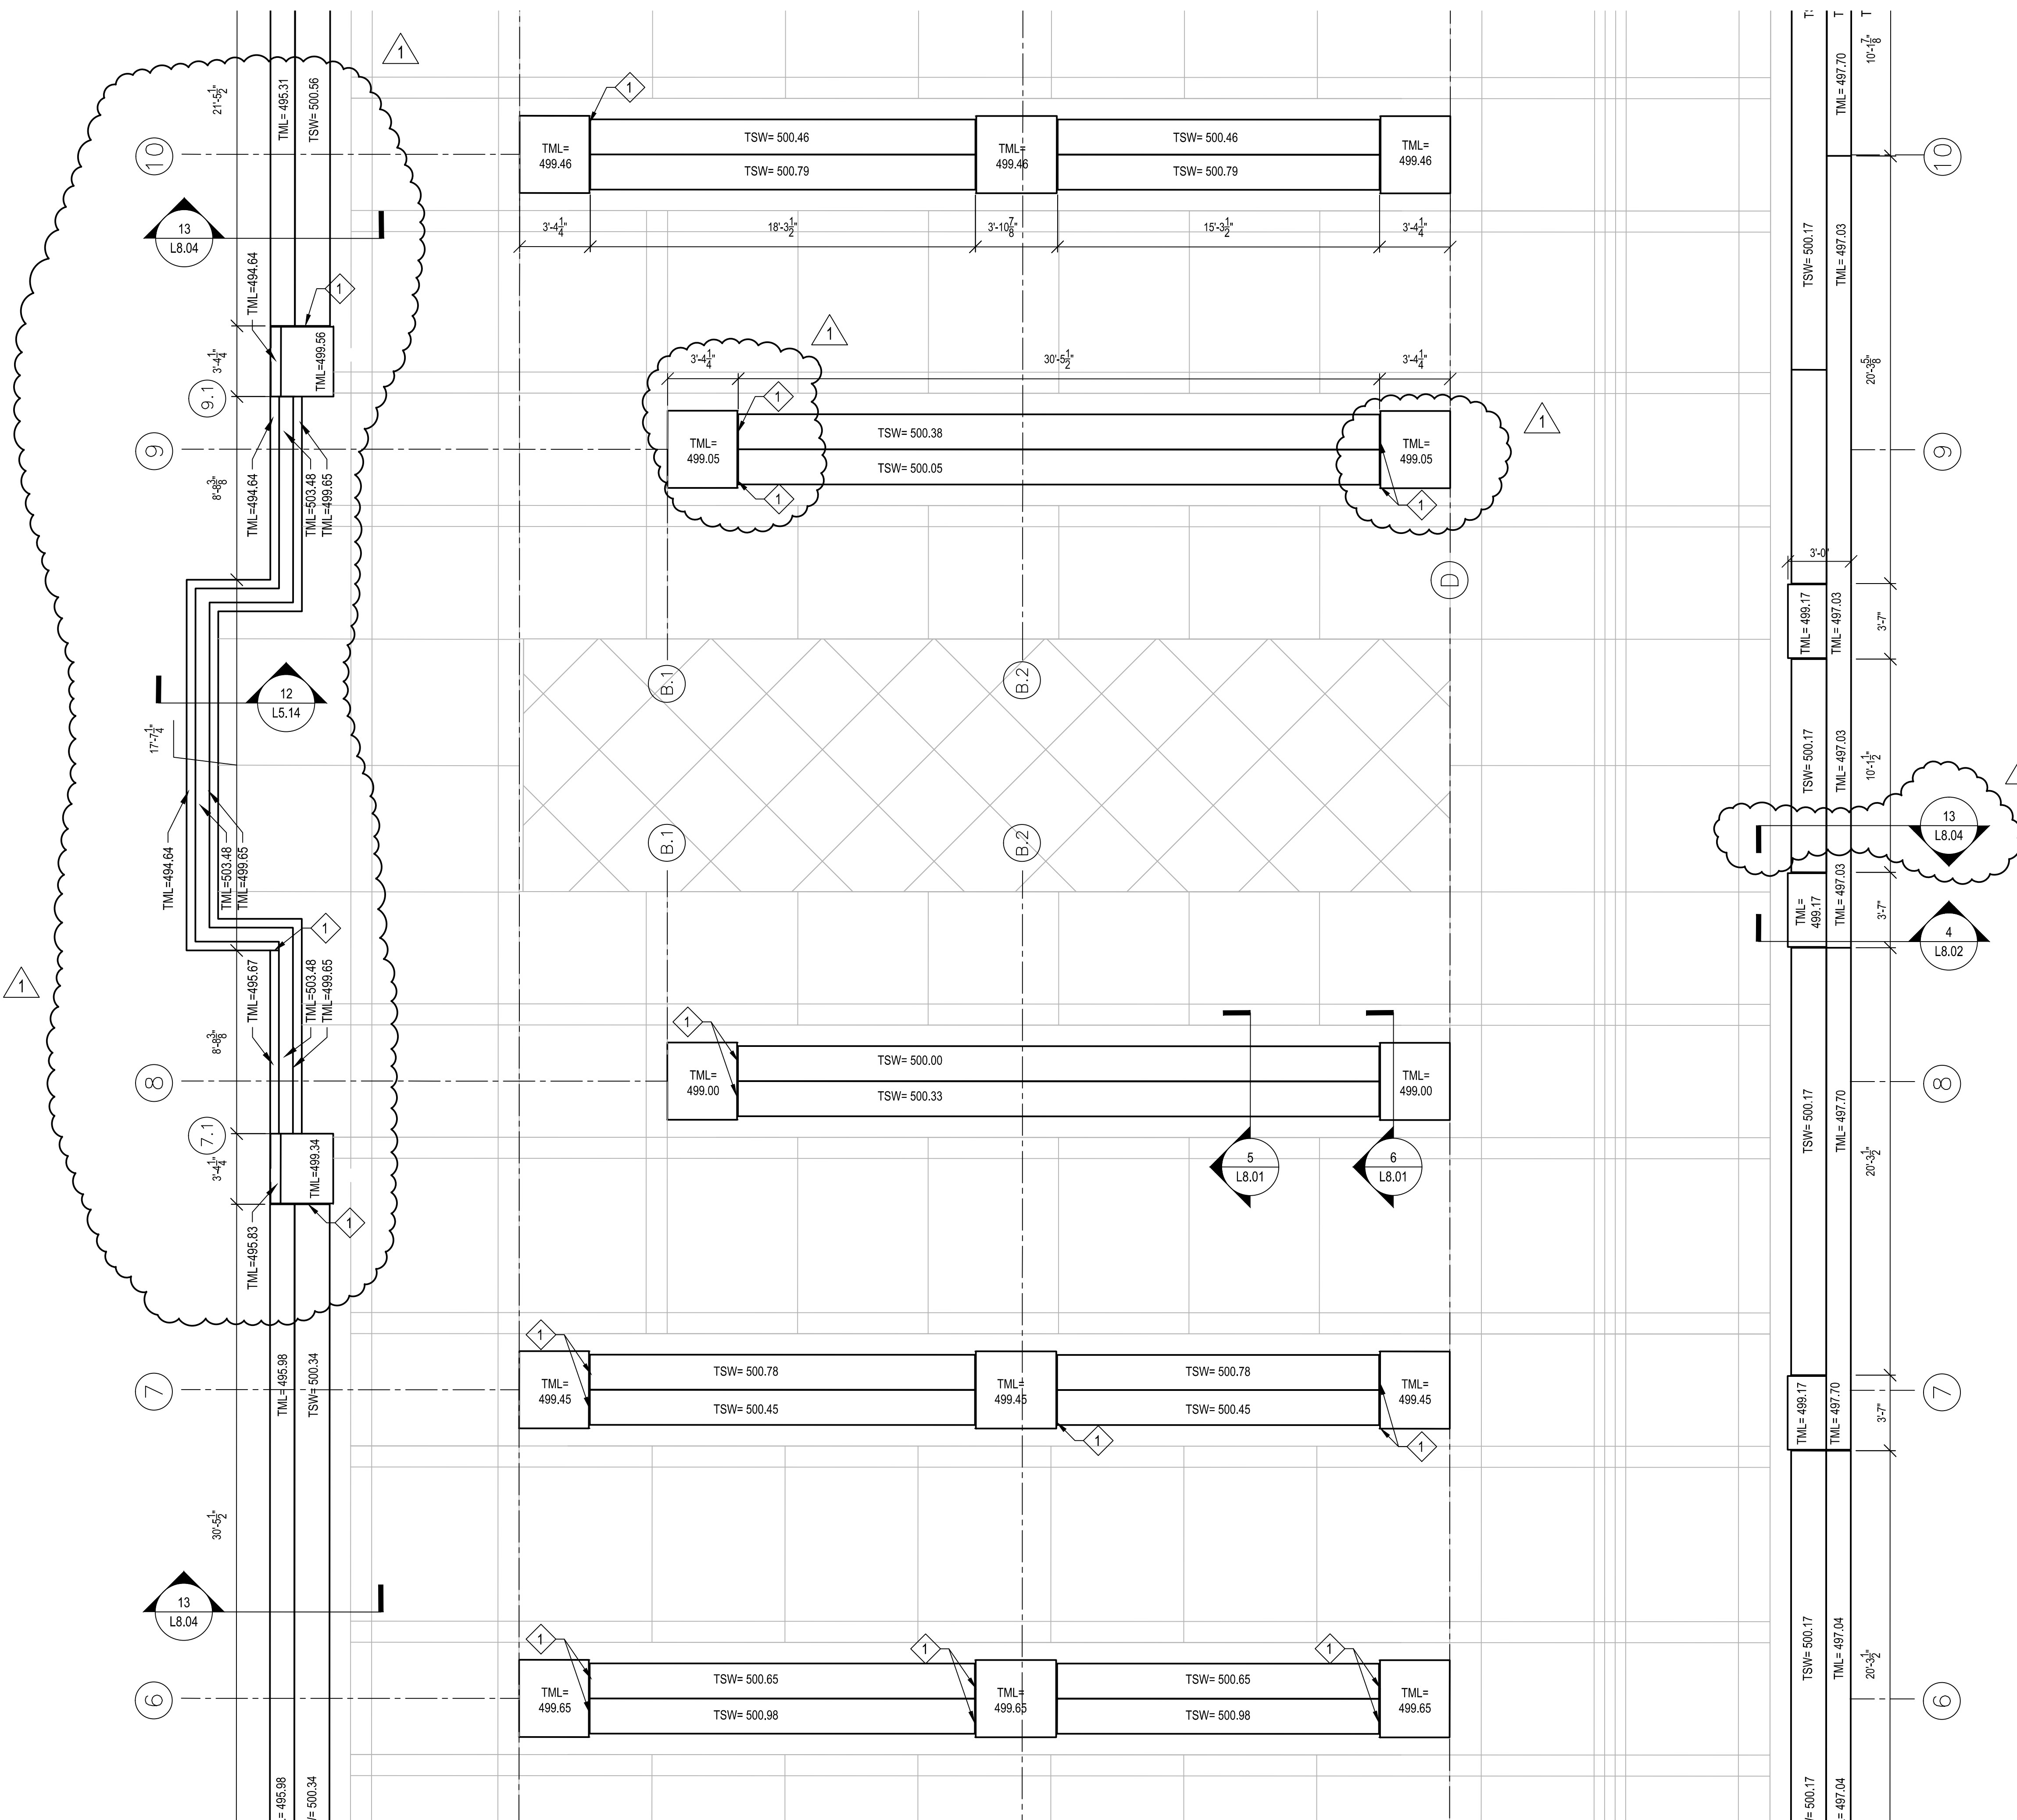

CONSULTANTS:

Anderson Engineering of Minnesota, LLC
13805 1st AVENUE NORTH, SUITE 100, PLYMOUTH, MN 55441
TEL (763) 412-4000 FAX (763) 412-4090

Aqua Engineering, Inc.
 *Innovative Water Solutions*
 4803 Innovation Drive
 Fort Collins, Colorado 80525
 Phone (970) 229-9668
 FAX (970) 226-3855

JJR landscape architecture
planning
urban design
civil engineering
environmental science


JJR, LLC
110 MILLER AVENUE
ANN ARBOR, MICH
734.662.4457 T 734.
www.jjr-us.com



RUSHING
Engineering - Essentials - Delivery
BLACKBIRD



ALLEGIANCE
GROUP, LLC

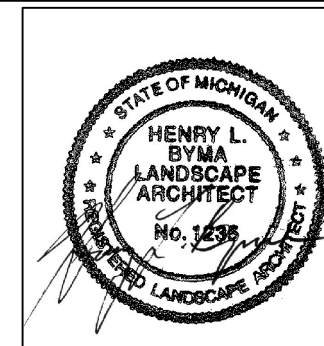

ARCHITECT/ENGINEERS:

kpff Consulting Engineers
1601 Fifth Avenue, Suite 1600
Seattle, Washington 98101-3665
(206) 622-5822 Fax (206) 622-8130

Drawing Title

COLUMBARIUM 3 FOUNDATION
PLAN MID

Approved: Project Director

Project Title	TAHOMA NATIONAL CEMETERY PHASE 2 GRAVESITE DEVELOPMENT 18600 SE 240TH STREET, KENT WASHINGTON
---------------	---

Location	KENT, WASHINGTON

Date _____

Checked	
---------	--

Drawn	
-------	--

T	Project Number 919PC2007
	Drawing Reference 102

	Number
	Drawing Number

Office of
Construction
and Facilities
Management



VA FORM 08-6231