


Scale: 1/4" = 1'-0"

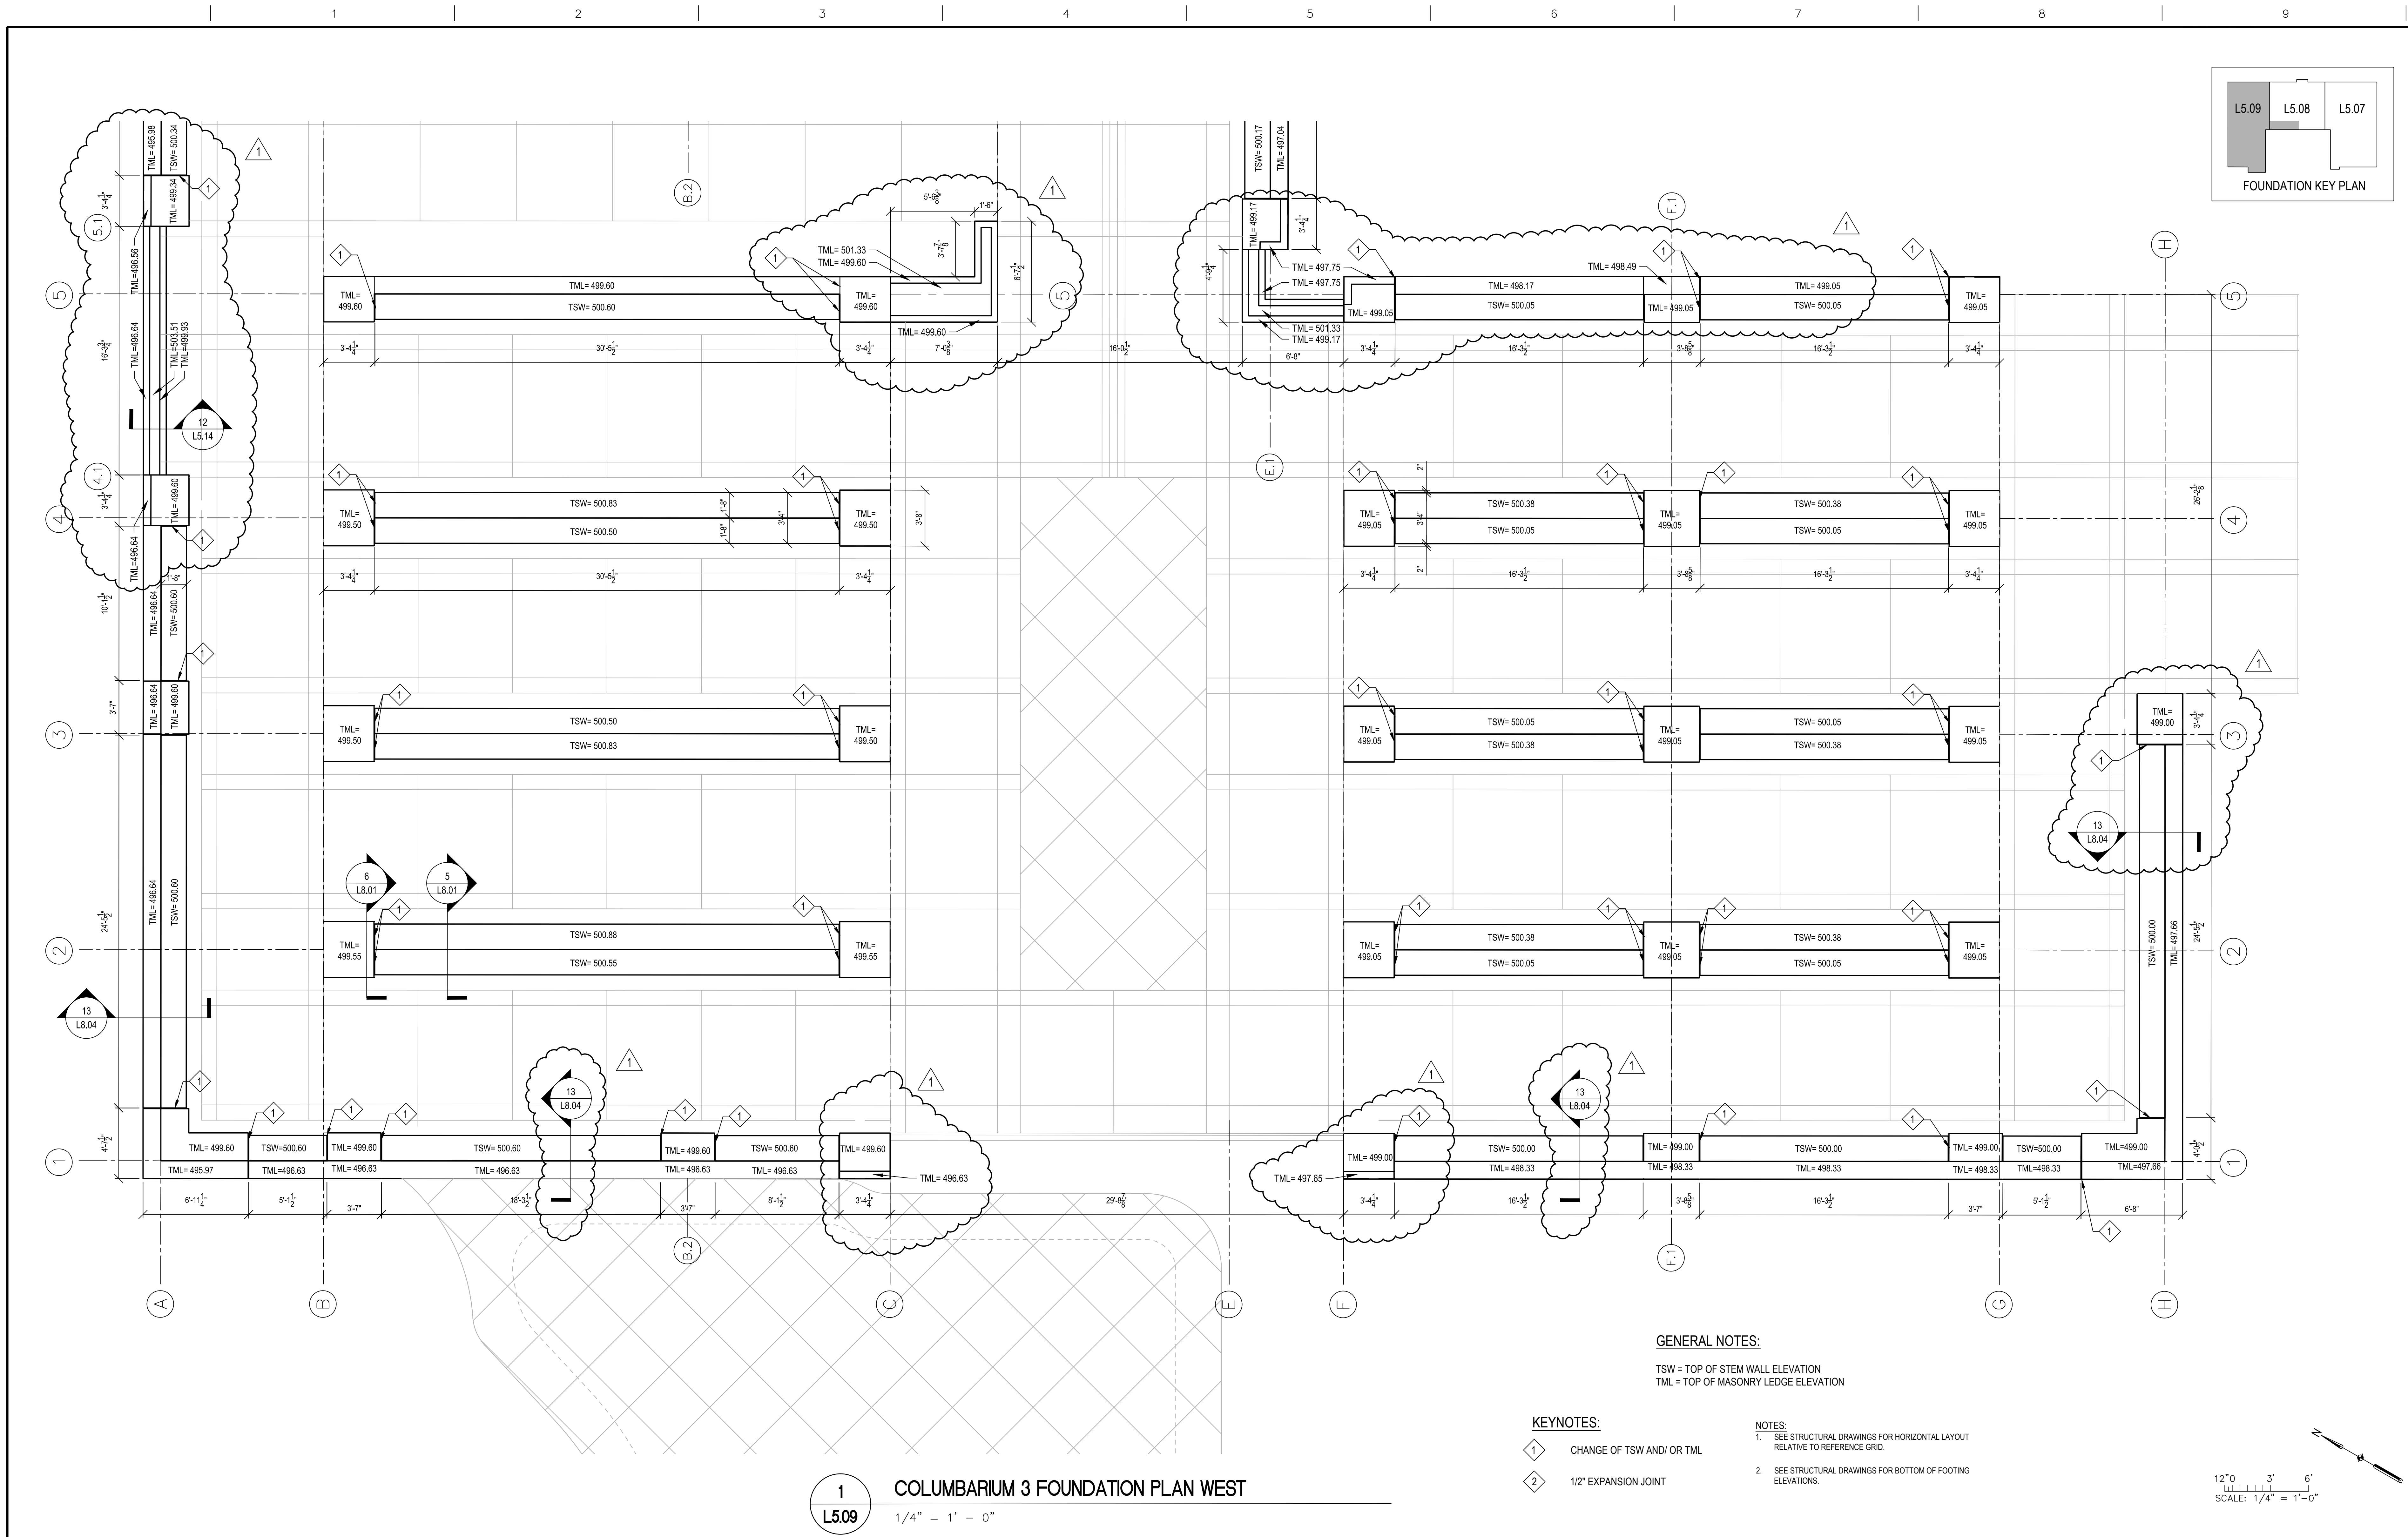

1  
L5.09  
COLUMBARIUM 3 FOUNDATION PLAN WEST  
1/4" = 1' - 0"

<b>CONSULTANTS:</b>  Anderson Engineering of Minnesota, LLC 13805 144 AVENUE NORTH, SUITE 100, PLYMOUTH, MN 55441 TEL (763) 412-4000 FAX (763) 412-4000		<b>Aqua Engineering, Inc.</b> Innovative Water Solutions 4803 Innovation Drive Fort Collins, Colorado 90525 Phone (970) 228-8668 FAX (970) 228-3855		<b>JJR</b> landscape architecture interior design civil engineering environmental science JJR, LLC 110 MILLER AVENUE ANN ARBOR, MICHIGAN 48104 734.662.4457 T 734.662.0779 F www.jjr-us.com		<b>RUSHING</b> Engineering - Essentials - Delivery <b>BLACKBIRD</b>		<b>ALLEGIANCE GROUP, LLC</b>		<b>ARCHITECT/ENGINEERS:</b>  <b>kpff</b> Consulting Engineers 1601 Fifth Avenue, Suite 1600 Seattle, Washington 98101-3665 (206) 622-5822 Fax (206) 622-8130		<b>Drawing Title</b> COLUMBARIUM 3 FOUNDATION PLAN WEST  <b>Approved Project Director</b>		<b>Project Title</b> TAHOMA NATIONAL CEMETERY PHASE 2 GRAVESITE DEVELOPMENT 18600 SE 240TH STREET, KENT WASHINGTON  <b>Location</b> KENT, WASHINGTON  <b>Date</b> 9-15-2011  <b>Checked</b> CQ/PE  <b>Drawn</b> JS/JM		<b>Project Number</b> 919PC2007  <b>Drawing Reference Number</b> 104  <b>Drawing Number</b> L5.09		<b>Office of Construction and Facilities Management</b>  Department of Veterans Affairs	
---	--	--	--	--	--	---	--	------------------------------	--	---	--	---	--	--	--	--	--	---	--