



Notes: 1. SEE STRUCTURAL FOR FOOTING ELEVATION DEPTHS.
2. SEE SHEETS L5.07 THRU L5.09 FOR TOP OF STEM WALL AND MASONRY LEDGE ELEVATIONS.



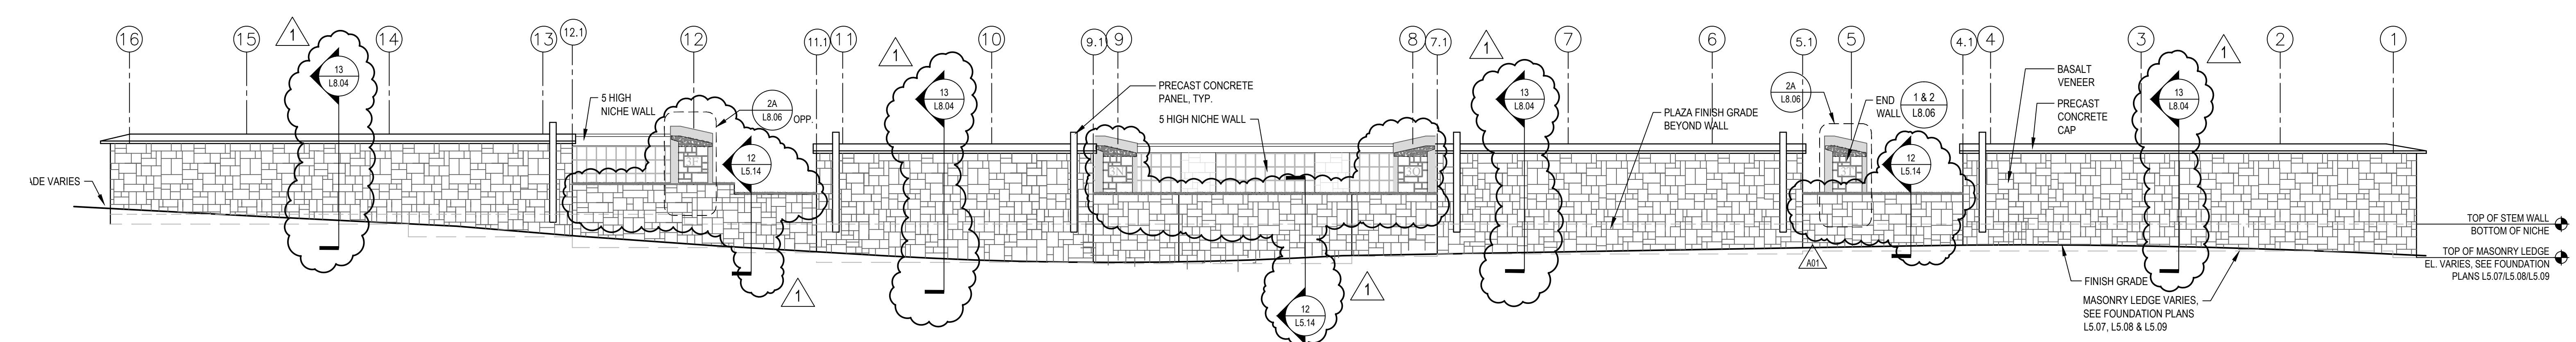


1 COLUMBARIUM 3 NORTH EXTERIOR ELEVATION (EXTERIOR SIDE)
ELEVATION
1/8" = 1'-0"

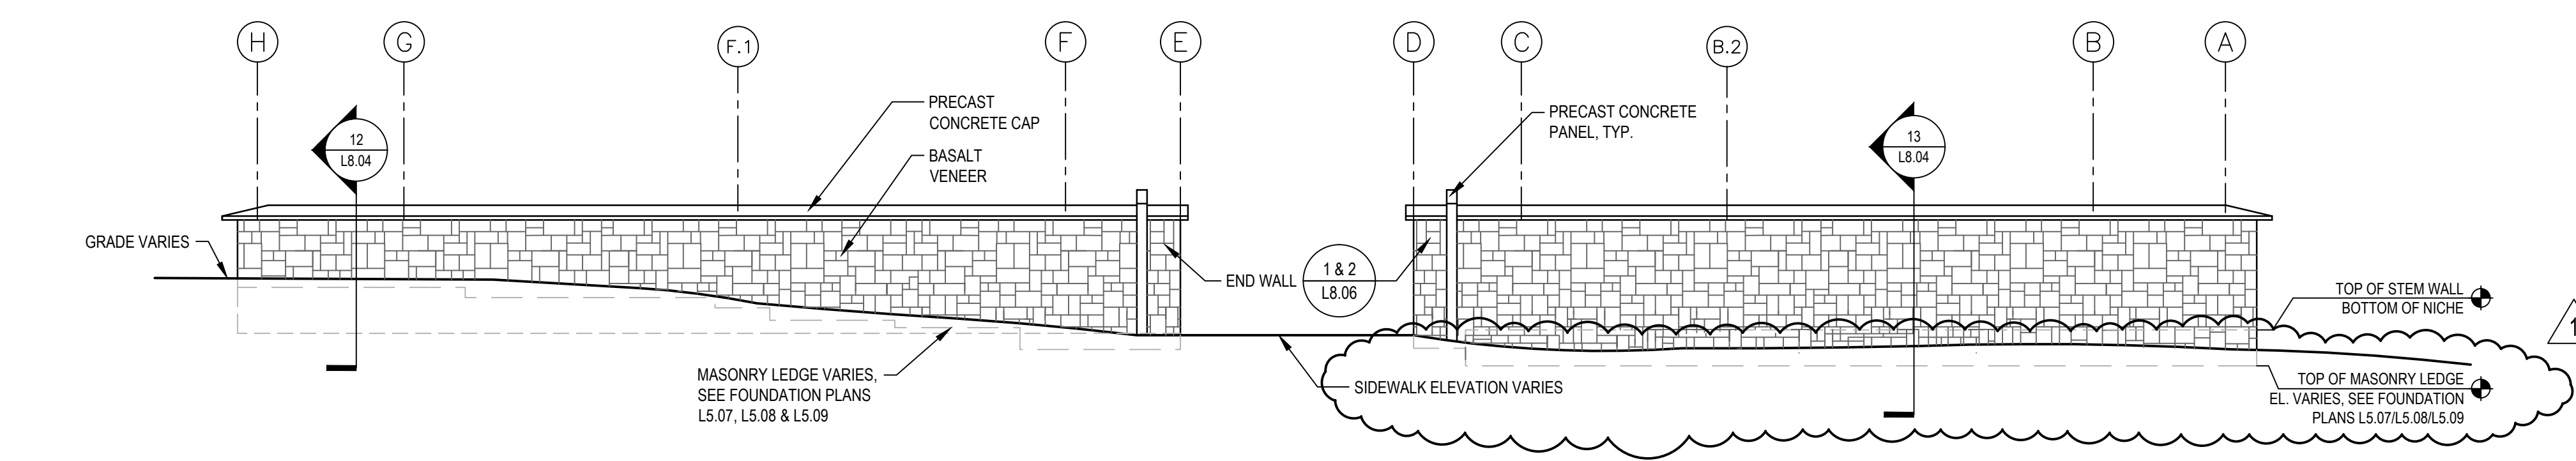


2 COLUMBARIUM 3 EAST EXTERIOR ELEVATION (EXTERIOR SIDE)
ELEVATION
1/8" = 1'-0"

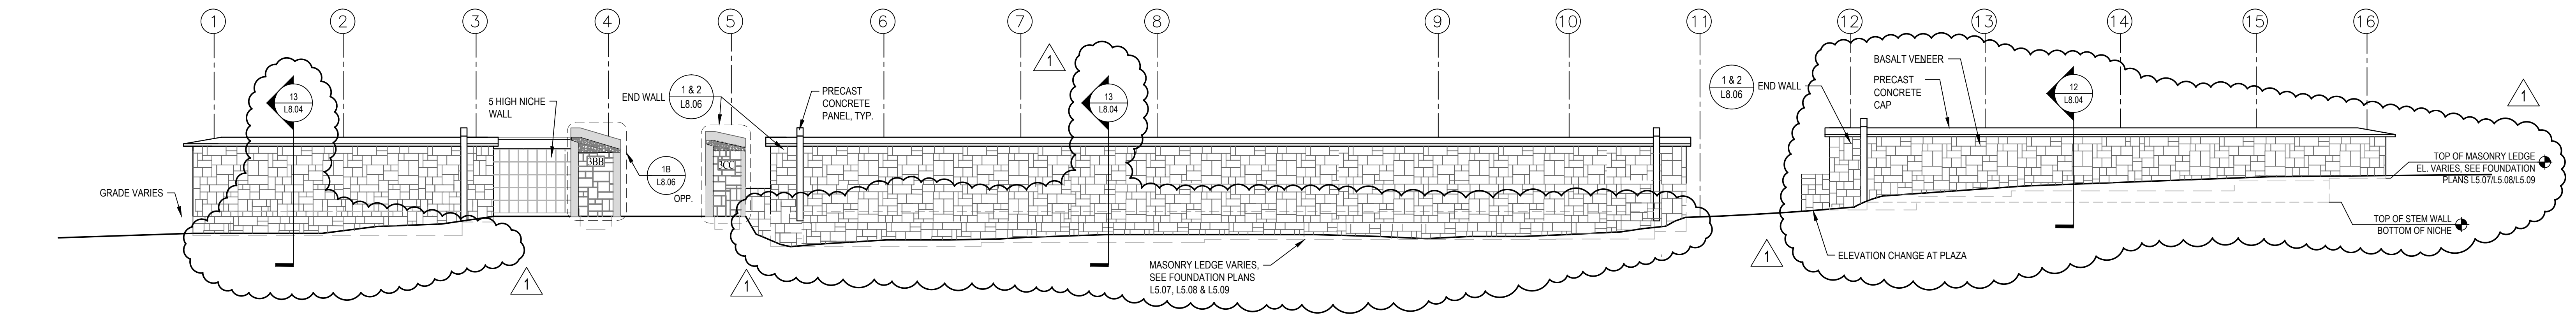

3 COLUMBARIUM 3 SOUTH EXTERIOR ELEVATION (EXTERIOR SIDE)
ELEVATION
1/8" = 1'-0"

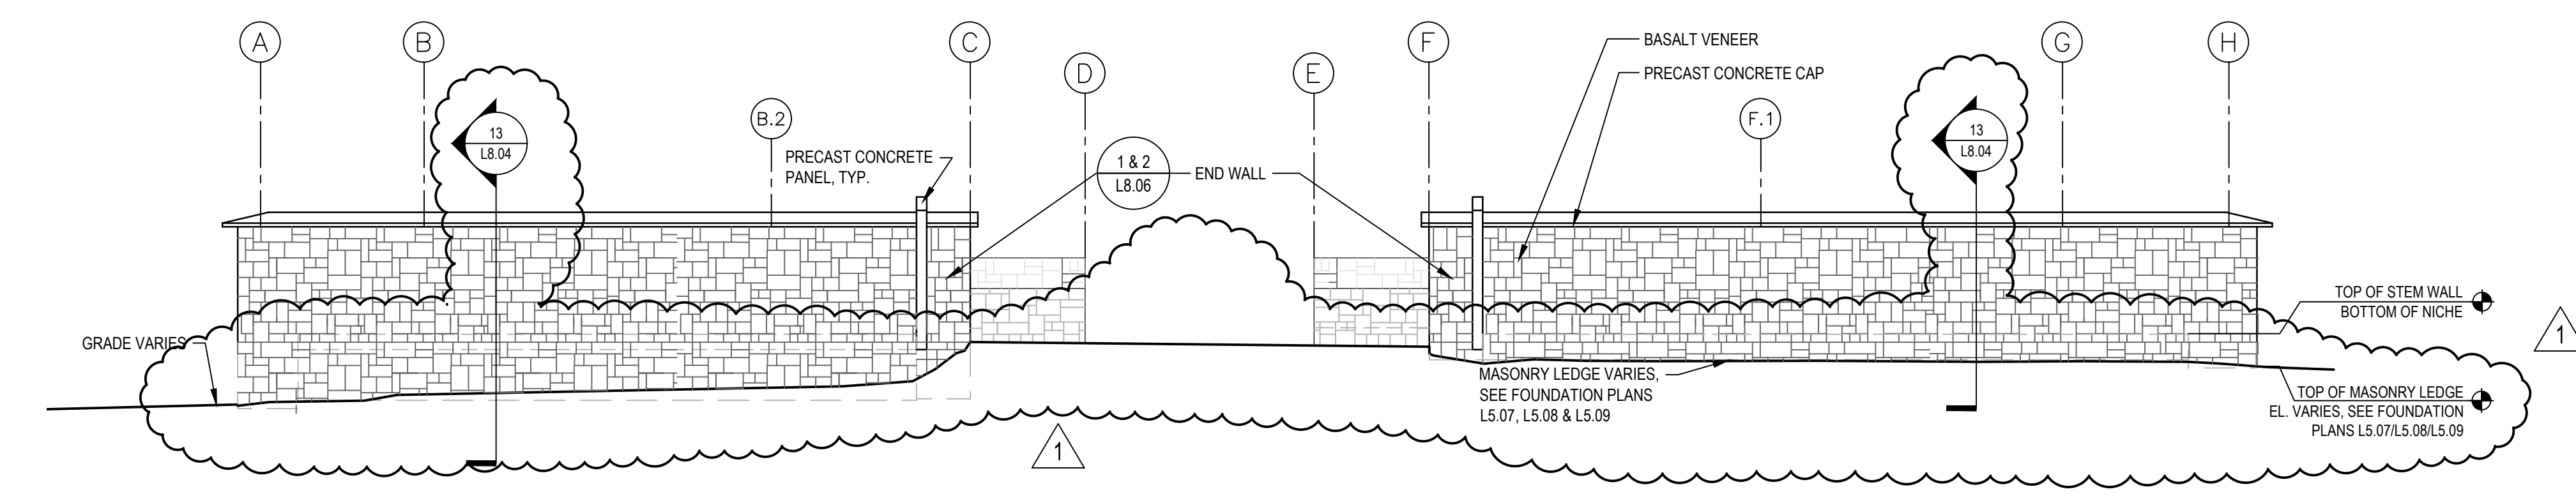

4 COLUMBARIUM 3 WEST EXTERIOR ELEVATION (EXTERIOR SIDE)
ELEVATION
1/8" = 1'-0"

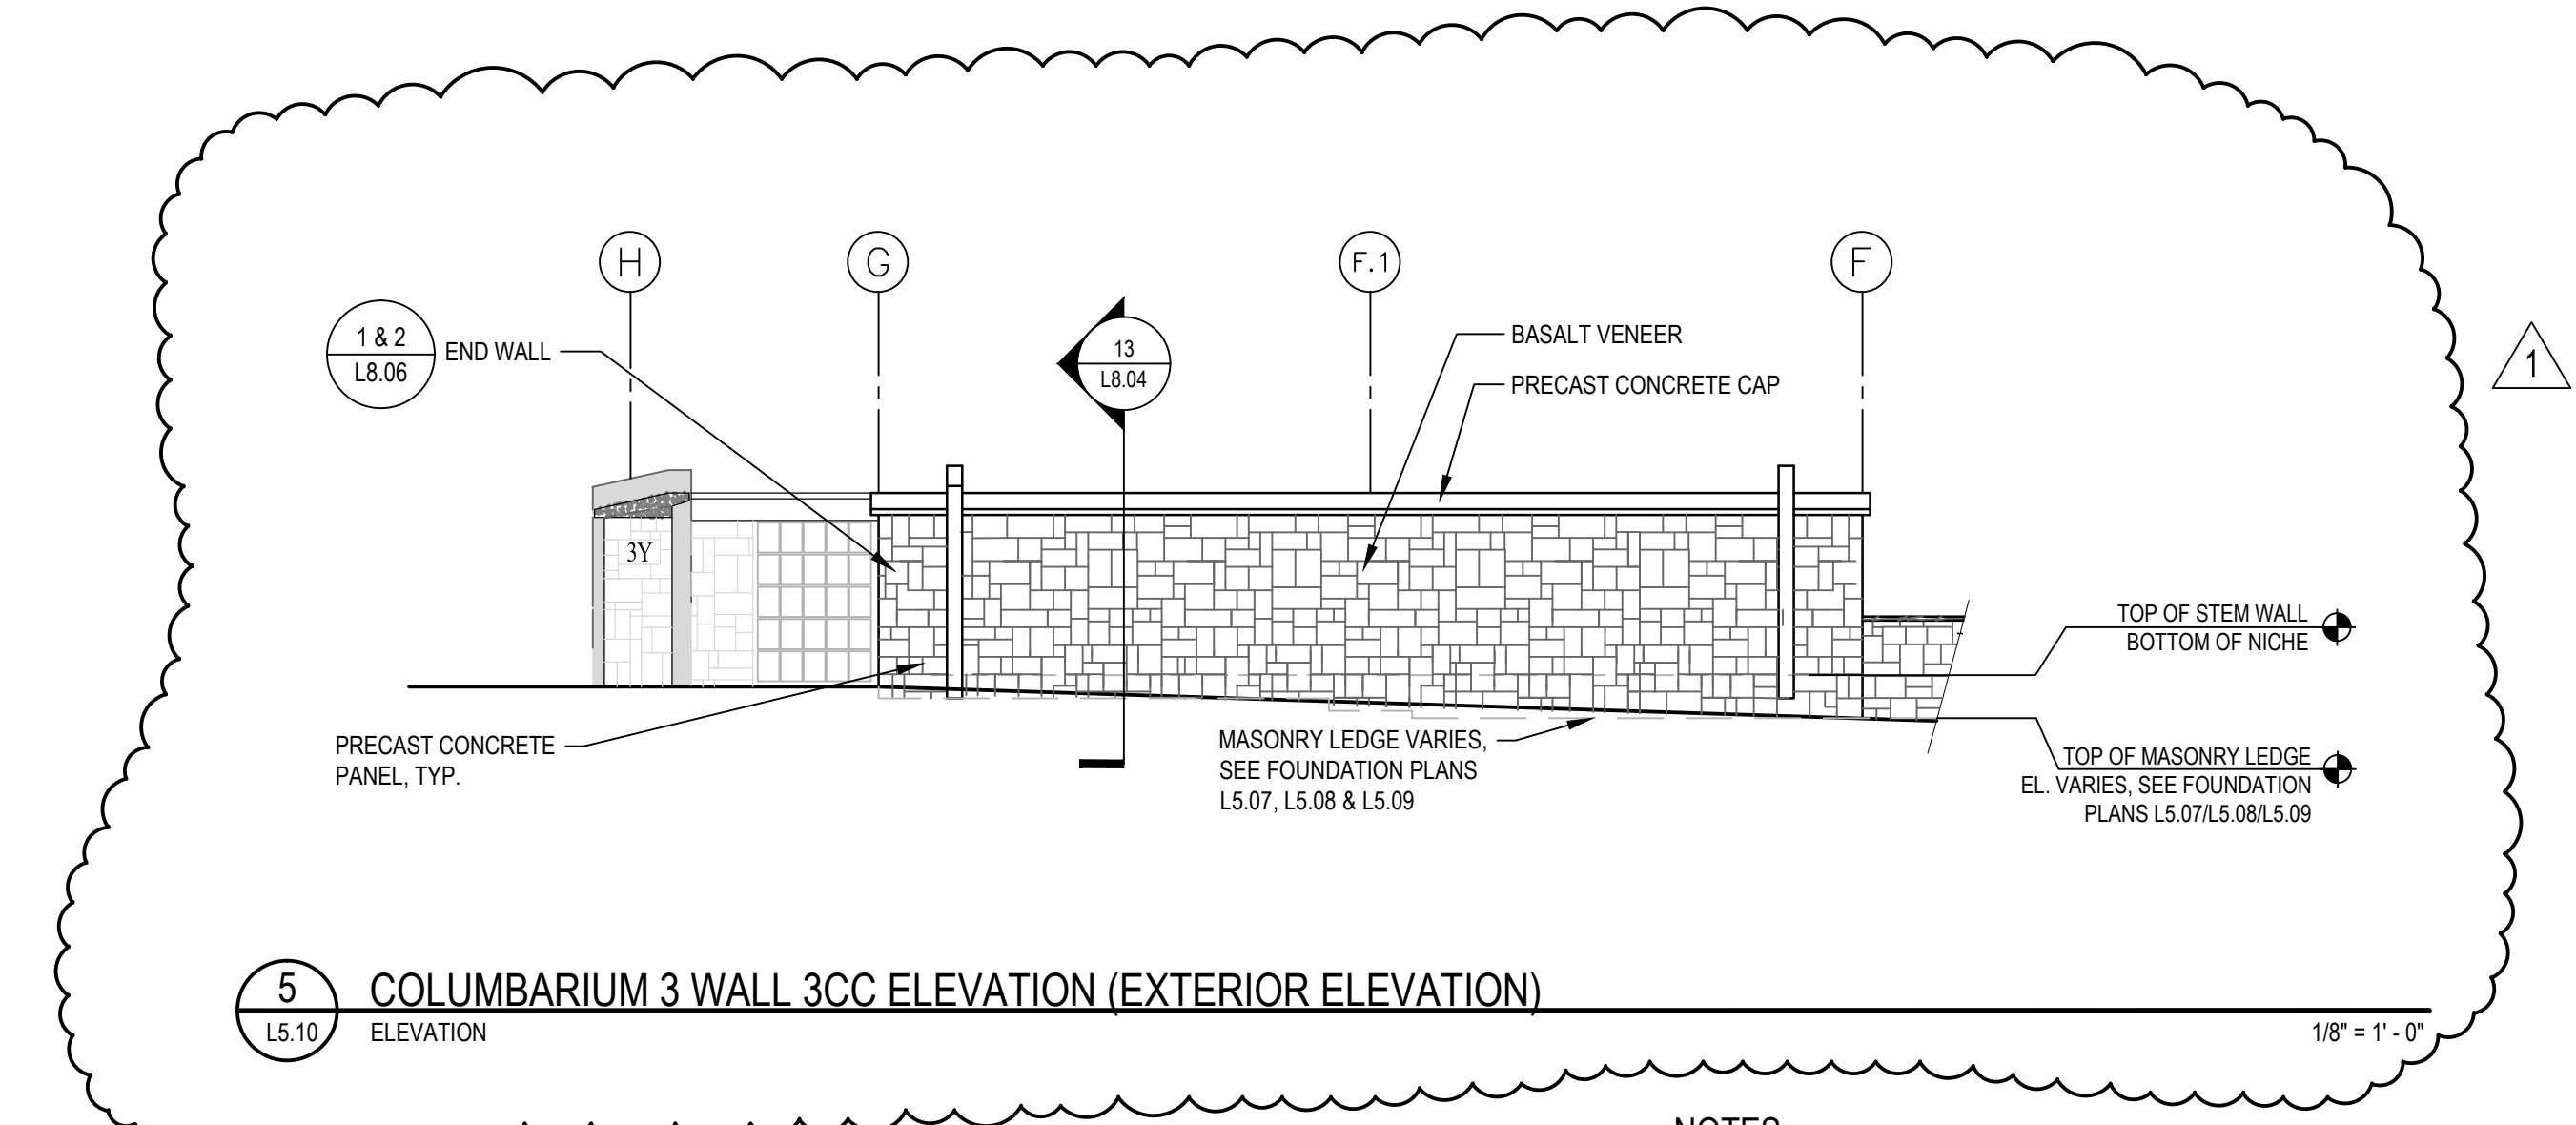

5 COLUMBARIUM 3 WALL 3CC ELEVATION (EXTERIOR ELEVATION)
ELEVATION
1/8" = 1'-0"

NOTES:
1. SEE STRUCTURAL FOR FOOTING ELEVATION DEPTHS.
2. SEE SHEETS L5.07 THRU L5.09 FOR TOP OF STEM WALL AND MASONRY LEDGE ELEVATIONS.

--	--	