

6  
L8.02

6 PERIMETER PRECAST CONCRETE CAP

2, 3 & 4  
L8.04

PERIMETER PRECAST CONCRETE PANEL, BEYOND

1  
L8.05

NICHE COVER PLATE

1, 2, 3  
L8.03

TYP. PRECAST CONCRETE NICHE UNIT

5  
L8.03

COLUMBARIUM ROW MARKER SAND  
BLASTED INTO PRECAST CONCRETE PANEL

1/4" HOLE CAST-IN-PLACE VERTICAL & PLUMB, TYP.

REINFORCED CONCRETE FOUNDATION (SEE STRUCTURAL)

8  
L8.04

GRAVEL FLOWER STRIP WITH UNDERDRAIN & SIDEWALK EDGE

TOP OF STEM WALL  
EL. AS PER FOUNDATION PLANS

8  
L1.28

CONCRETE SIDEWALK

CAST-IN-PLACE CONCRETE STEM WALL  
EXPOSED FOUNDATION SURFACES TO BE SACK RUBBED FINISH

REFERENCE LINE

CONTINUOUS EPDM FLASHING  
UNDER MORTAR, EXTEND 8" OVER TOP OF COLUMBARIUM UNIT AND 8" DOWN FACE OF CMU

1/2" MORTAR JOINT

2" AIR SPACE

7/8" REINFORCED CMU WALL,  
GROUT ALL CELLS SOLID

STONE VENEER

STAINLESS STEEL ANCHOR BOLTS,  
LOCATED AND SPACED PER PRECAST COLUMBARIUM MANUF. SPECIFICATIONS AND SHOP DRAWINGS

CONNECTION DETAILS, SEE SHEET L8.06

CELL VENT, TYP. 14  
L8.04


OPEN VERTICAL JOINT IN STONE, 4 ± O.C.

TOP OF MASONRY LEDGE  
EL. AS PER FOUNDATION PLANS

FINISH GRADE

3" MIN  
4" MAX.

5 TYPICAL PERIMETER WALL UNIT SECTION  
L8.02 SECTION

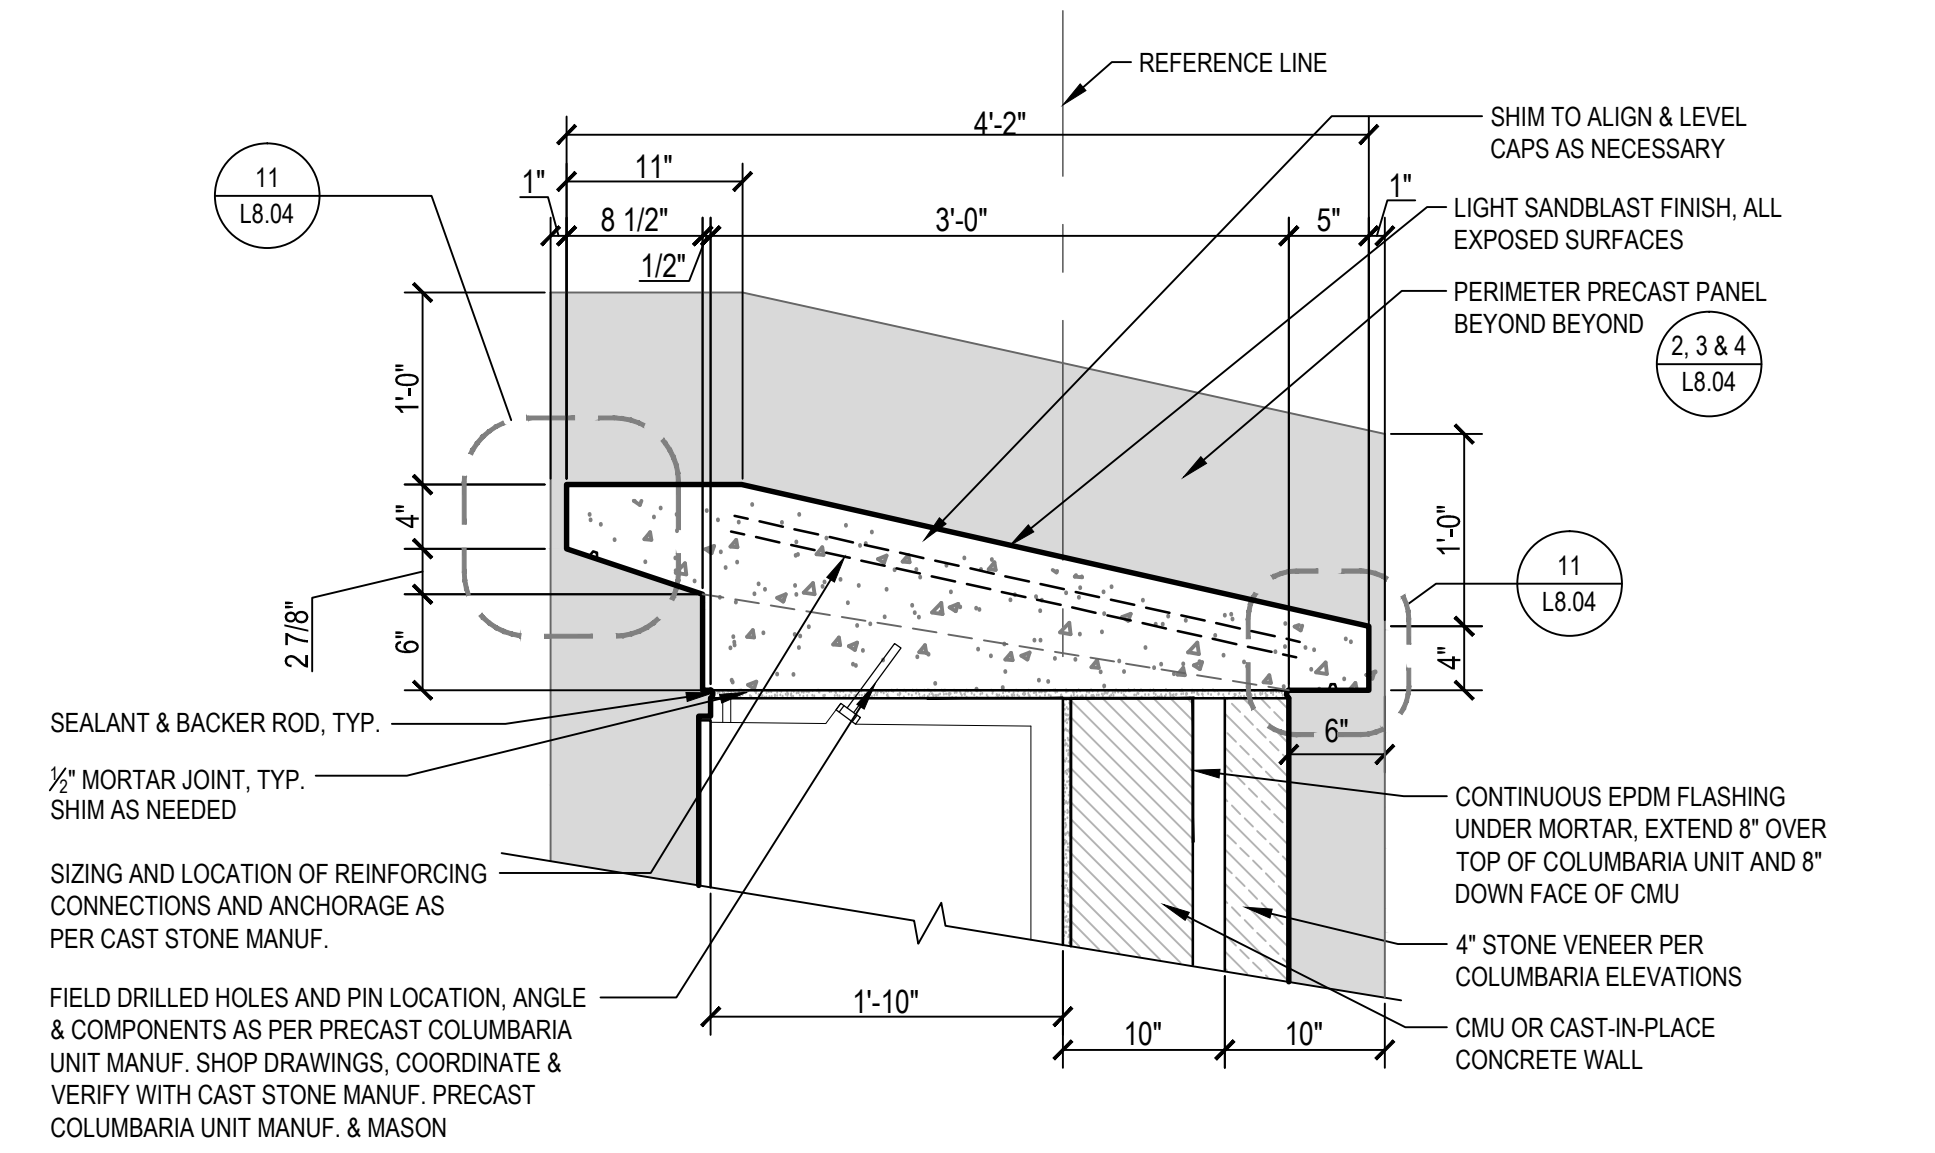

6 PERIMETER PRECAST CONCRETE CAP  
1.8.02 SECTION



Department of