


1 L10.03 MEMORIAL WALL MID-SECTION PLAN
ELEVATION

1" = 1'-0"

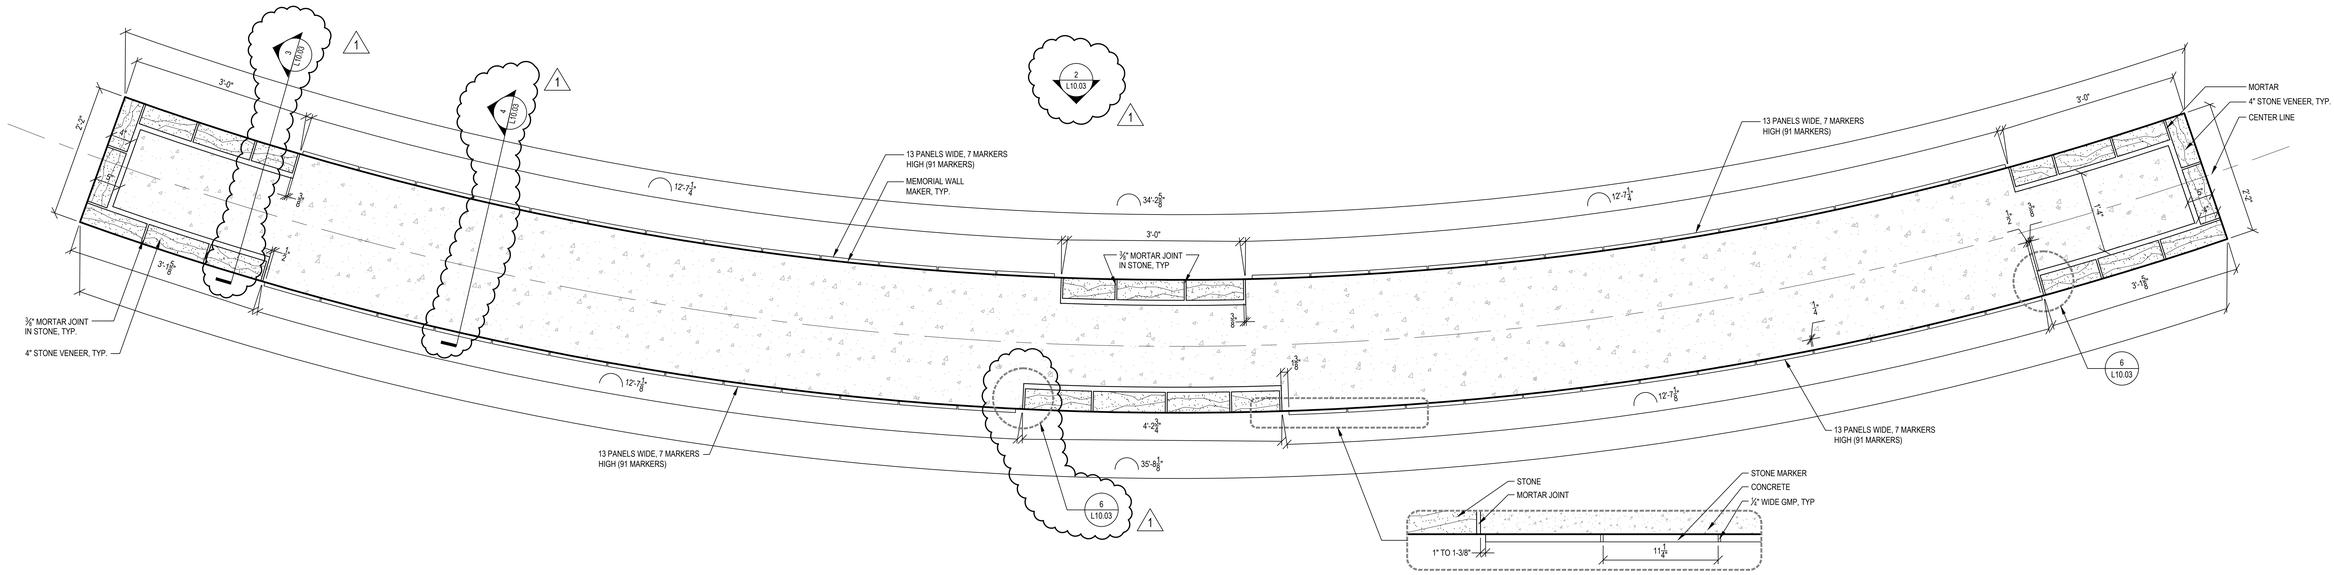


2 L10.03 MEMORIAL WALL ELEVATION
ELEVATION

1/2"=1'-0"




3 L10.03 MEMORIAL WALL COLUMN SECTION
SECTION

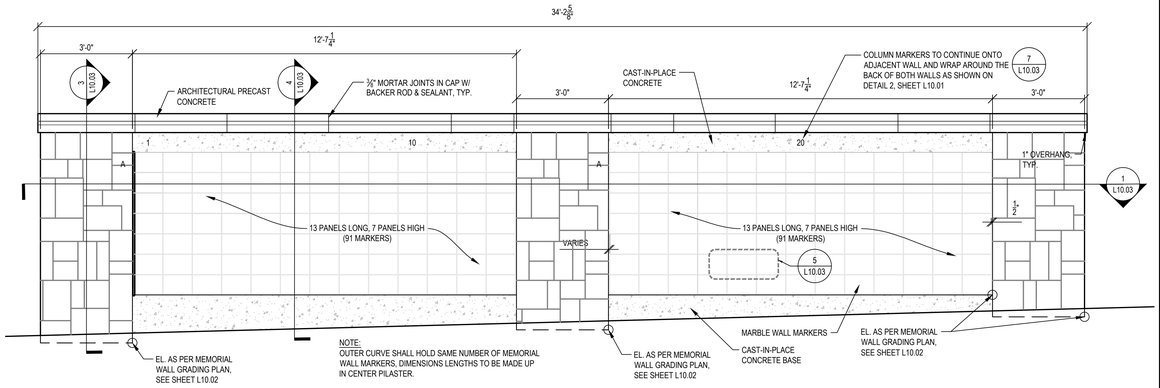1" = 1'-0"




4 L10.03 MEMORIAL WALL SECTION
SECTION

1" = 1'-0"




NOTES:
1. THE MAXIMUM DIMENSIONAL TOLERANCES FOR THE MARBLE MARKERS SHALL BE AS DEFINED IN THE TECHNICAL SPECIFICATIONS.

5 L10.03 MEMORIAL WALL MARKER
ELEVATION

1/2" = 1'-0"

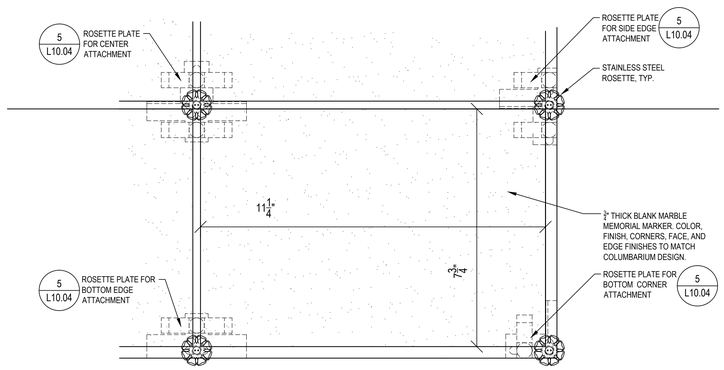


6 L10.03 EDGE AT STONE COLUMN
SECTION

2"=1'-0"

ROW MARKER
(INCISED INTO STONE VENEER & PAINTED WITH LITHOCHROME PAINT)

A 2¾"

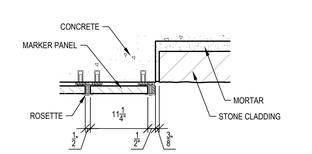COLUMN MARKER
(INCISED INTO PRECAST CONCRETE & PAINTED WITH LITHOCHROME PAINT)

10 2¾"

NOTES:
1. FONT TO BE TIMES NEW ROMAN.
2. ALL CHARACTERS TO BE SAND BLASTED TO A DEPTH OF ¼" MINIMUM.
3. LITHOCHROME PAINT TO BE PAINTED WITHIN THE INCISED LETTERS & NUMBERS.
4. SEE ELEVATIONS FOR MARKER LOCATION.

7 L10.03 ROW AND COLUMN MARKERS
SECTION

1"=1'-0"

| Revisions: | Date |
|---|---|
| Amendment 4 1 | 11.11.2011 |

CONSULTANTS:

Anderson Engineering of Minnesota, LLC
13605 1st AVENUE NORTH, SUITE 100, PLYMOUTH, MN 55441
TEL (763) 412-4000 FAX (763) 412-4090

Aqua Engineering, Inc.
*Innovative Water Solutions*
4803 Innovation Drive
Fort Collins, Colorado 80525
Phone (970) 229-9668
FAX (970) 226-3855

JJR
landscape architecture
planning
urban design
civil engineering
environmental science
JJR, LLC
110 MILLER AVENUE,
ANN ARBOR, MICHIGAN 48104
734.662.4457 T 734.662.0779 F
www.jjr-us.com

RUSHING
Engineering-Essentials-Delivery
BLACKBIRD

ALLEGIANCE GROUP, LLC

STATE OF MICHIGAN
KENNETH J. BYMA
LANDSCAPE ARCHITECT
No. 1458
REGISTERED LANDSCAPE ARCHITECT

ARCHITECT/ENGINEERS:

kpff Consulting Engineers
1601 Fifth Avenue, Suite 1600
Seattle, Washington 98101-3665
(206) 622-5822 Fax (206) 622-8130

Drawing Title: MEMORIAL WALL DETAILS

Approved: Project Director

Project Title: TAHOMA NATIONAL CEMETERY
PHASE 2 GRAVESITE DEVELOPMENT
19600 SE 240TH STREET, KENT WASHINGTON

Location: KENT, WASHINGTON

Project Number: 919PC2007

Drawing Reference Number: 147

Drawing Number: L10.03

Date: 9-15-2011 | Checked: CQ/PE | Drawn: JS/JM

Office of Construction and Facilities Management
Department of Veterans Affairs

VA FORM 08-6231

Nov 10, 2011 - 8:43pm jbenoit
N:\va-tkw\projects\V0277\V0511\admin\Const Admin\CA01\Tahoma NC const record set\Sheet\V0277-055-BEIL.dwg
Image Width = 1.000" Image Height = 1.000" Image Units = Inches
one eighth inch = one foot | one quarter inch = one foot | three eighths inch = one foot | one half inch = one foot | three quarters inch = one foot | one inch = one foot | one and one half inches = one foot | three inches = one foot