


1
2
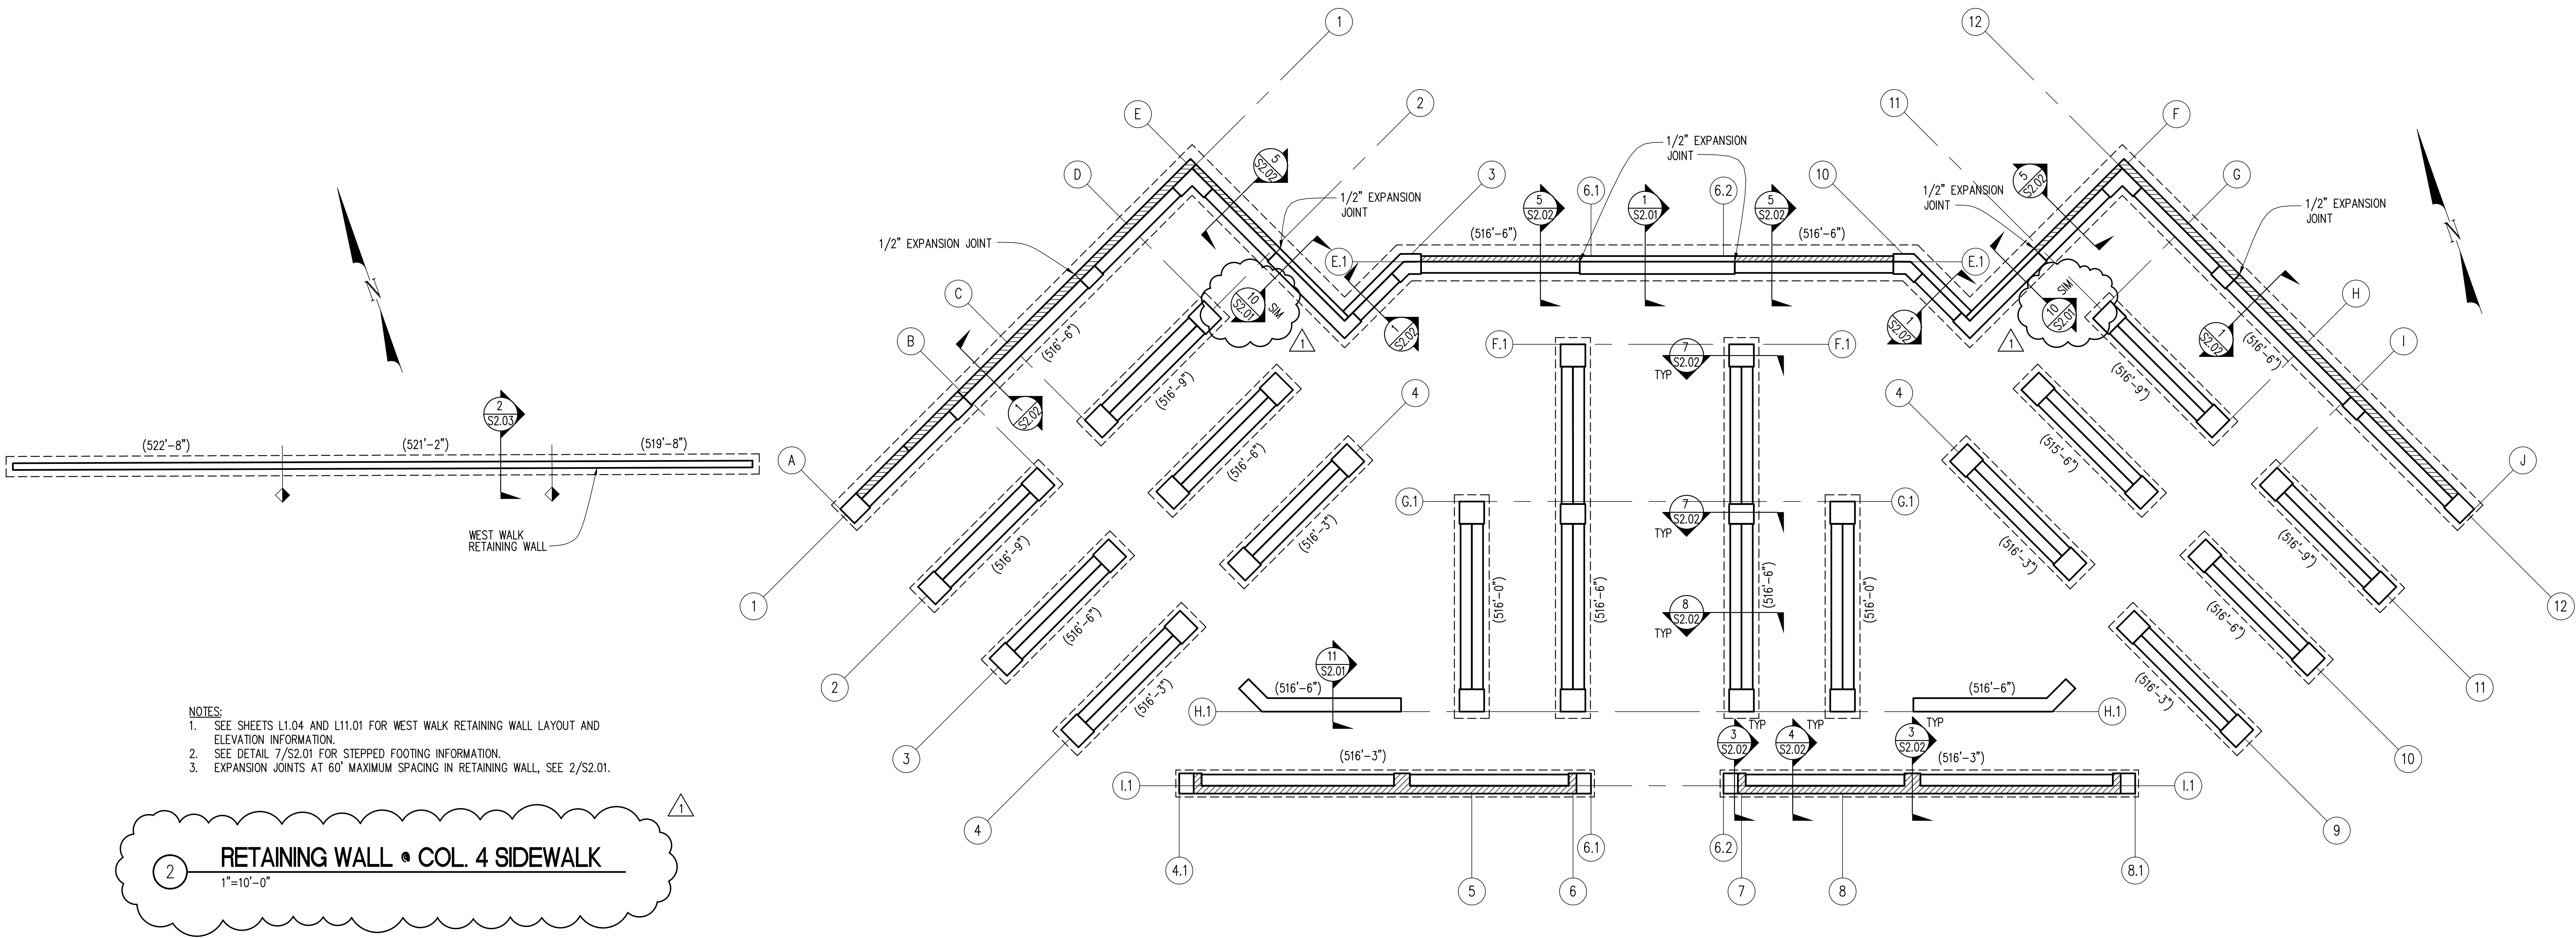

- NOTES:
1. SEE SHEETS L1.04 AND L11.01 FOR WEST WALK RETAINING WALL LAYOUT AND ELEVATION INFORMATION.
 2. SEE DETAIL 7/S2.01 FOR STEPPED FOOTING INFORMATION.
 3. EXPANSION JOINTS AT 60' MAXIMUM SPACING IN RETAINING WALL, SEE 2/S2.01.

RETAINING WALL • COL. 4 SIDEWALK
1"=10'-0"

COLUMBARIUM #4 PLAN
1"=10'-0"

- NOTES:
1. SEE SHEET L6.01 FOR COLUMBARIUM #4 LAYOUT INFORMATION.
 2. SEE SHEET L6.02 FOR COLUMBARIUM #4 GRADING INFORMATION.
 3. SEE L6.08-L6.09 FOR COLUMBARIUM #4 FOUNDATION LAYOUT PLAN, TOP OF STEW WALL AND TOP OF MASONRY LEDGE ELEVATIONS.
 4. VENEER SHELVES NOT ALL SHOWN IN PLAN. REVIEW AND COORDINATE ALL VENEER SHELVES WITH STRUCTURAL SECTIONS AND LANDSCAPE DRAWINGS.
 5. SEE SHEET S2.01 FOR TYPICAL FOOTING SECTIONS.
 6. SEE 2/S2.01 FOR EXPANSION JOINT DETAIL.

CONSULTANTS:		ARCHITECT/ENGINEERS:		Drawing Title		Project Title		Project Number		Office of Construction and Facilities Management	
Anderson Engineering of Minnesota, LLC		kpff Consulting Engineers		COLUMBARIUM #4 ENLARGED PLANS		TAHOMA NATIONAL CEMETERY PHASE 2 GRAVESITE DEVELOPMENT		919PC2007		Department of Veterans Affairs	
Aqua Engineering, Inc.		1601 Fifth Avenue, Suite 1600 Seattle, Washington 98101-3665 (206) 622-5822 Fax (206) 622-8130		Approved Project Director		18600 SE 240TH STREET, KENT WASHINGTON		Drawing Reference Number		166	
JJR		ALLEGIANCE GROUP, LLC		Location		KENT, WASHINGTON		Drawing Number		S1.04	
RUSHING		BLACKBIRD		Date		9-15-2011		Checked		JCM	
AMENDMENT 4		11/11/2011		Drawn		BLE					